
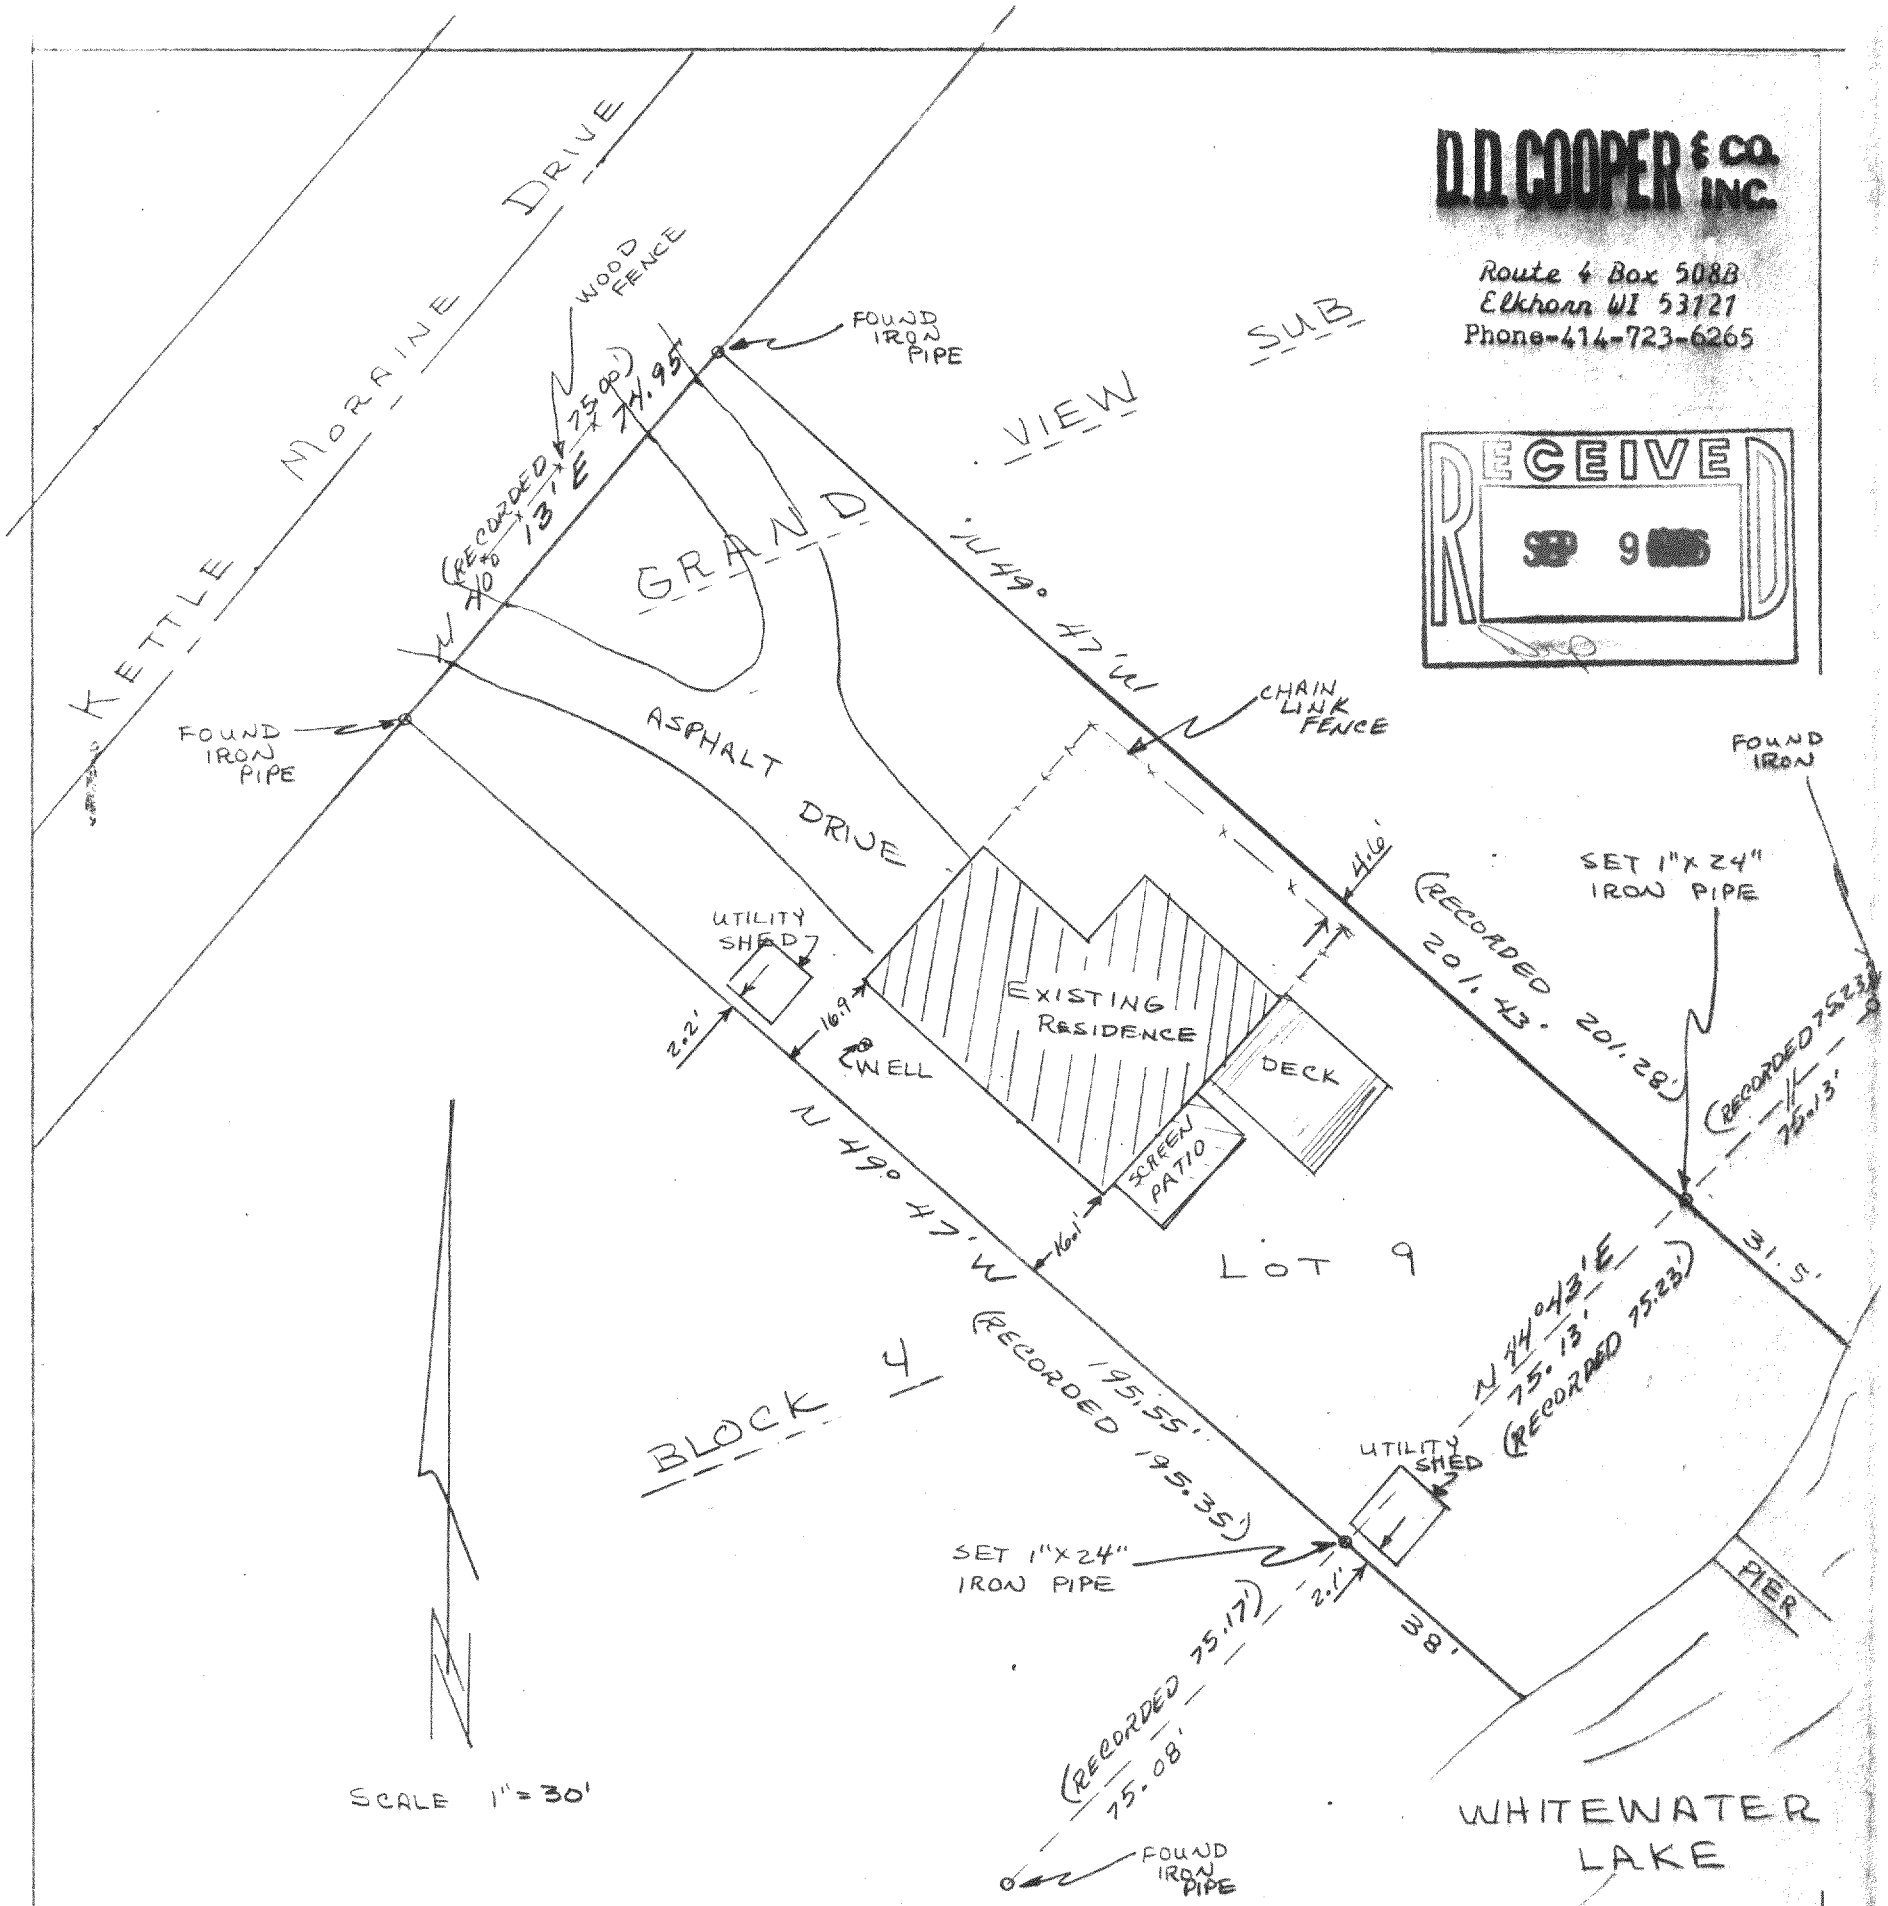


D.D. COOPER & CO. INC.

Route 4 Box 508B
Elkhorn WI 53121
Phone-414-723-6265

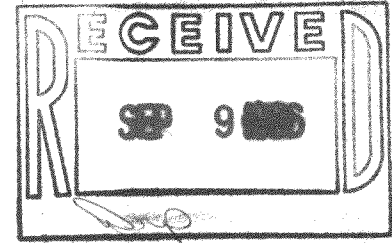

SCALE 1" = 30'

Plat of survey of lot 9 Block 4 Grand View Subdivision
being in the Town of Whitewater Walworth County Wisconsin

Survey ordered by Century 21 - Whitewater


Bearing reference: Westerly line
of parcel assumed to bear N49° 47' W

I, Daniel D. Cooper, Registered Land Surveyor do hereby certify that
I have surveyed the property described hereon and that the map shown
hereon is a true and accurate representation thereof to the best of my
professional knowledge and belief.

Dated this 14TH day of July, 1986

Daniel D. Cooper

Daniel D. Cooper, RLS NO. S-1464

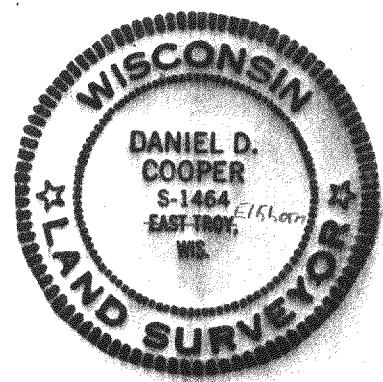

DRAWING NO 2264
-5-38

D6D-57

TAX NO. D6D 00057