


DESCRIPTION: Lot 29, Block 1, MORaine HEIGHTS, Northwest 1/4, Section 35, Town 4 North, Range 15 East, Town of Whitewater, Walworth Co., Wisconsin.

D.D. COOPER & CO. INC.


Route 4 Box 508B
Elkhorn WI 53121
Phone-414-723-6265

Bearing reference: Right-of-way line assumed
S 50 55' W as recorded

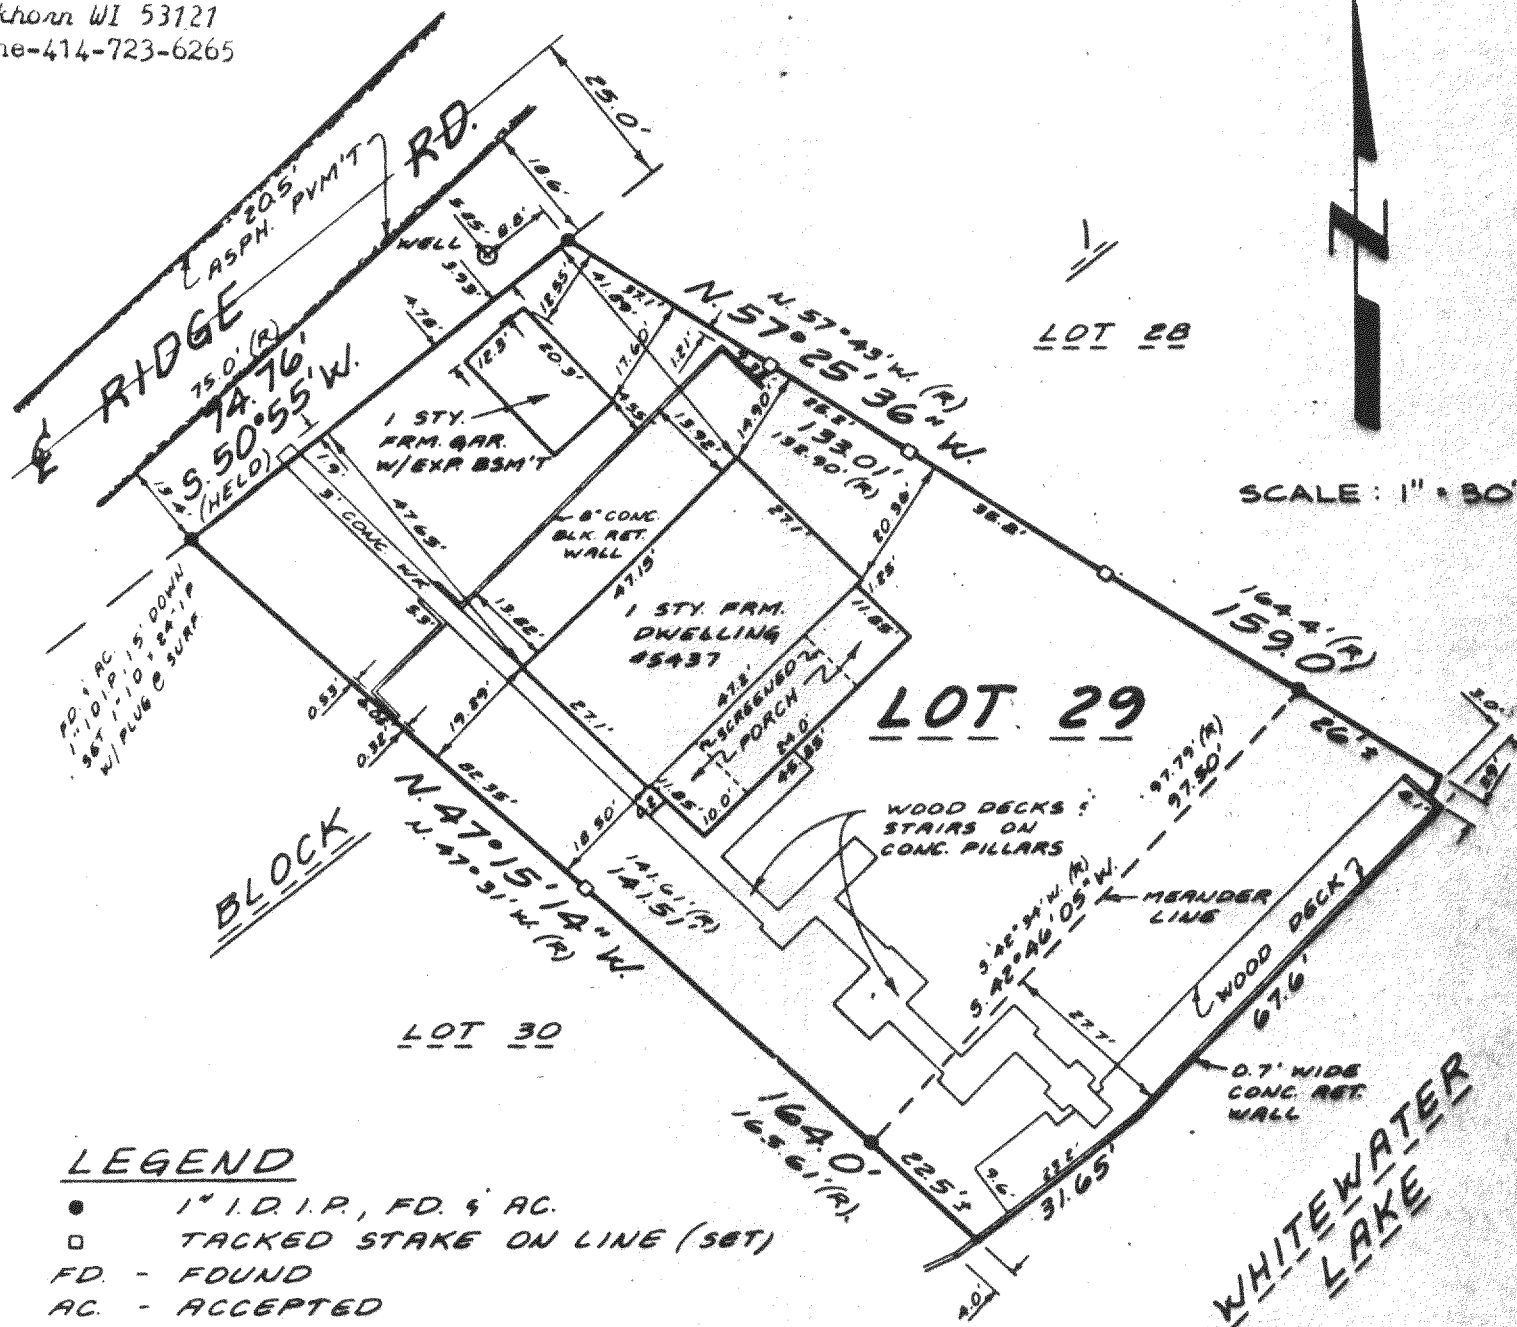

LEGEND

- 1" I.D. I.P., FD. & AC.
- TACKED STAKE ON LINE (SET)
- FD. - FOUND
- AC. - ACCEPTED
- PLUG - YELLOW PLASTIC PLUG STAMPED "R. A. SMITH, INC."
- (R) - RECORDED AS
- I.D. - INSIDE DIAMETER
- I.P. - IRON PIPE

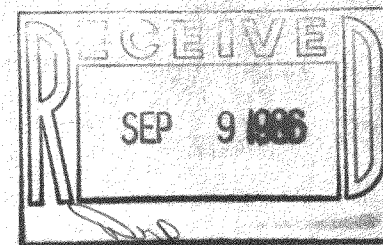


I hereby certify that I have resurveyed the above property as described hereon and that I find that the above map is a true and accurate representation thereof. That I have verified the location of structures as shown hereon and find them to be as indicated hereon. That the above map is a true and accurate representation of the property to the best of my professional knowledge and belief.

Dated this 1ST day of July, 1986

Daniel D. Cooper
Daniel D. Cooper, RLS No. S-1464

Survey ordered by Century-21
Whitewater

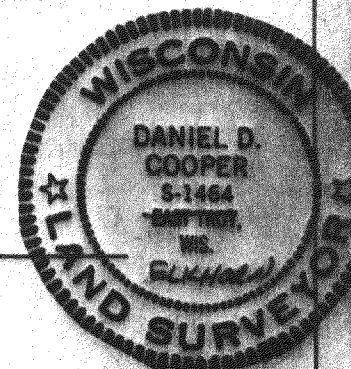

DRAWING NO. 2257

TAX NO. DMH 00029