

PLAT OF SURVEY OF THE NORTHEASTERLY LINE OF LOT 14, BLOCK 1 OF MINNIESKA SUBDIVISION
LOCATED IN THE N.E. $\frac{1}{4}$ OF SECTION 35, T4N, R15E, WALWORTH COUNTY, WISCONSIN




SURVEYED BY: JENSEN SURVEYING & MAPPING S.C.
P.O. Box 322- Elkhorn, WI. - 53121
(414) 723-3434

SURVEYED FOR: Richard L. Landwehr
413 N. Aldine St.
Elgin, Ill. 60120

I, Thomas P.A. Jensen, Wisconsin Registered Land Surveyor, do hereby certify that this survey was performed by me, or under my direction, in full compliance with the owners/agents instructions and Chapter AE-5 of the Wisconsin Administrative Code "Minimum Standards for Property Surveys"; and that this map is an accurate representation to the best of my knowledge and belief.

Thomas P.A. Jensen
Thomas P.A. Jensen R.L.S. 1084

DEC. 19, 1985

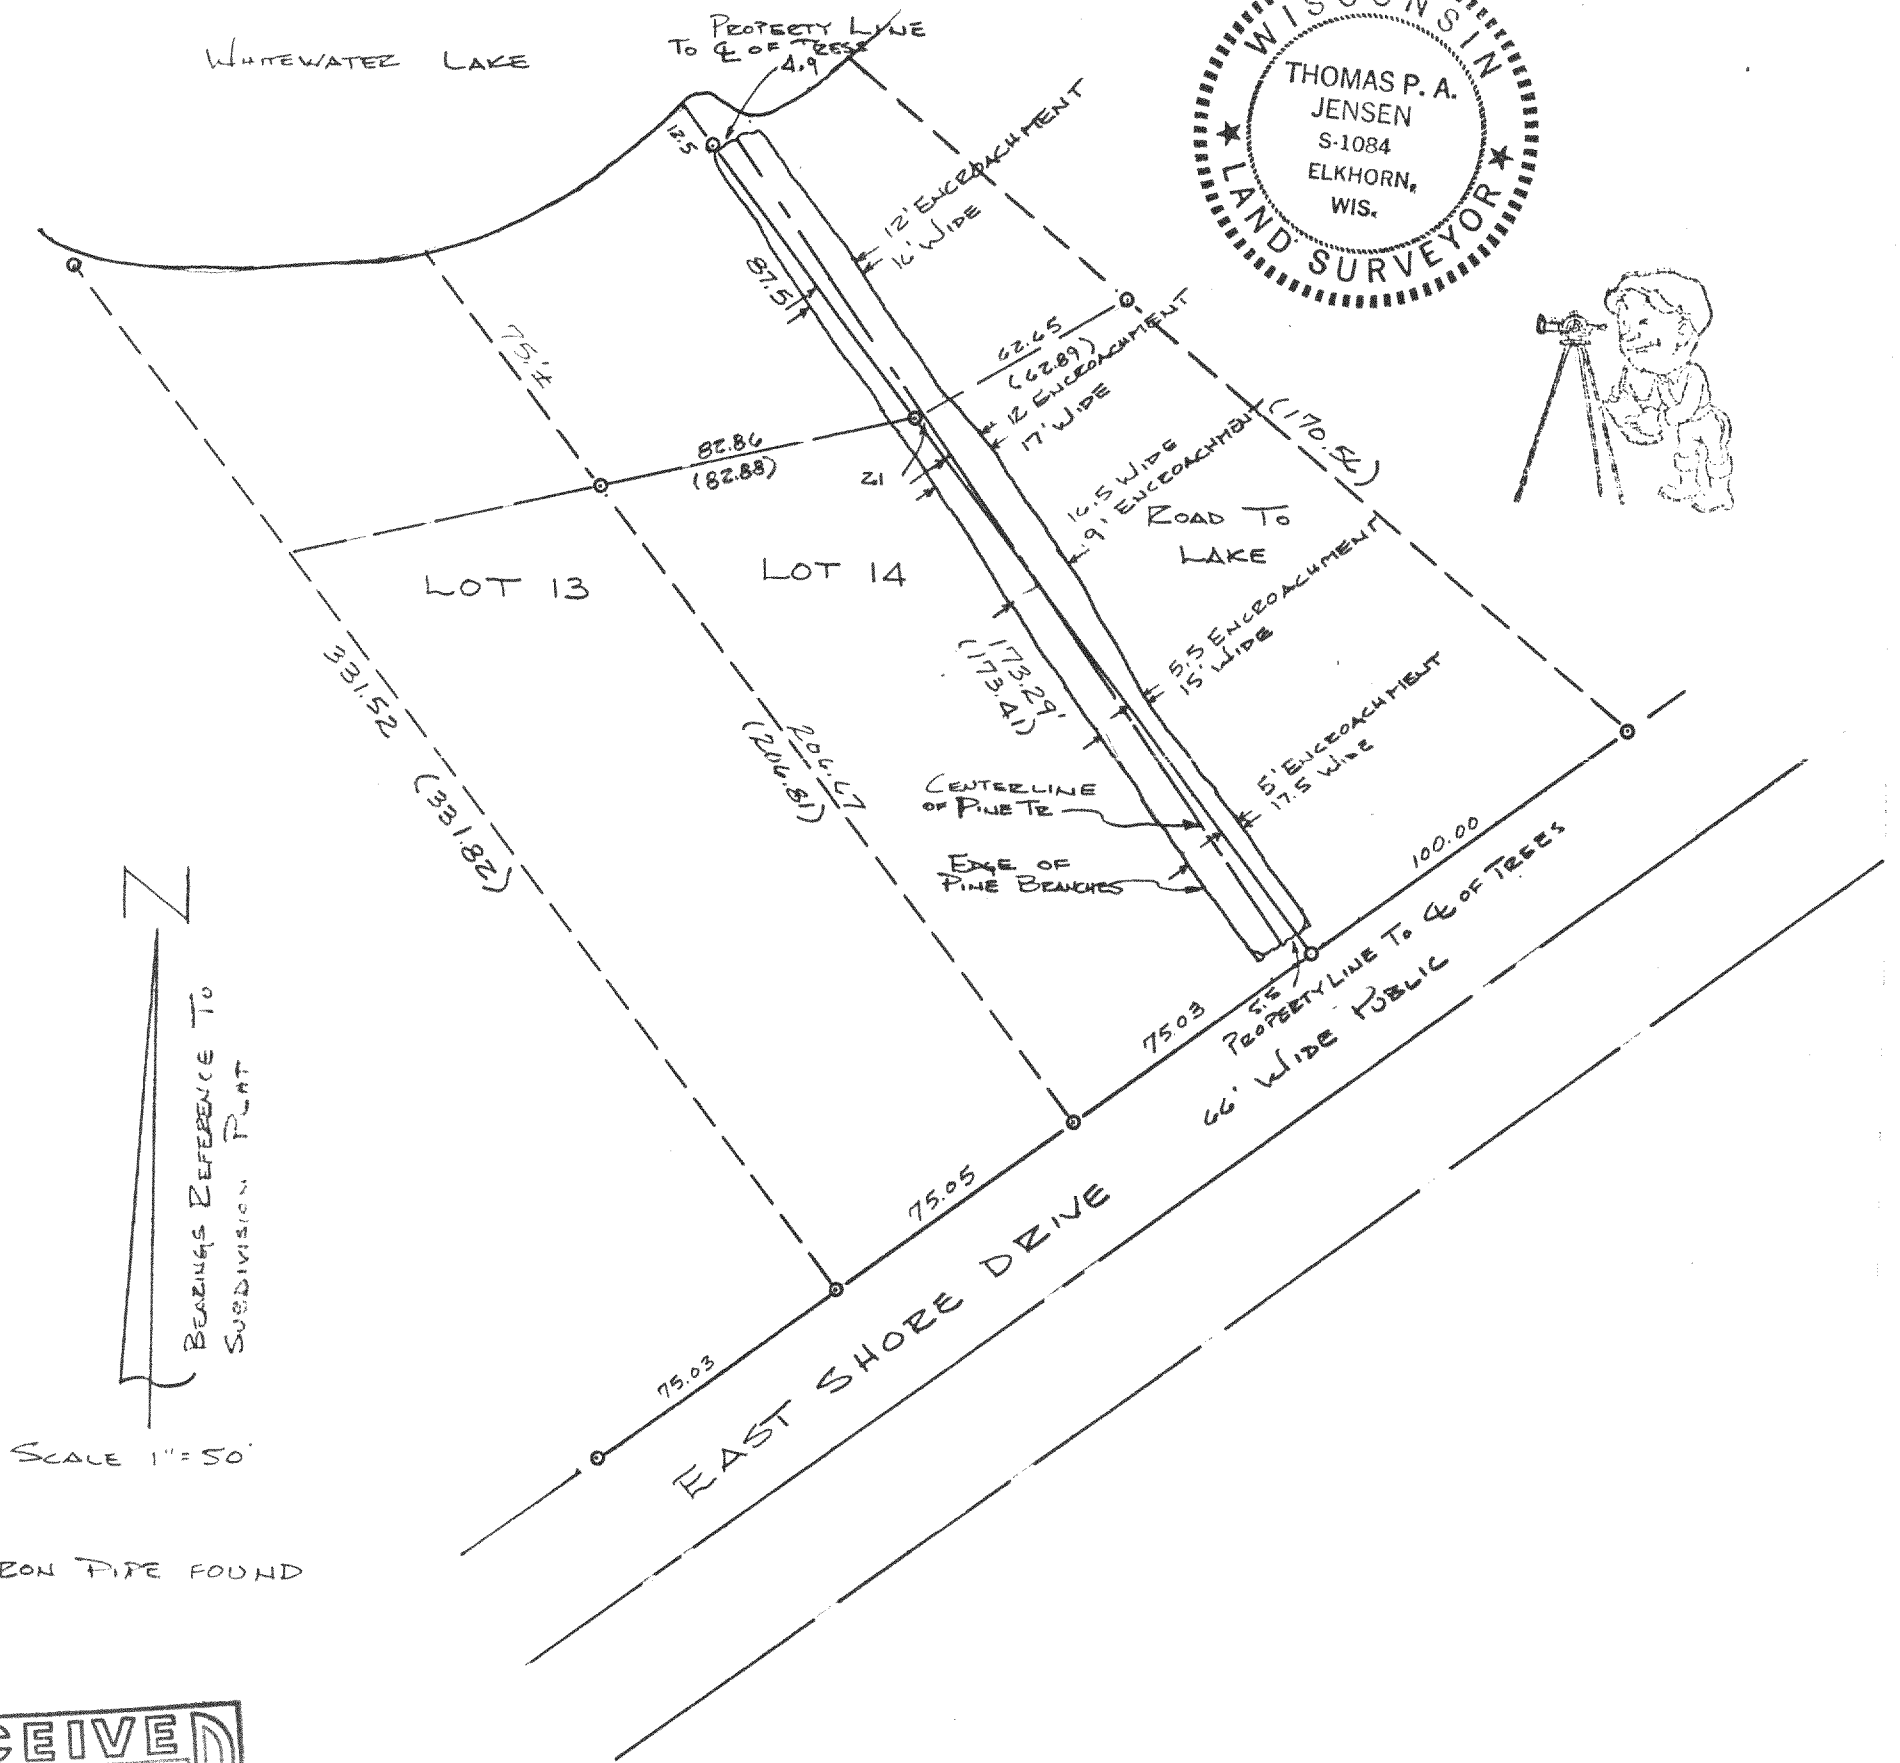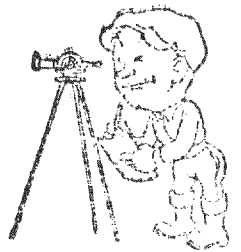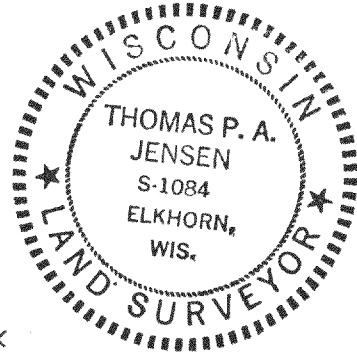

BEARINGS REFERENCE TO
SUBDIVISION PLAT

SCALE 1" = 50'

0 ~ IRON PIPE FOUND

