


Plat of Survey of Lot 34 Block 2 of Indian Trails Subdivision
Located in the Town of Whitewater, Walworth County Wisconsin

D.D. COOPER & CO. INC.

Route 4 Box 508B
Elkhorn WI 53121
Phone-414-723-6265

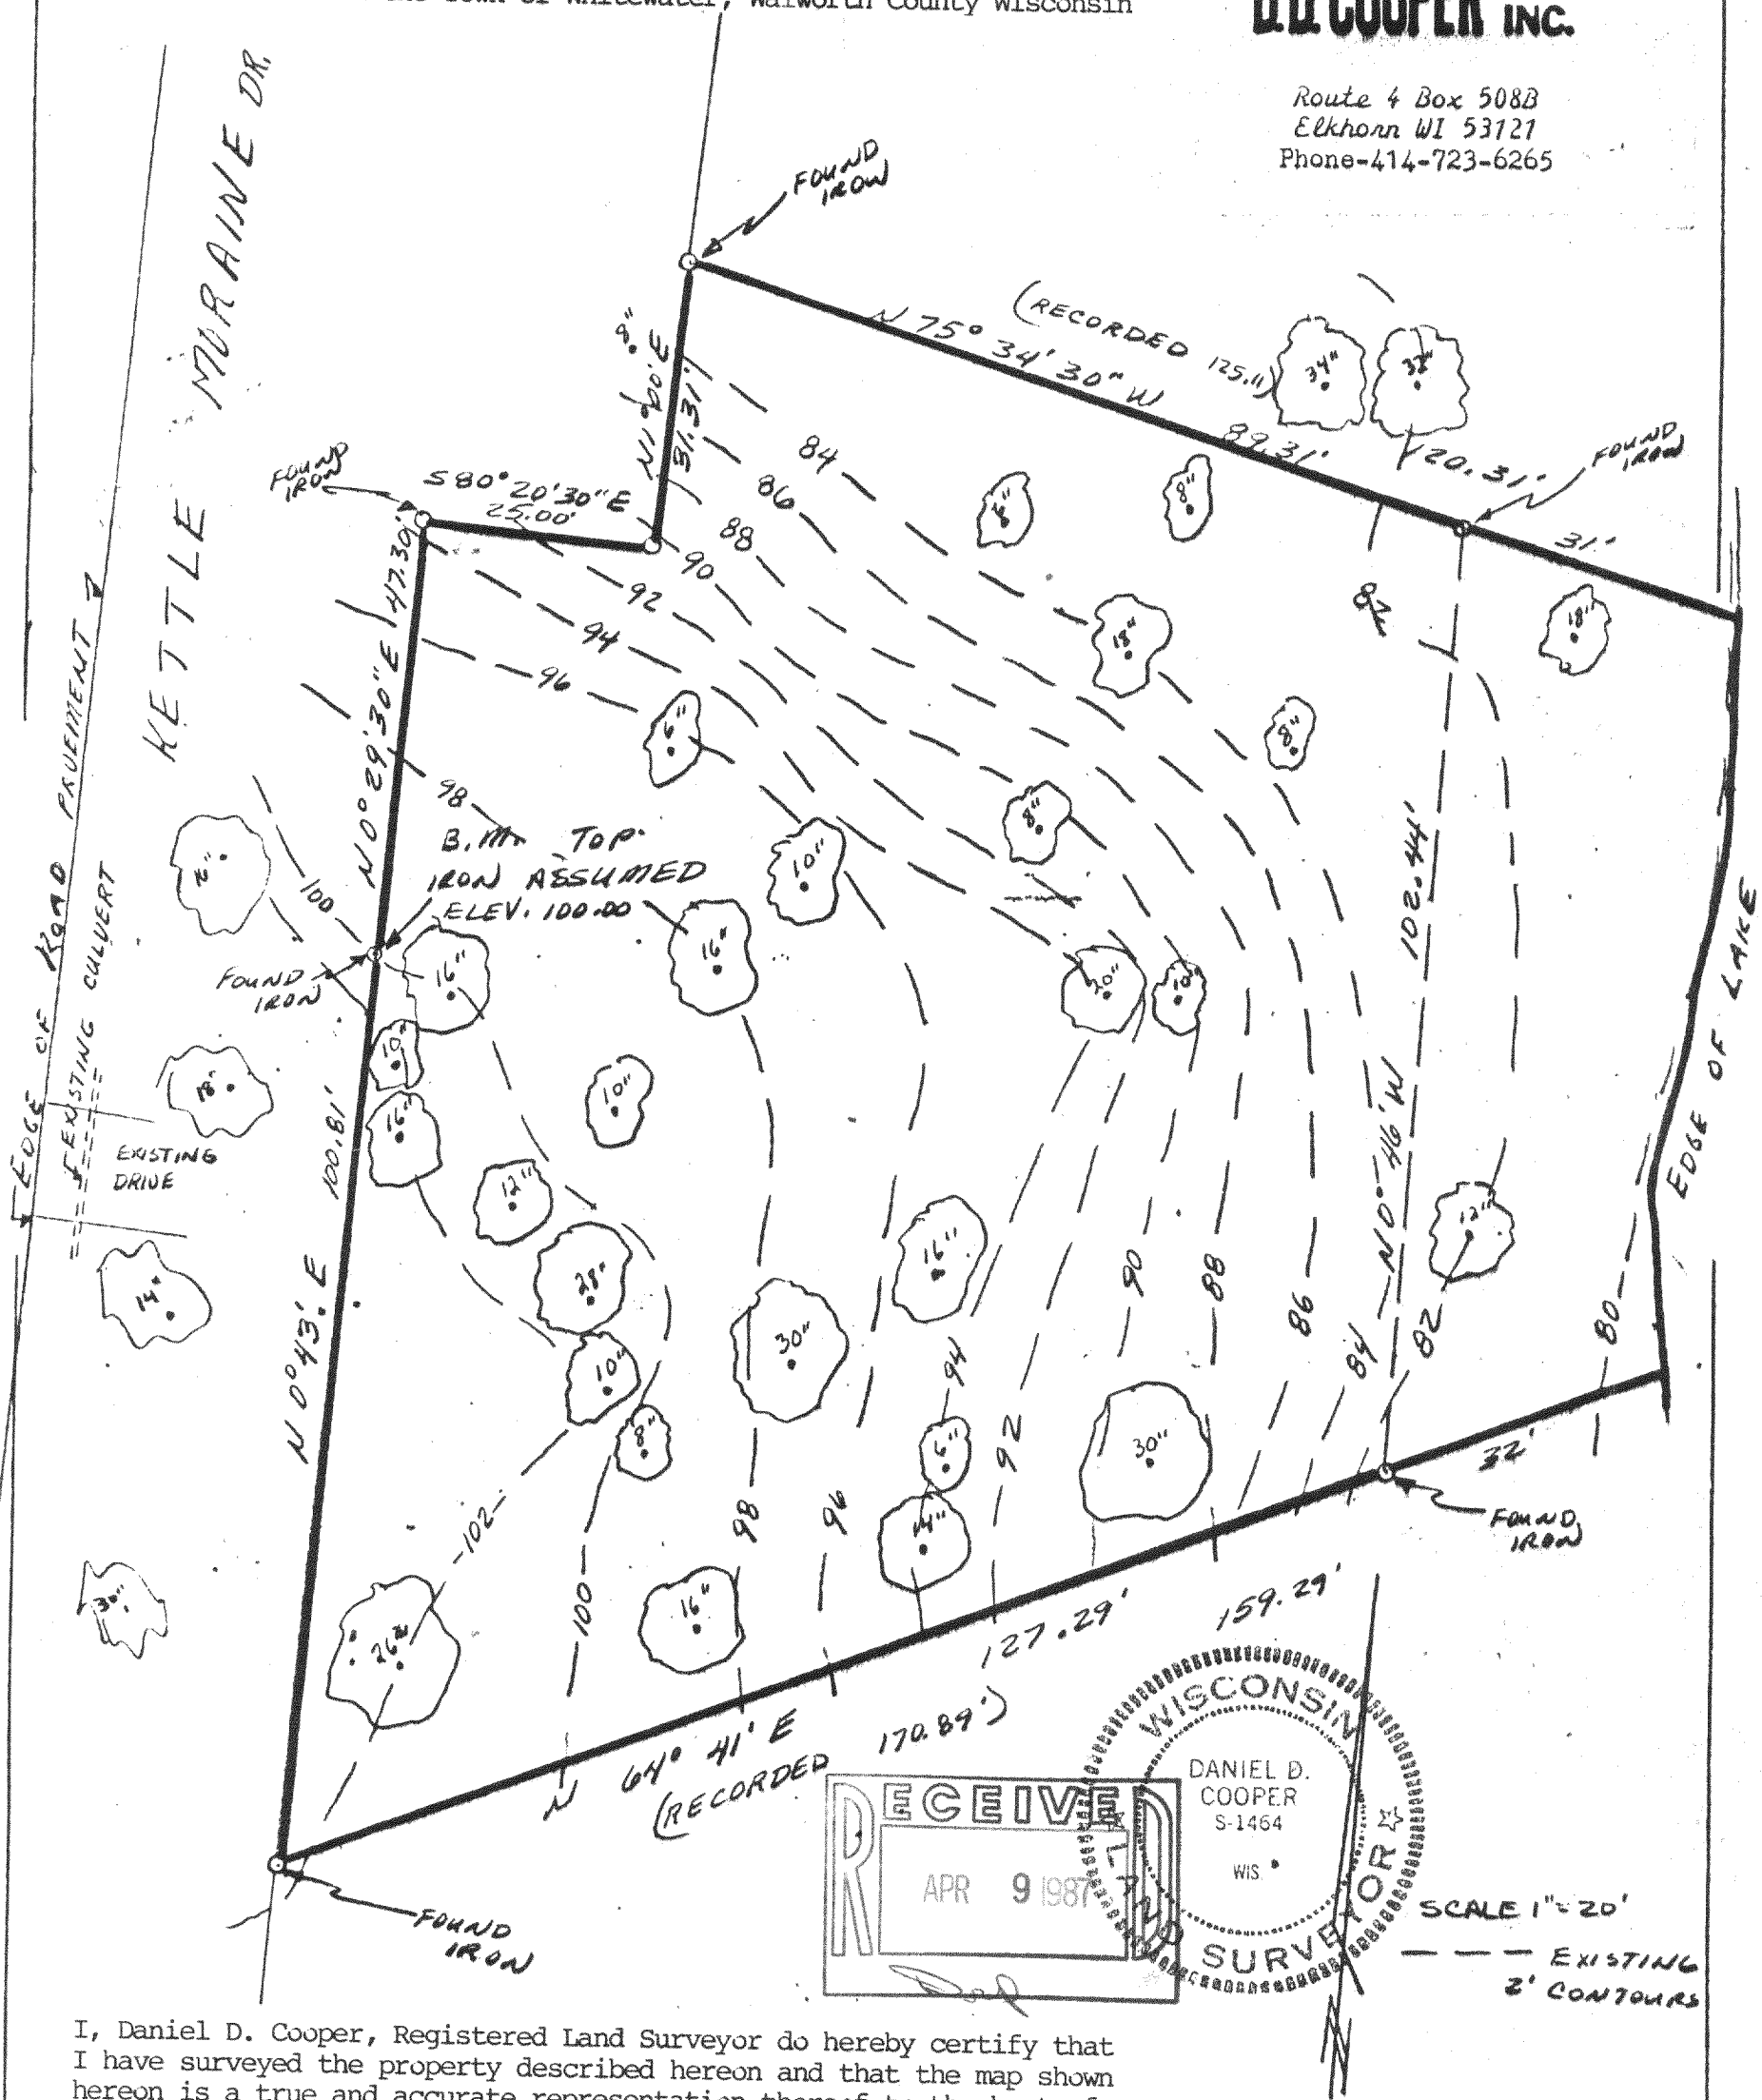

I, Daniel D. Cooper, Registered Land Surveyor do hereby certify that I have surveyed the property described hereon and that the map shown hereon is a true and accurate representation thereof to the best of my professional knowledge and belief.

Dated this 14TH day of Jan 1987

Daniel D. Cooper
Daniel D. Cooper, RLS NO. S-1464

Survey ordered by Century 21
Whitewater WI

DITS-58

Bearing Reference: Easterly line of Kettle Moraine Dr.
assumed to bear N 0 43' E

DRAWING D. 3043

415-266