
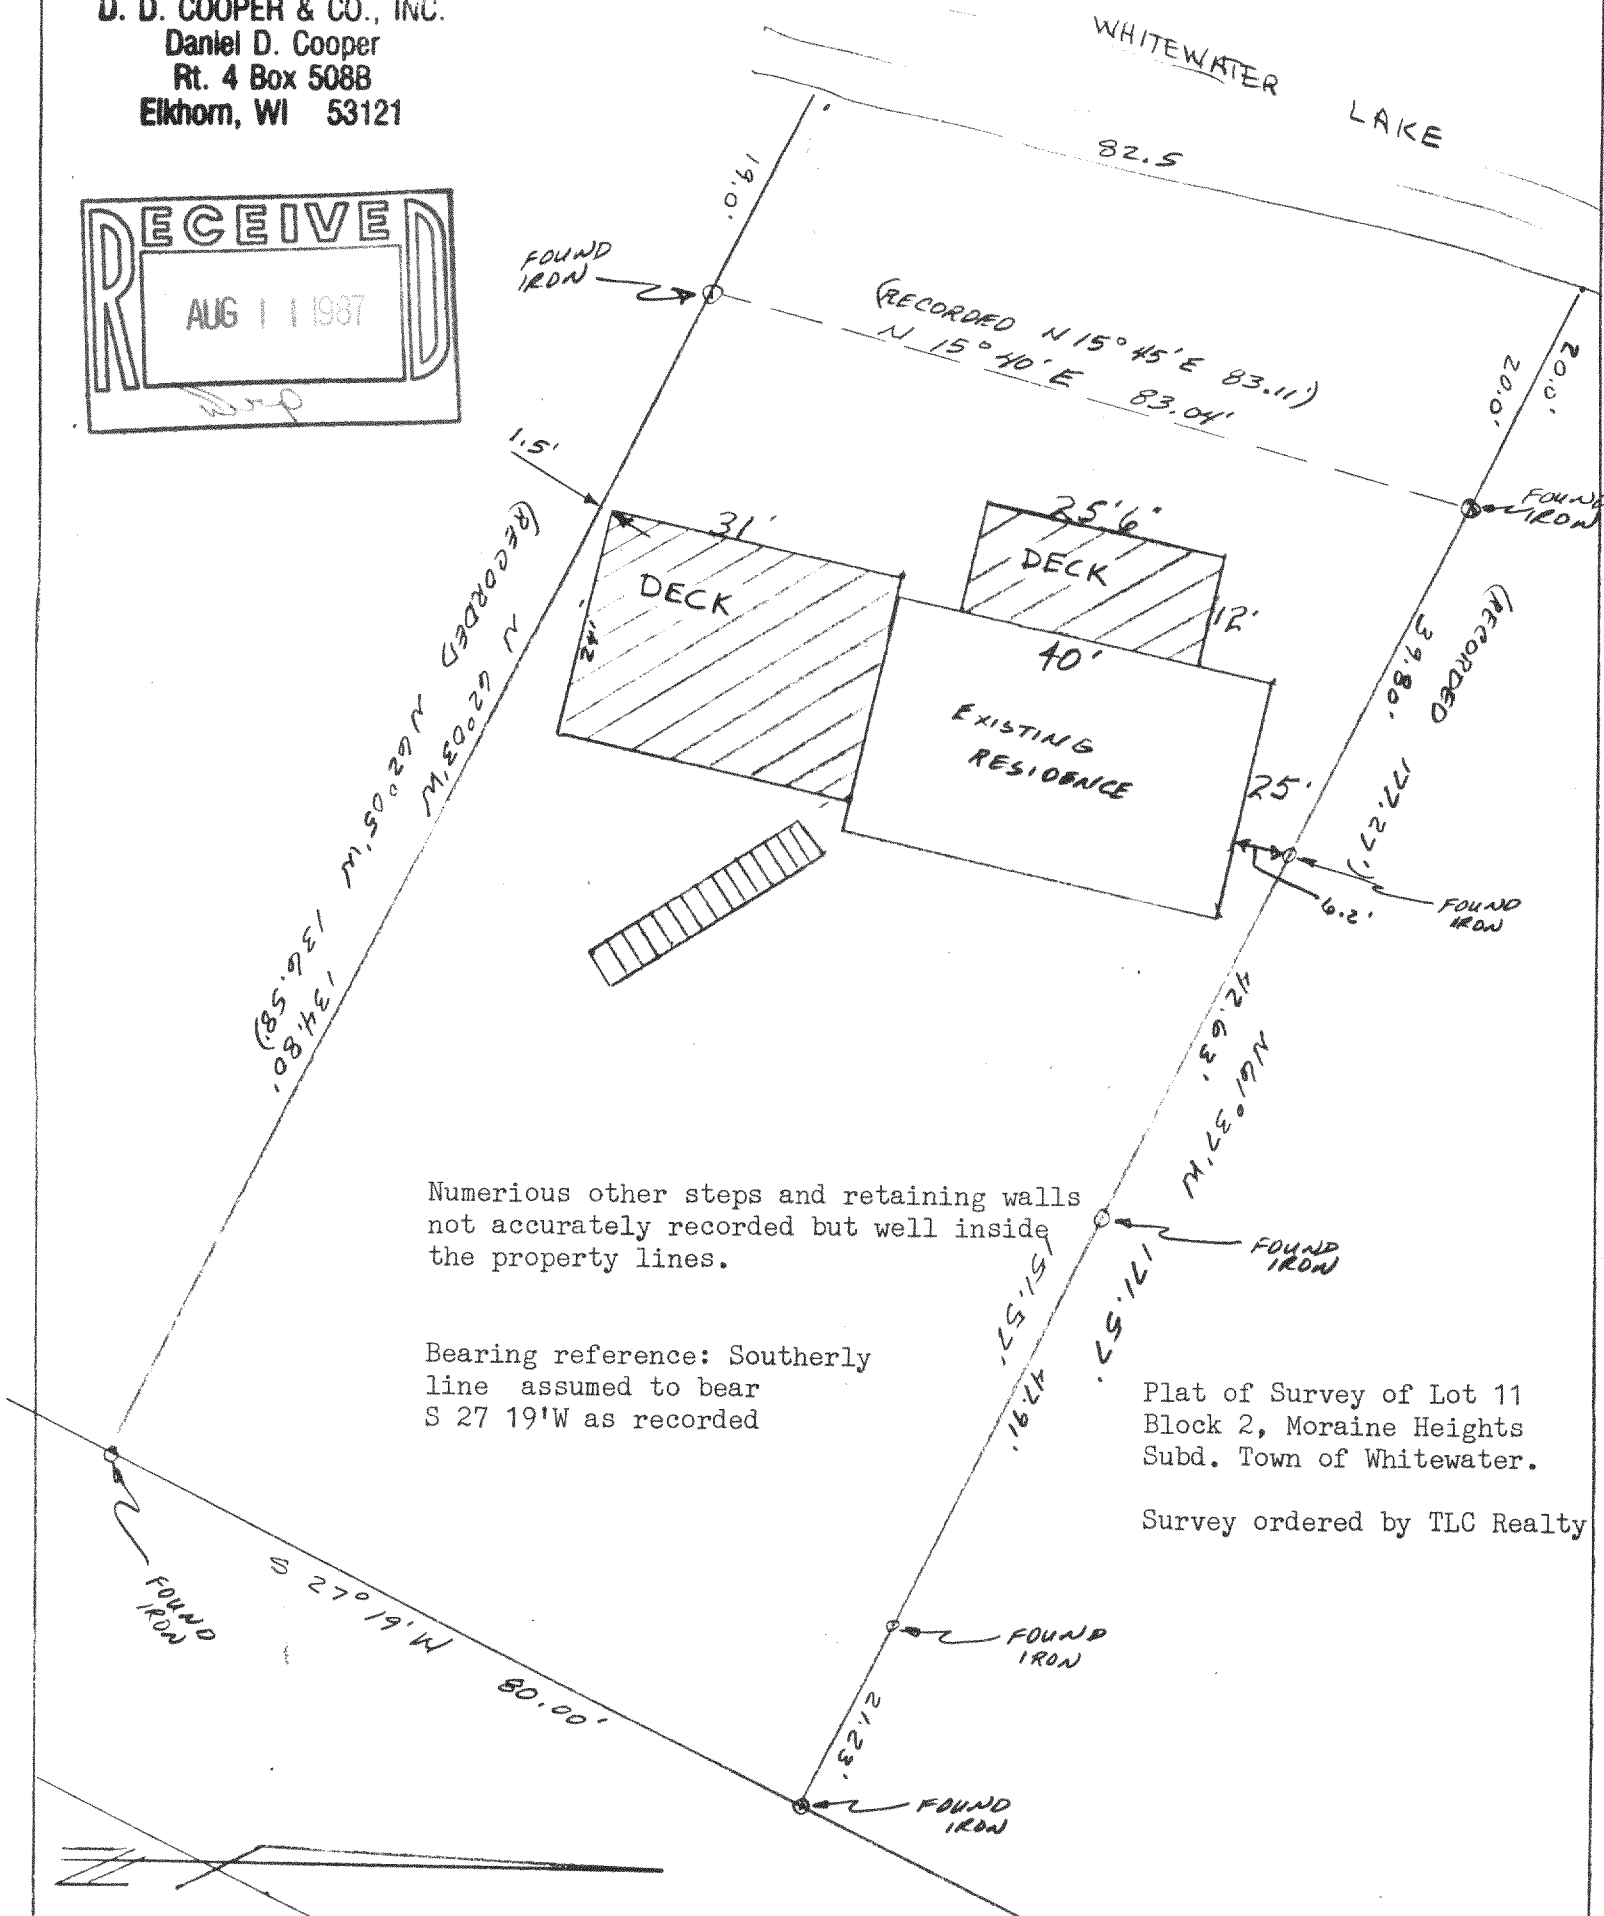


D. D. COOPER & CO., INC.
 Daniel D. Cooper
 Rt. 4 Box 508B
 Elkhorn, WI 53121

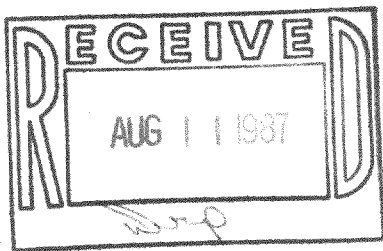

Numerous other steps and retaining walls not accurately recorded but well inside the property lines.


Bearing reference: Southerly line assumed to bear S 27 19'W as recorded

Plat of Survey of Lot 11
 Block 2, Moraine Heights
 Subd. Town of Whitewater.

Survey ordered by TLC Realty

I hereby certify that I have surveyed the property described hereon and that the above is a true and accurate representation thereof to the best of my professional knowledge and belief.

Dated this 21 day of July 1987

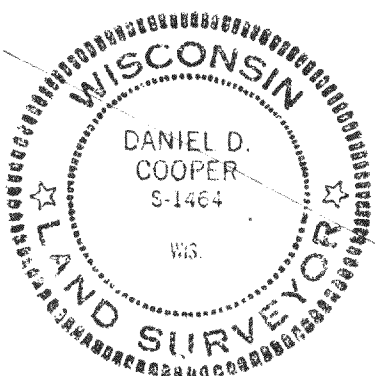

Daniel D. Cooper
 Daniel D. Cooper, RLS No. S-1464