
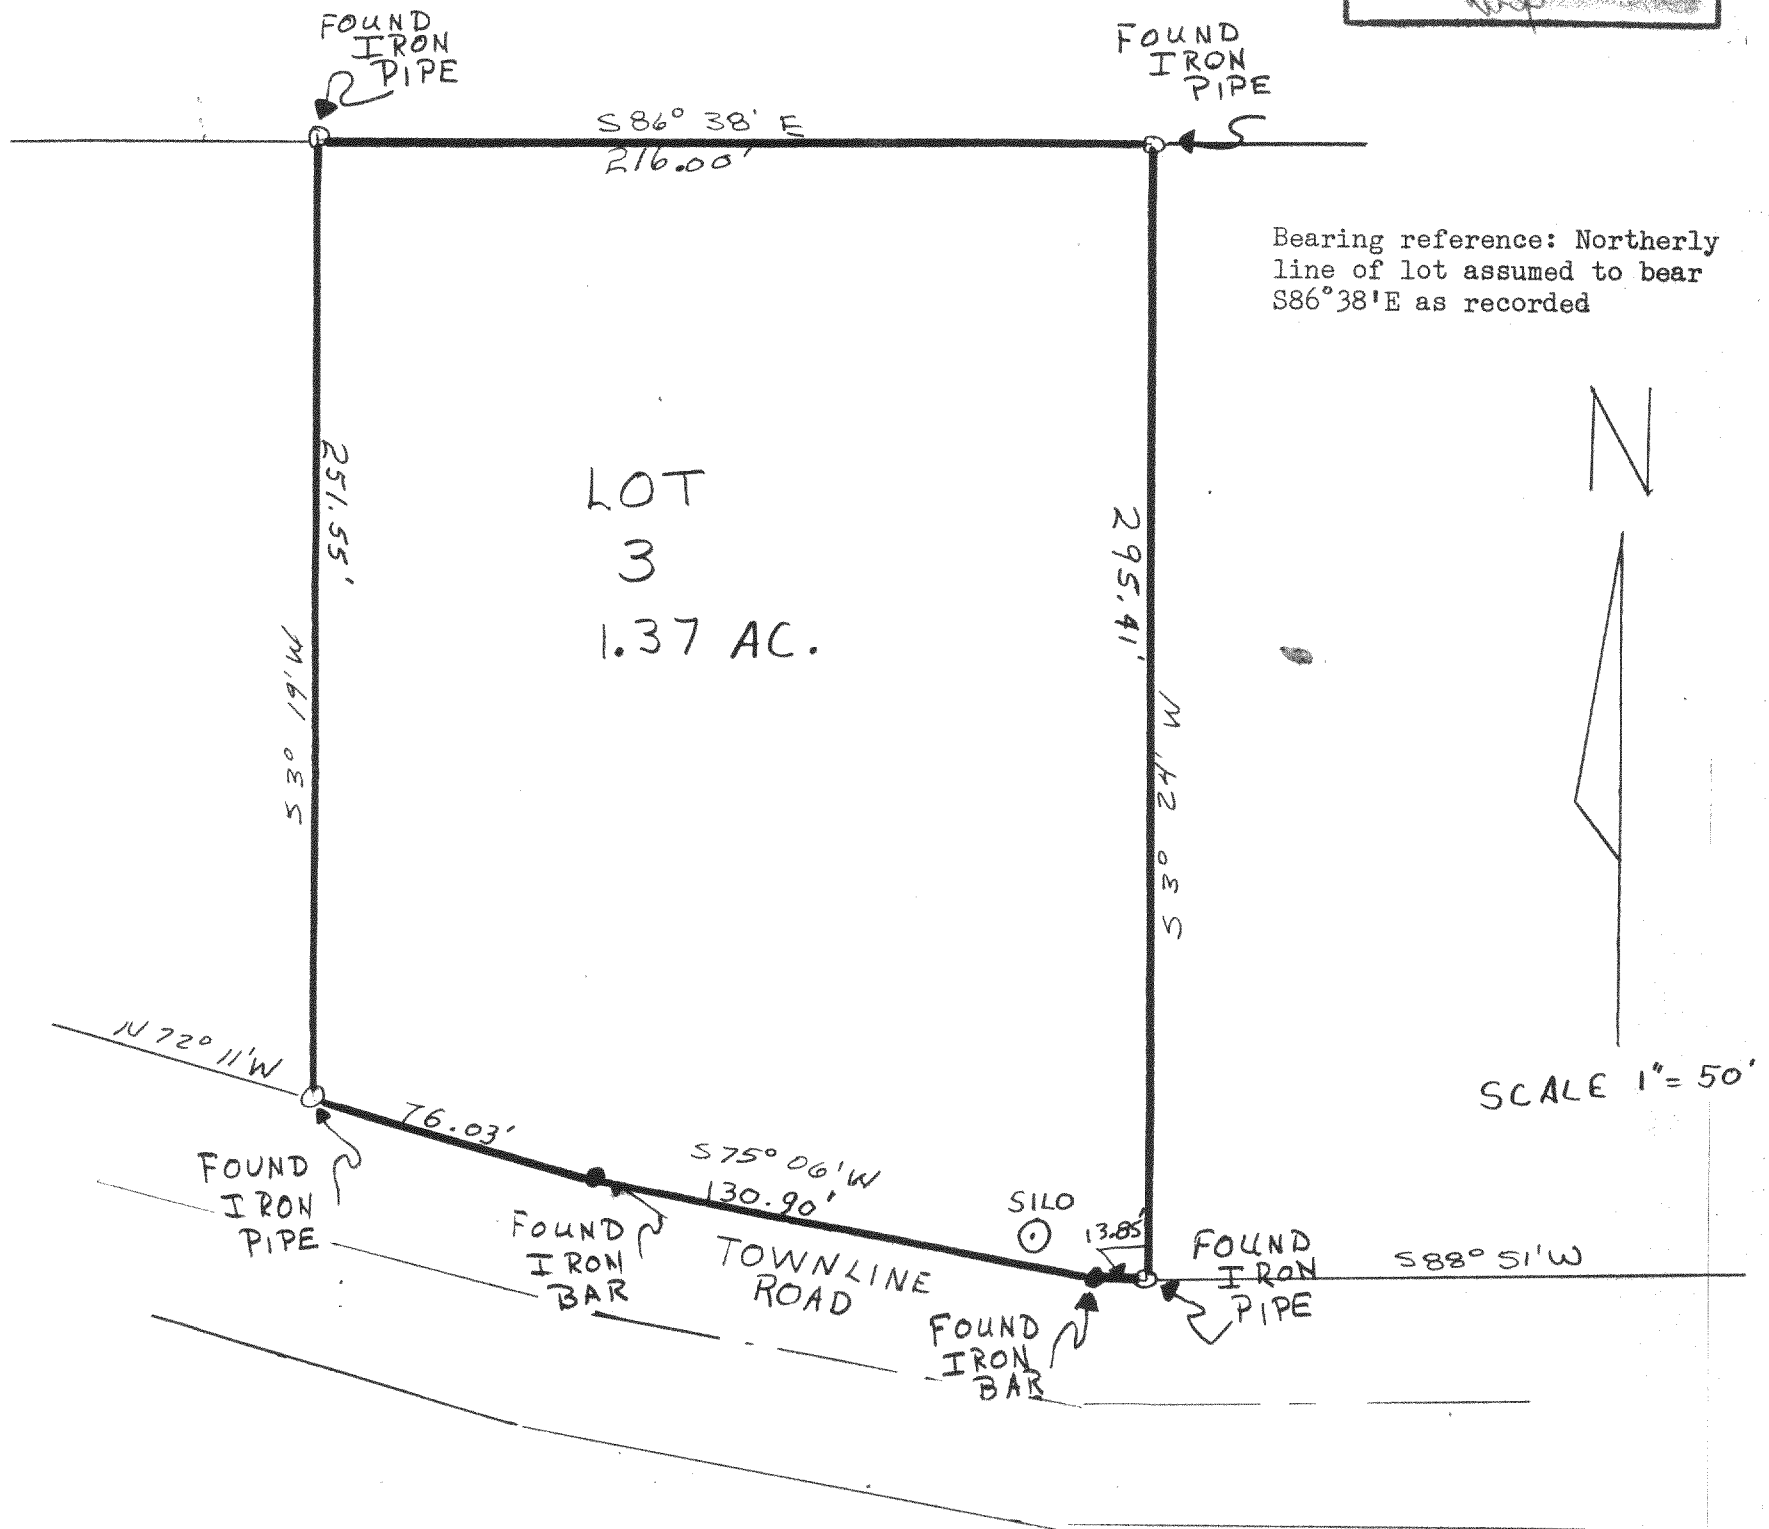


Plat of Survey of Lot No. 3 of Certified Survey Map No. 495.

D. D. COOPER & CO., INC.
Daniel D. Cooper
Rt. 4 Box 508B
Elkhorn, WI 53121

Surveyed for Rummel-Devitt and Assoc..

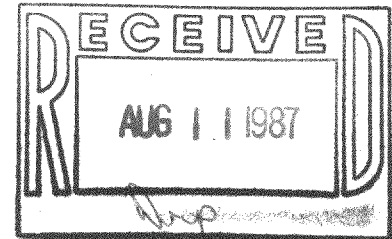

I hereby certify that I have surveyed the property described hereon and that the above is a true and accurate representation thereof to the best of my professional knowledge and behalf.

Dated this 10 day of July 1987

Daniel D. Cooper

Daniel D. Cooper, RLS No. S-1464

