



Plat of Survey of Lot 21 and North 1/2
of Lot 22 Block 1 Indian Trail Subdivision,
Walworth County, Wisconsin.

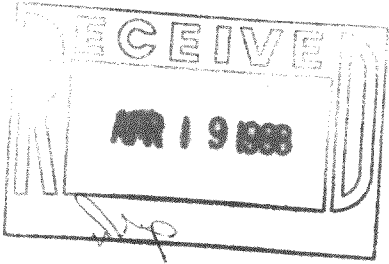

Survey ordered by - Rummel Devitt

O - INDICATES IRON FOUND

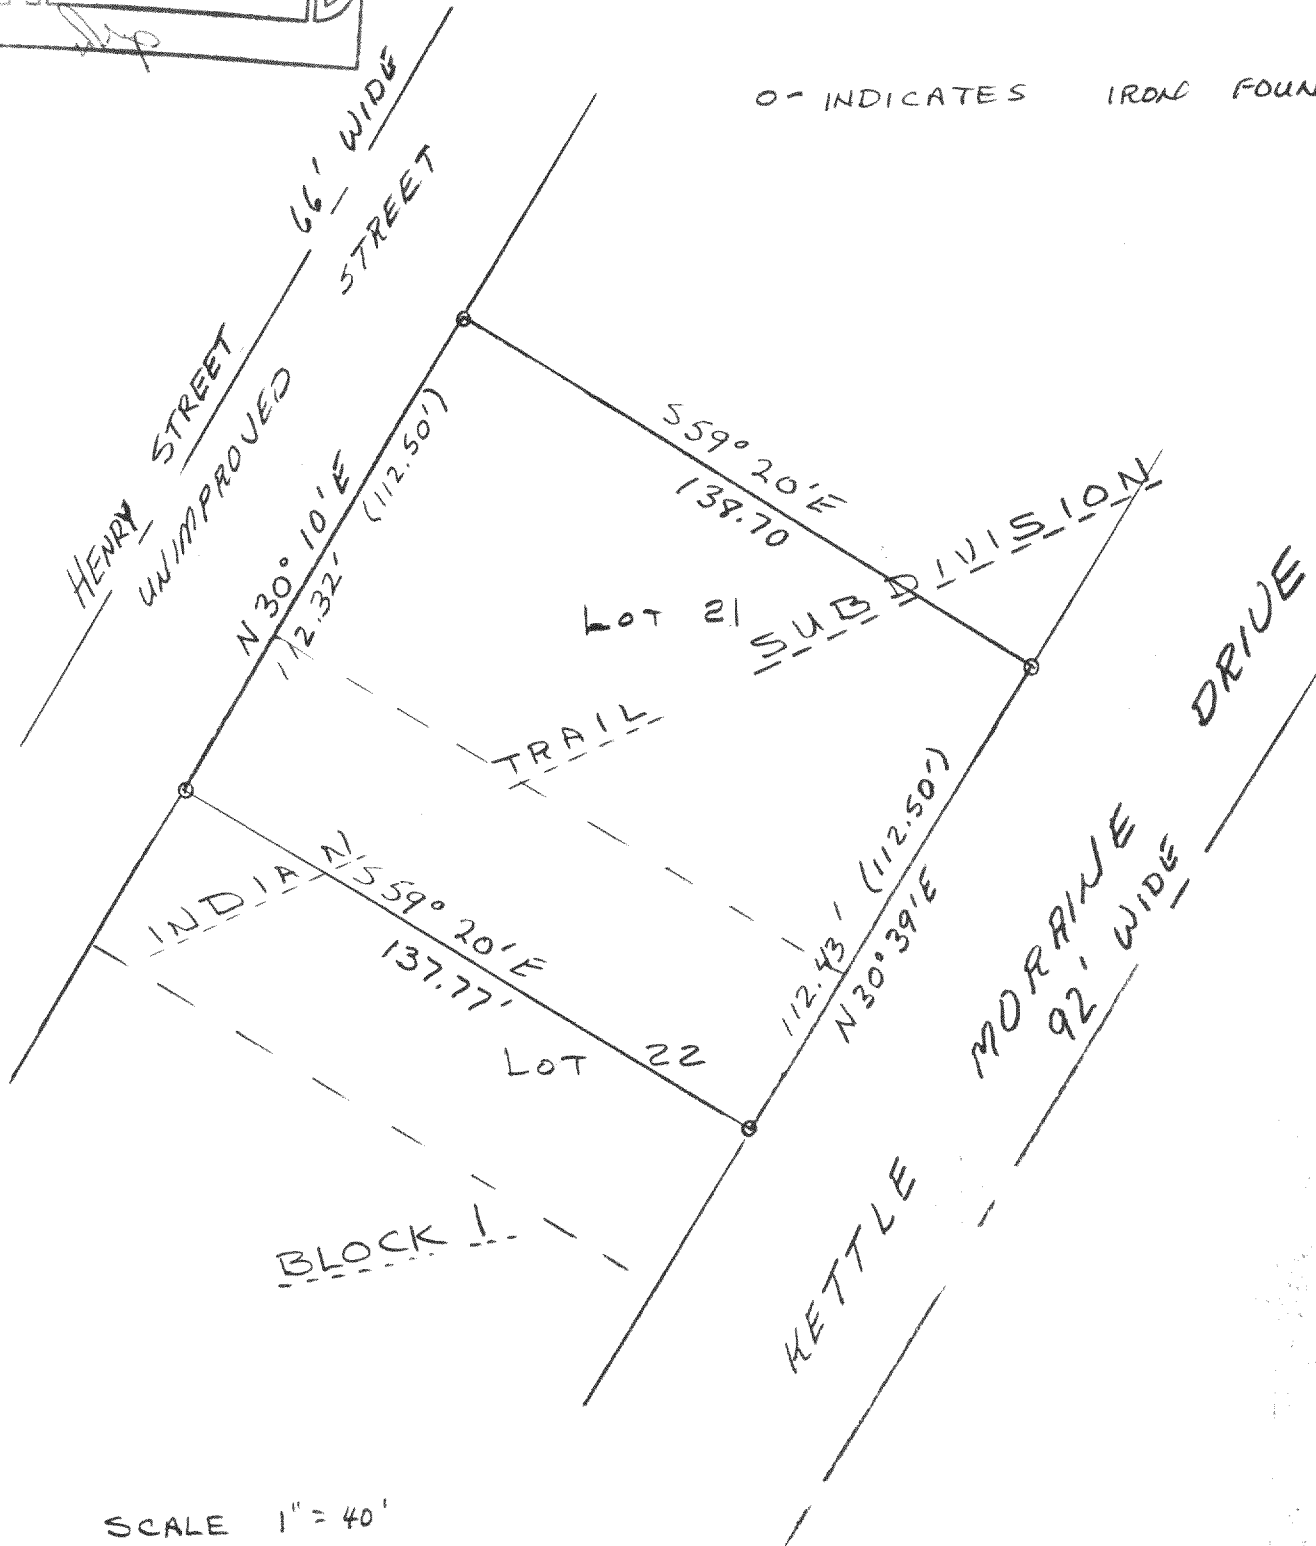


BEARINGS REFERENCED TO ORIGINAL SUBDIVISION PLAT

I hereby certify that I have surveyed the
property described hereon and that the
map shown hereon is a true and accurate
representation thereof to the best of my
professional knowledge and belief.

Dated this 14 day of Mar., 1988

Daniel D. Cooper
Daniel D. Cooper, RLS No. S-1464

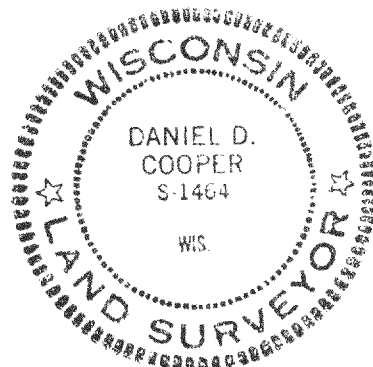

DRAWING NO. 3190

415-285