
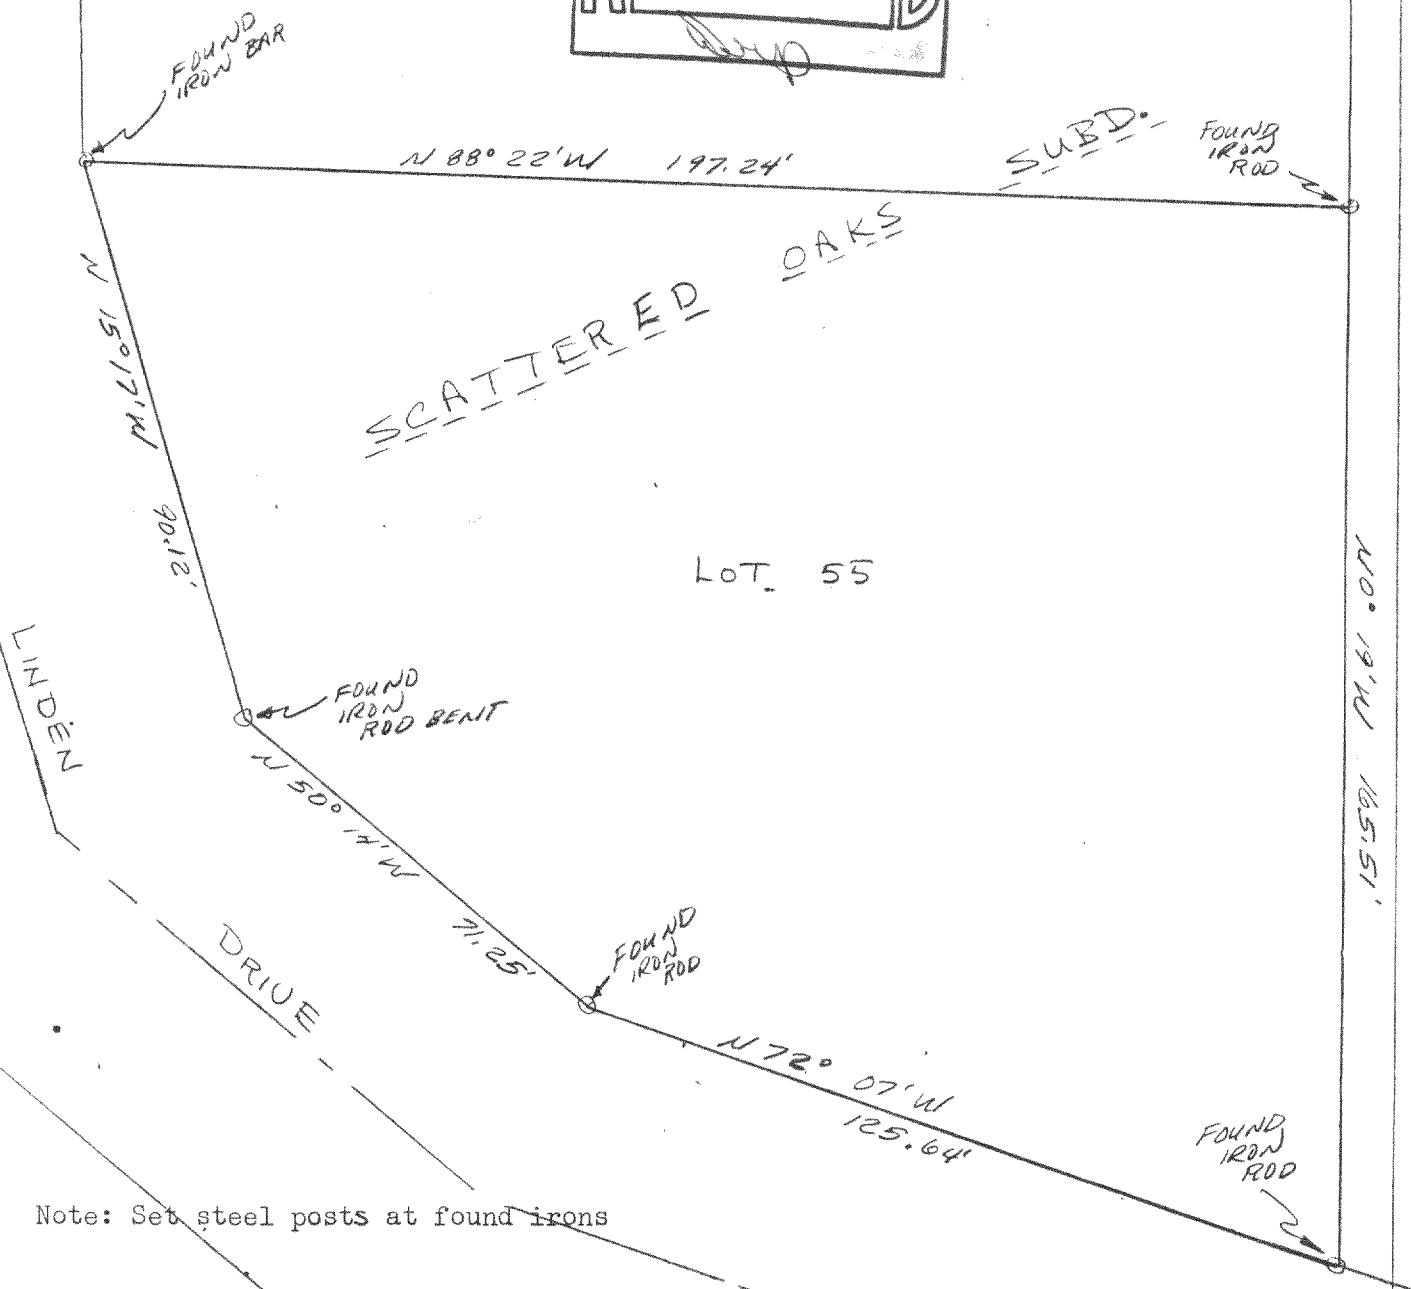


D.D. COOPER & CO. INC.

Route 4 Box 508B
Elkhorn WI 53121
Phone-414-723-6265

Plat of Survey of Lot 55 of Scattered Oaks
Subdivision being located in Town 4 North,
Range 15 East, Walworth County WI.

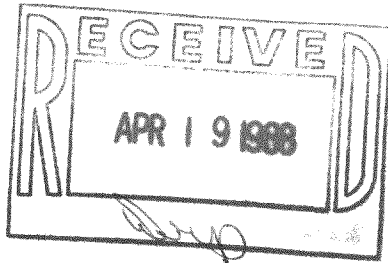

Note: Set steel posts at found irons


Survey ordered by Rummel-Devitt & Assoc.
Whitewater WI

Bearing Reference: Easterly line of parcel assumed to
bear N 0 19' W as previously recorded

I hereby certify that I have surveyed the property described hereon
and that the above map is a true and accurate representation
thereof to the best of my professional and belief.

Dated this 22 day of MAY 1987

Daniel D. Cooper
Daniel D. Cooper, RLS No. S-1464

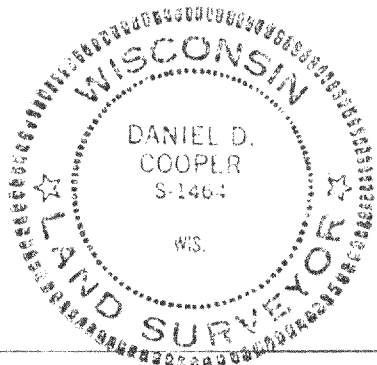

SCALE 1" = 30'

DRAWING No. 3093

415-287