
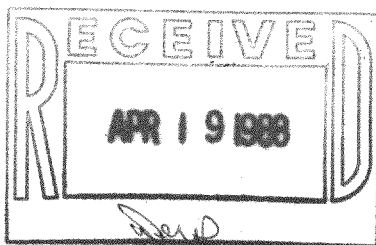


Survey ordered by Century 21-Whitewater

Plat of survey of Lots 3 & 4
Block 5, Moraine Park Subdivision,
Walworth County, Wisconsin.

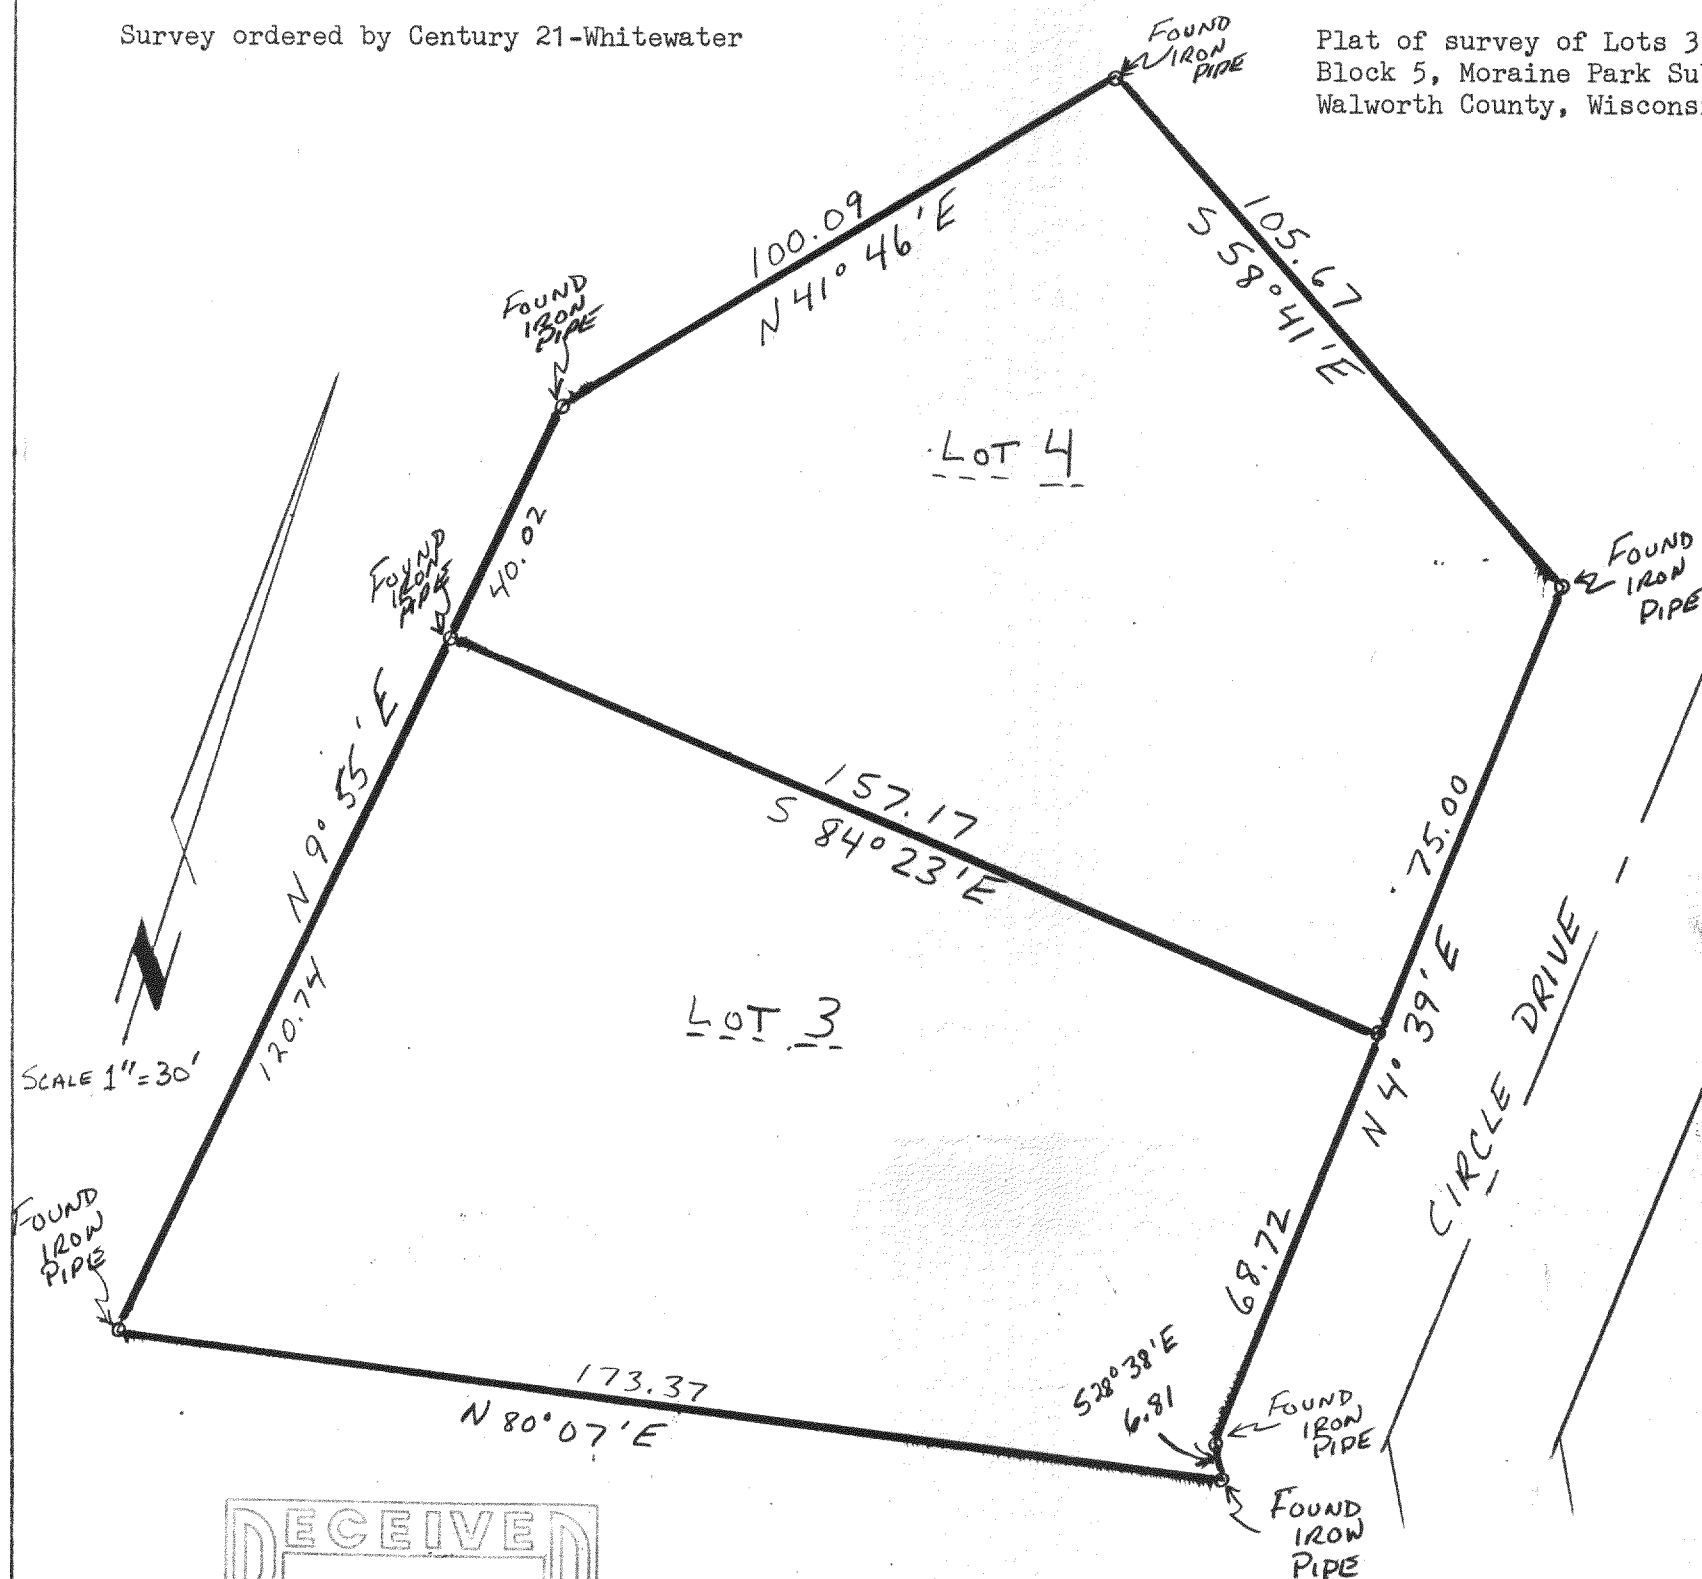


I hereby certify that I have surveyed the property described hereon and that the map shown hereon is a true and accurate representation thereof to the best of my professional knowledge and belief.

Dated this 6 day of November, 1987

Daniel D. Cooper

Daniel D. Cooper, RLS No. S-1464

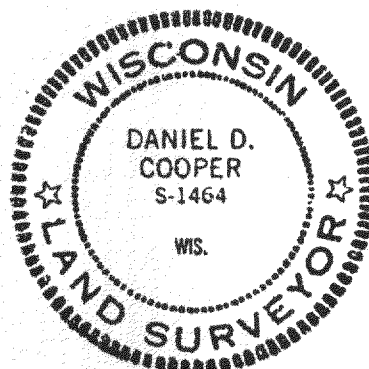

Bearing Reference: Westerly
line of Circle Drive assumed
to bear N4° 39' E.

D Cooper & CO., INC
Rt 4 Box 508B * Elkhorn WI 53121

DRAWING No 3166 S

4/5-79/