




D. Cooper & CO., INC.
 Rt 4 Box 508B • Elkhorn WI 53121

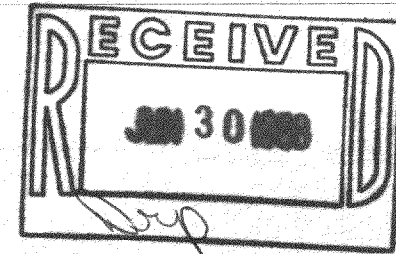

Survey ordered by Century 21
 Whitewater

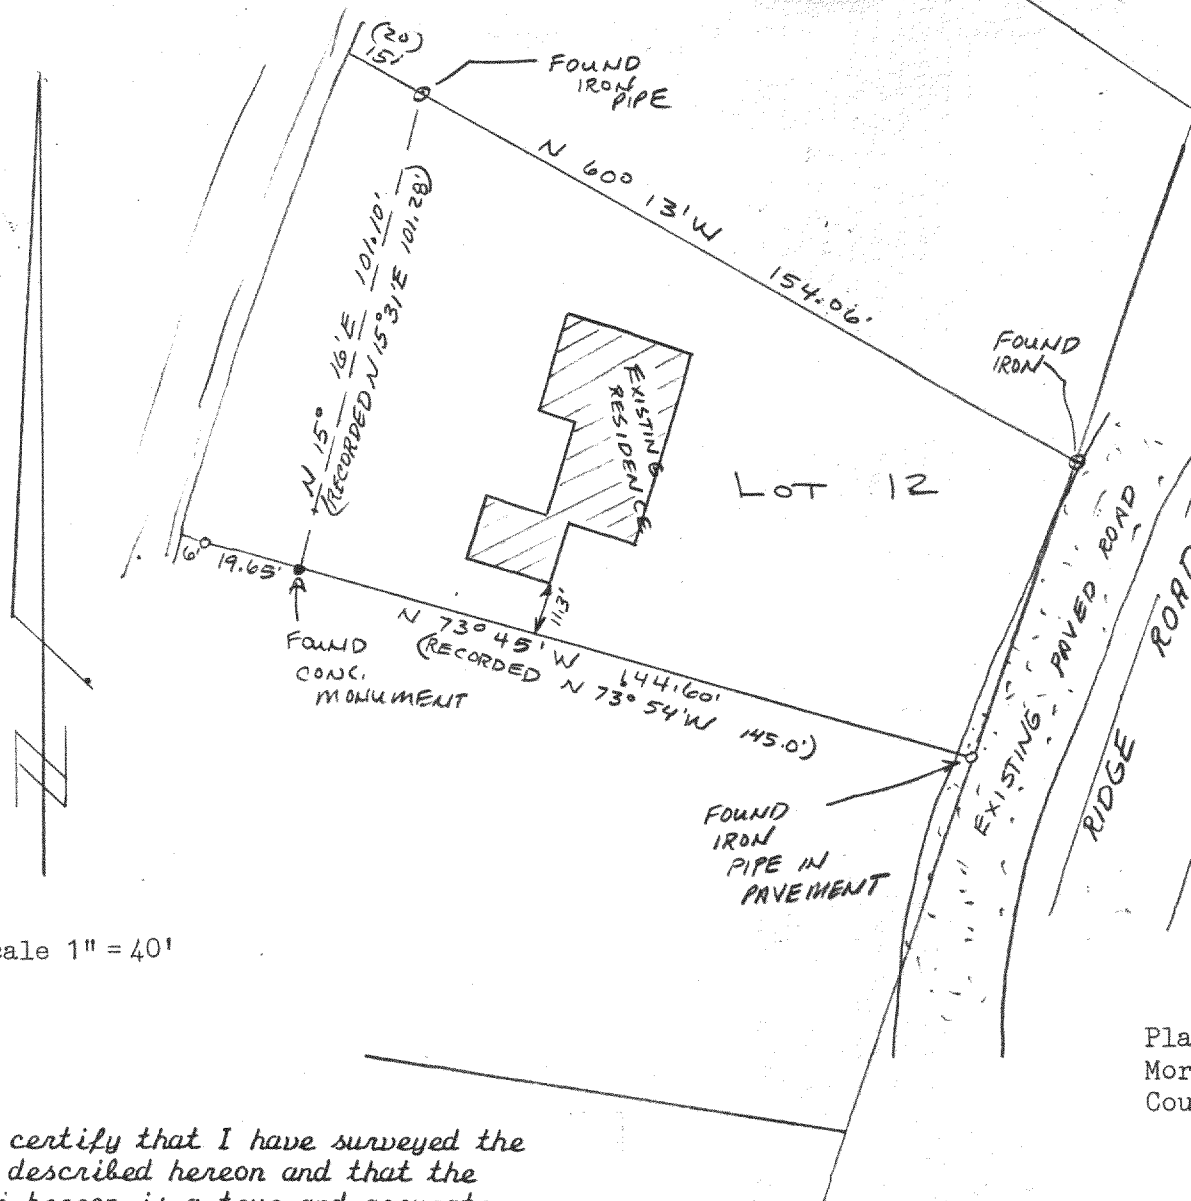

Scale 1" = 40'

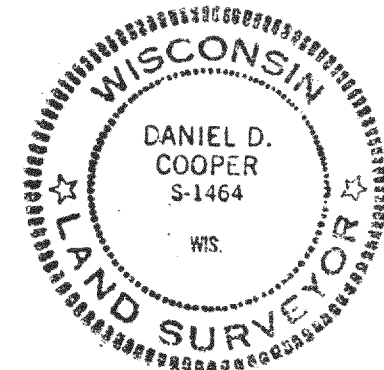

Plat of Survey of Lot 12 Block 4,
 Moraine Heights Subdivision, Walworth
 County, Wis.

I hereby certify that I have surveyed the
 property described hereon and that the
 map shown hereon is a true and accurate
 representation thereof to the best of my
 professional knowledge and belief.

Dated this 20 day of May, 1988

Daniel D. Cooper
 Daniel D. Cooper, RLS No. S-1464
 DMH-95

DRAWING NO. 3229 415-295