
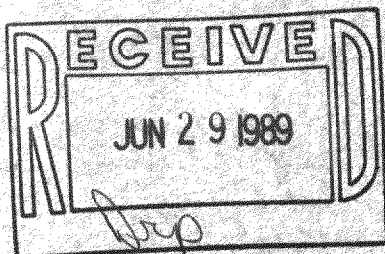


DUNHAM SURVEYING, S.C.
SURVEYING & SUBDIVIDING
DELAVER, WISCONSIN 53115

N

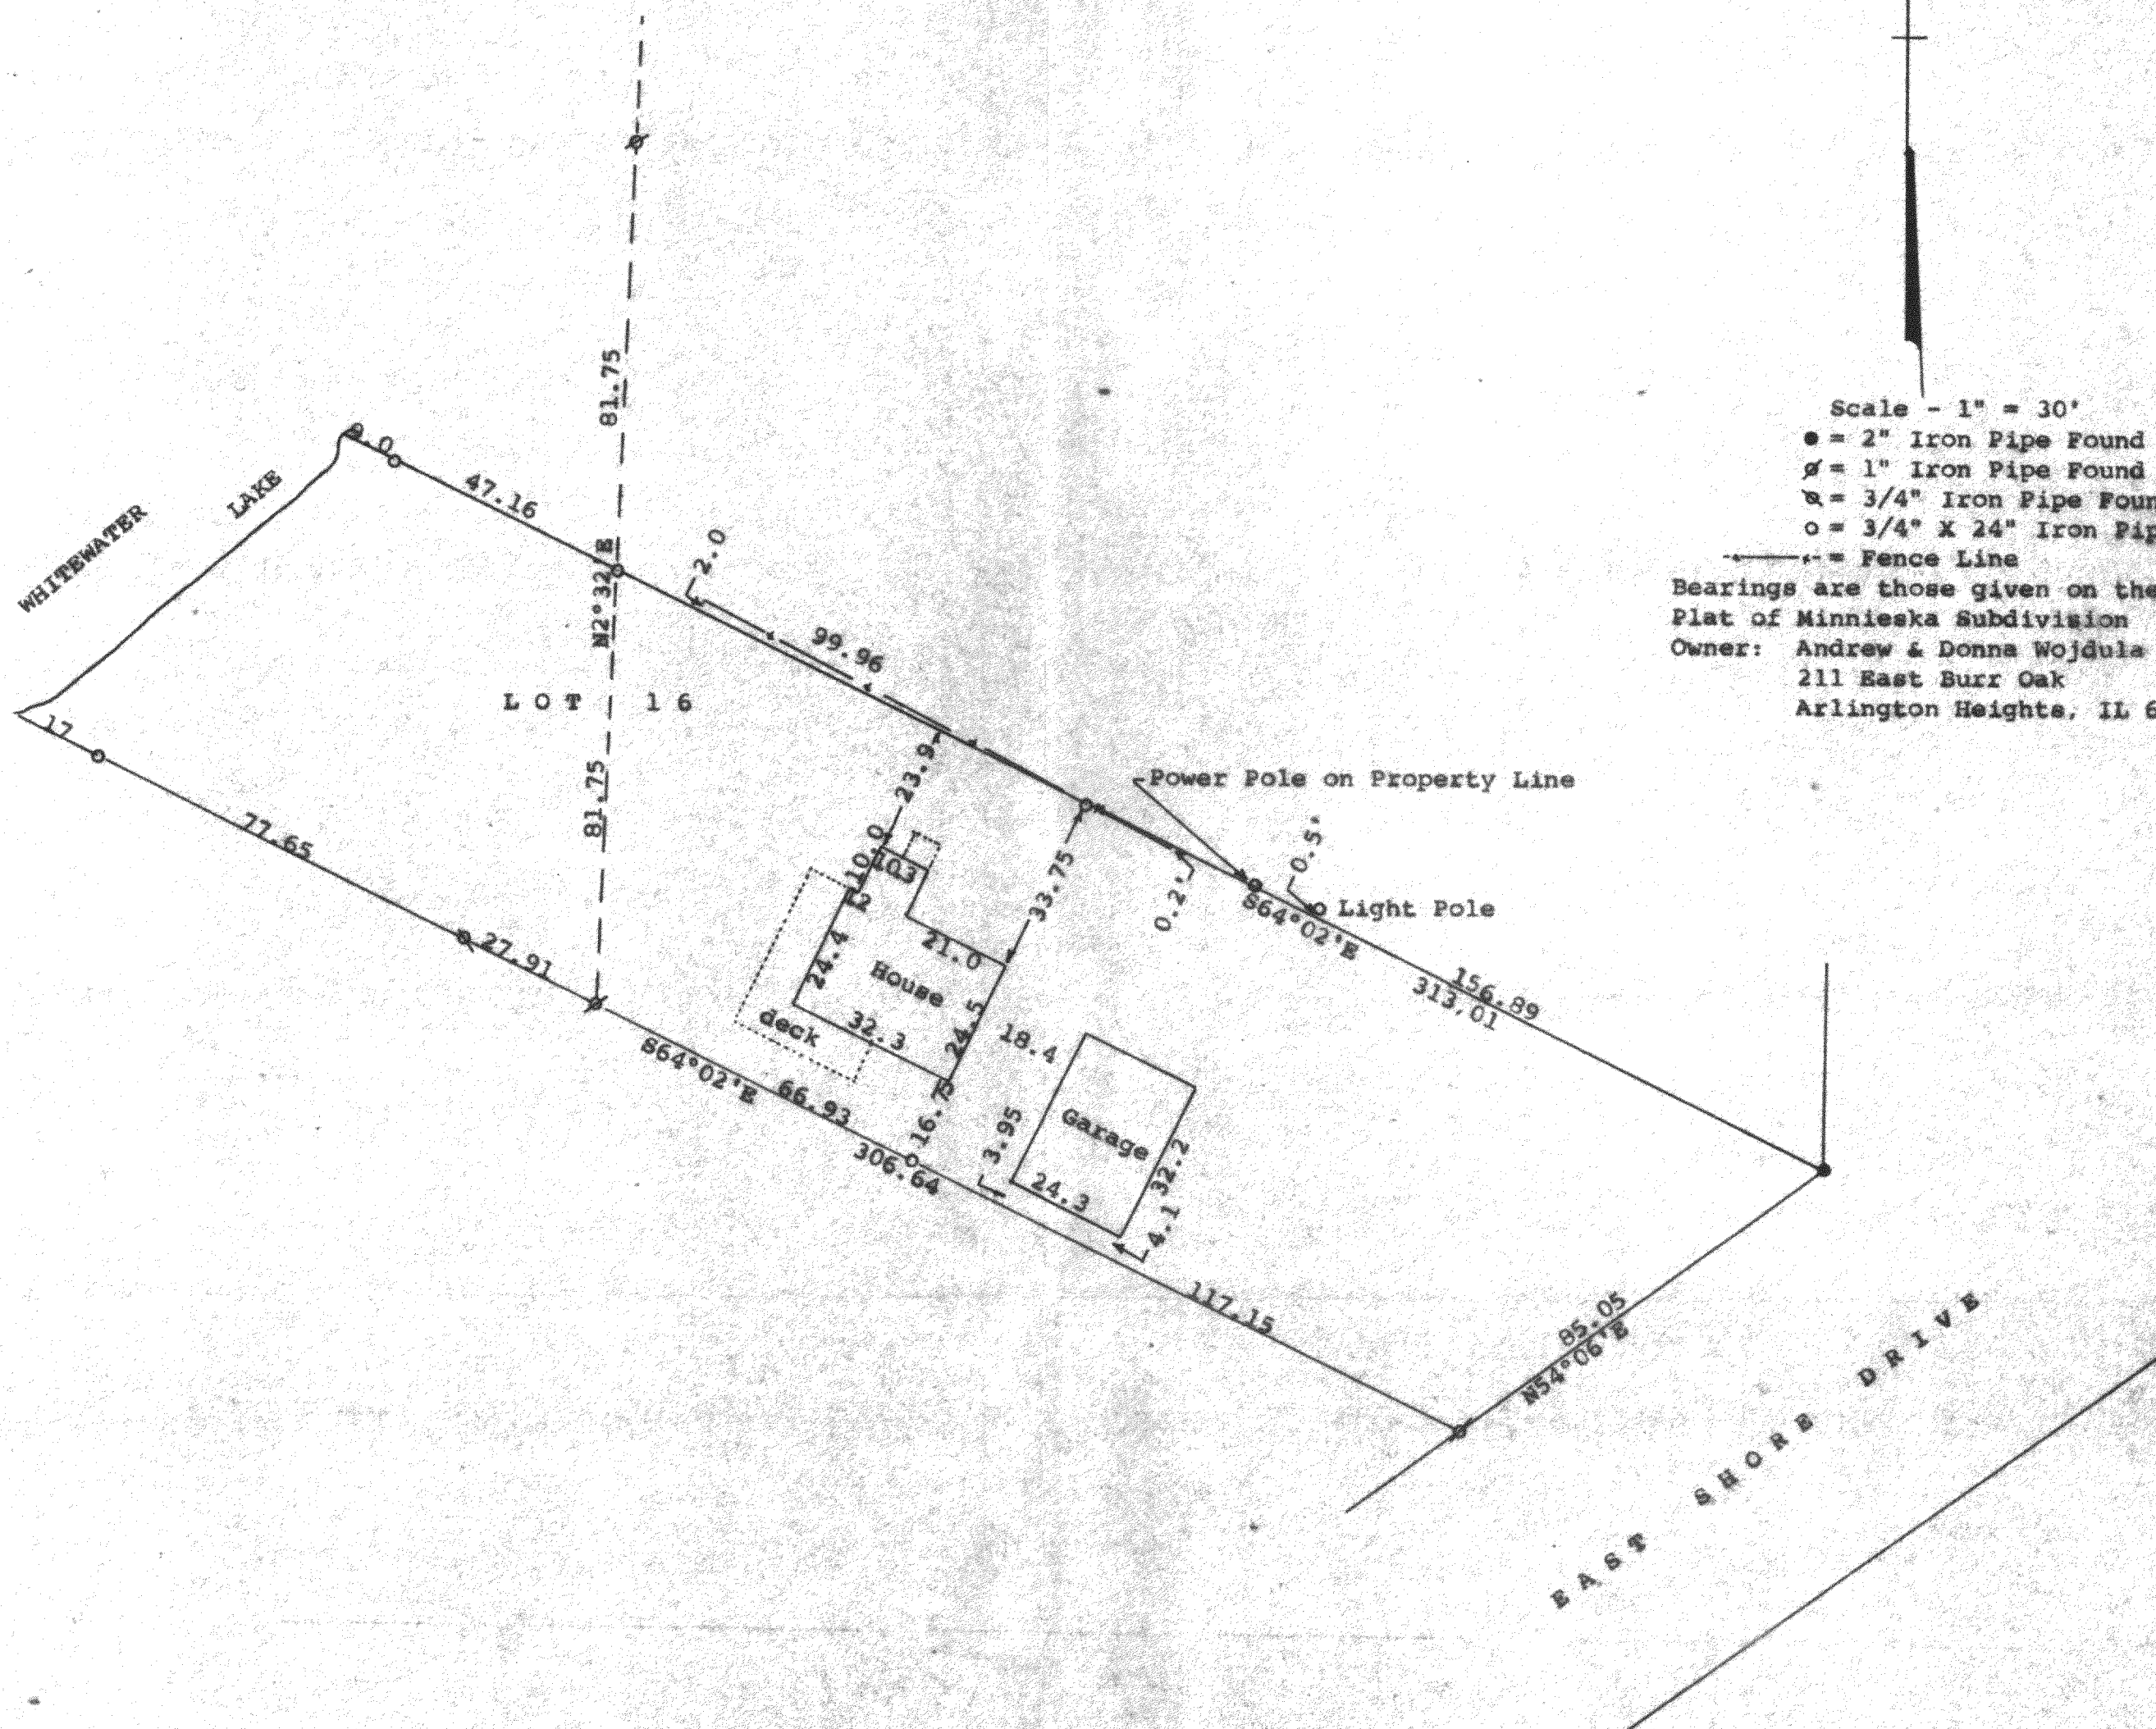

STATE OF WISCONSIN)
COUNTY OF WALNORTH) SS

I, George T. Dunham, Surveyor, certify that I have surveyed the property described as follows:

Lot 16, Block 1, Minnieska Subdivision located in the Northeast 1/4 of Section 35, T 4 N, R 15 E, Walworth County, Wisconsin

and that the plat shown hereon is a correct representation thereof and shows the size and location of the property, its exterior boundaries, the location of all visible structures and dimensions of all principal buildings thereon, boundary fences, apparent easements, roadways and visible encroachments, if any, and that I have surveyed the property hereon described, according to the official records, to the best of my knowledge and belief.

March 20, 1989

George T. Dunham
George T. Dunham, Surveyor

