


D Cooper & CO., INC
 Rt 4 Box 508B * Elkhorn WI 53121

Plat of Survey of Lot 9, Blk 5, Moraine
 Park Sub., Whitewater Lake, Walworth
 County, WI.

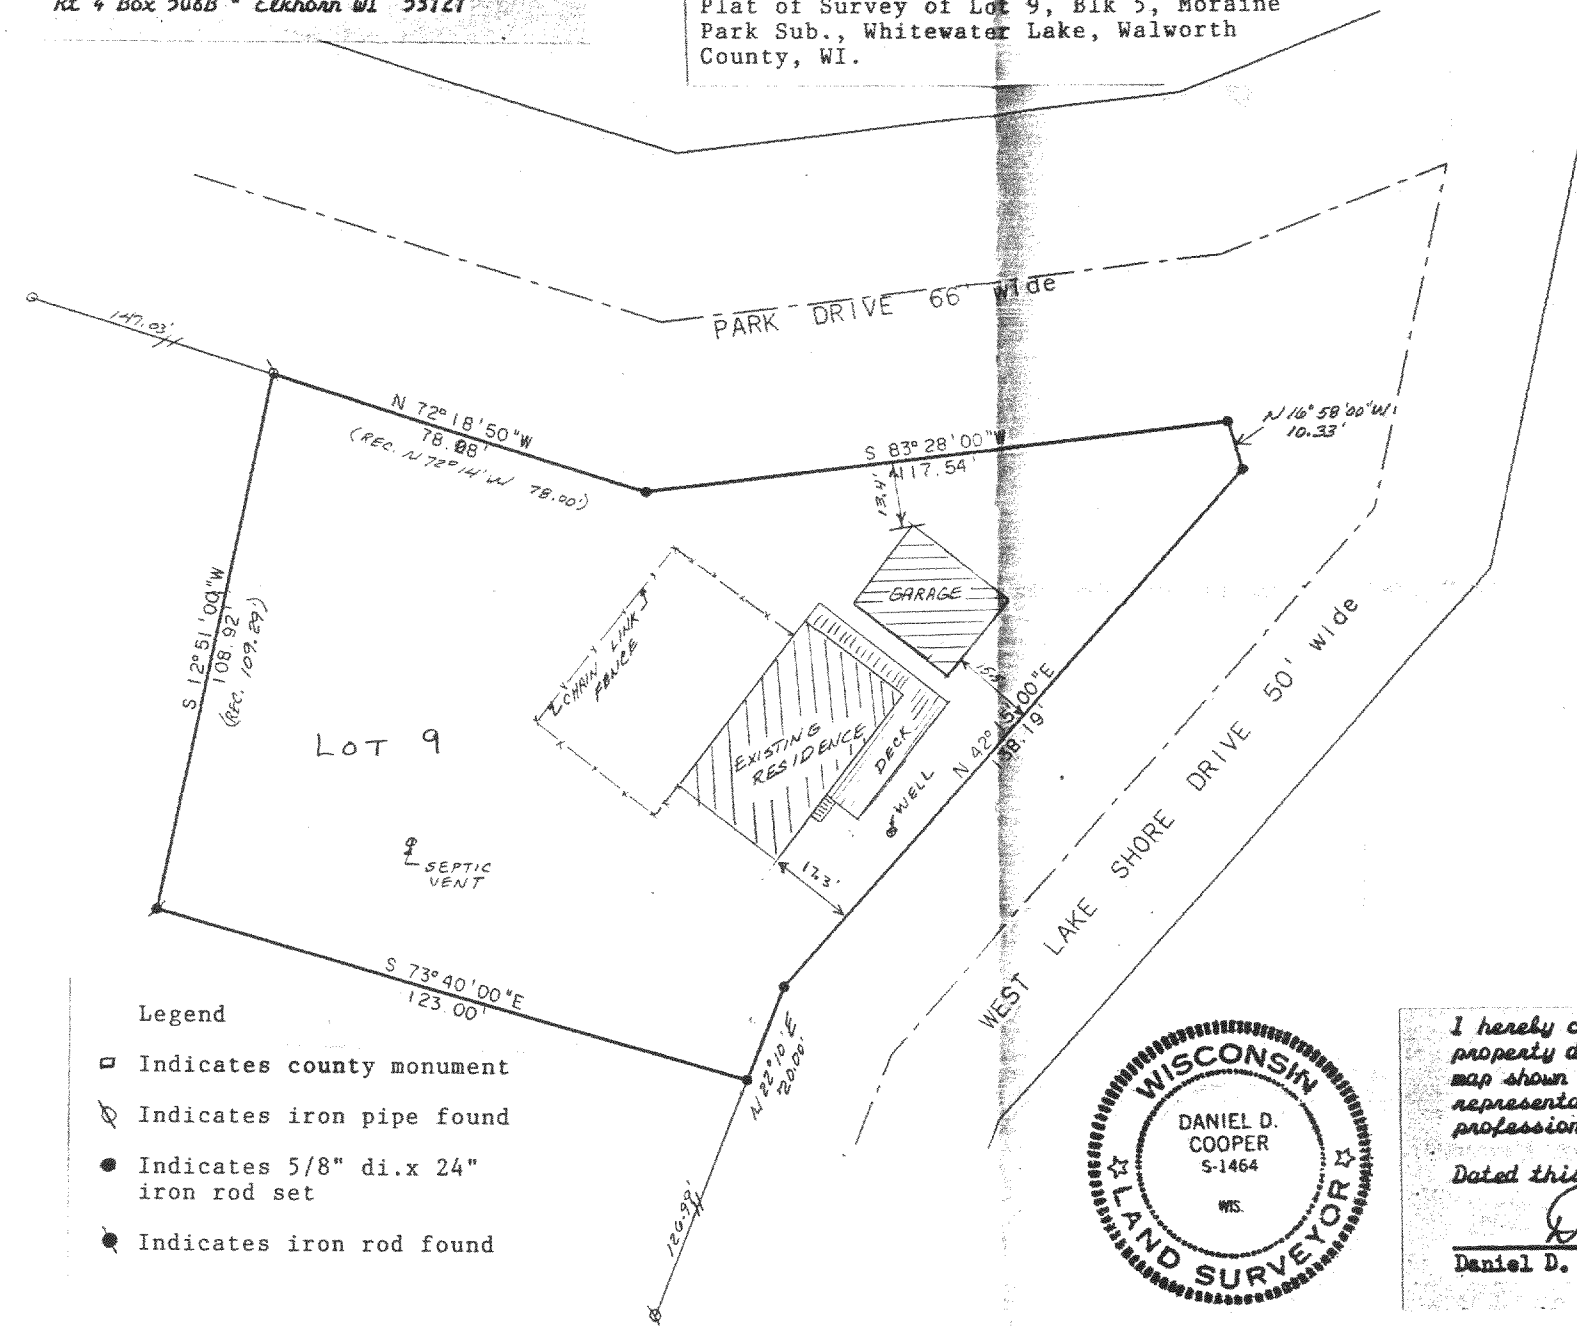

- Legend
- Indicates county monument
 - ⊗ Indicates iron pipe found
 - Indicates 5/8" di. x 24" iron rod set
 - ◆ Indicates iron rod found

I hereby certify that I have surveyed the property described hereon and that the map shown hereon is a true and accurate representation thereof to the best of my professional knowledge and belief.

Dated this 4th day of April, 1990

Daniel D. Cooper
 Daniel D. Cooper, RLS No. S-1464

Reduced

RECEIVED
 FEB 20 1991
WJ

TAX KEY # DMP 00050

DRAWING # 3608