


Survey ordered by TLC Realty-Elkhorn




Scale 1" = 60'

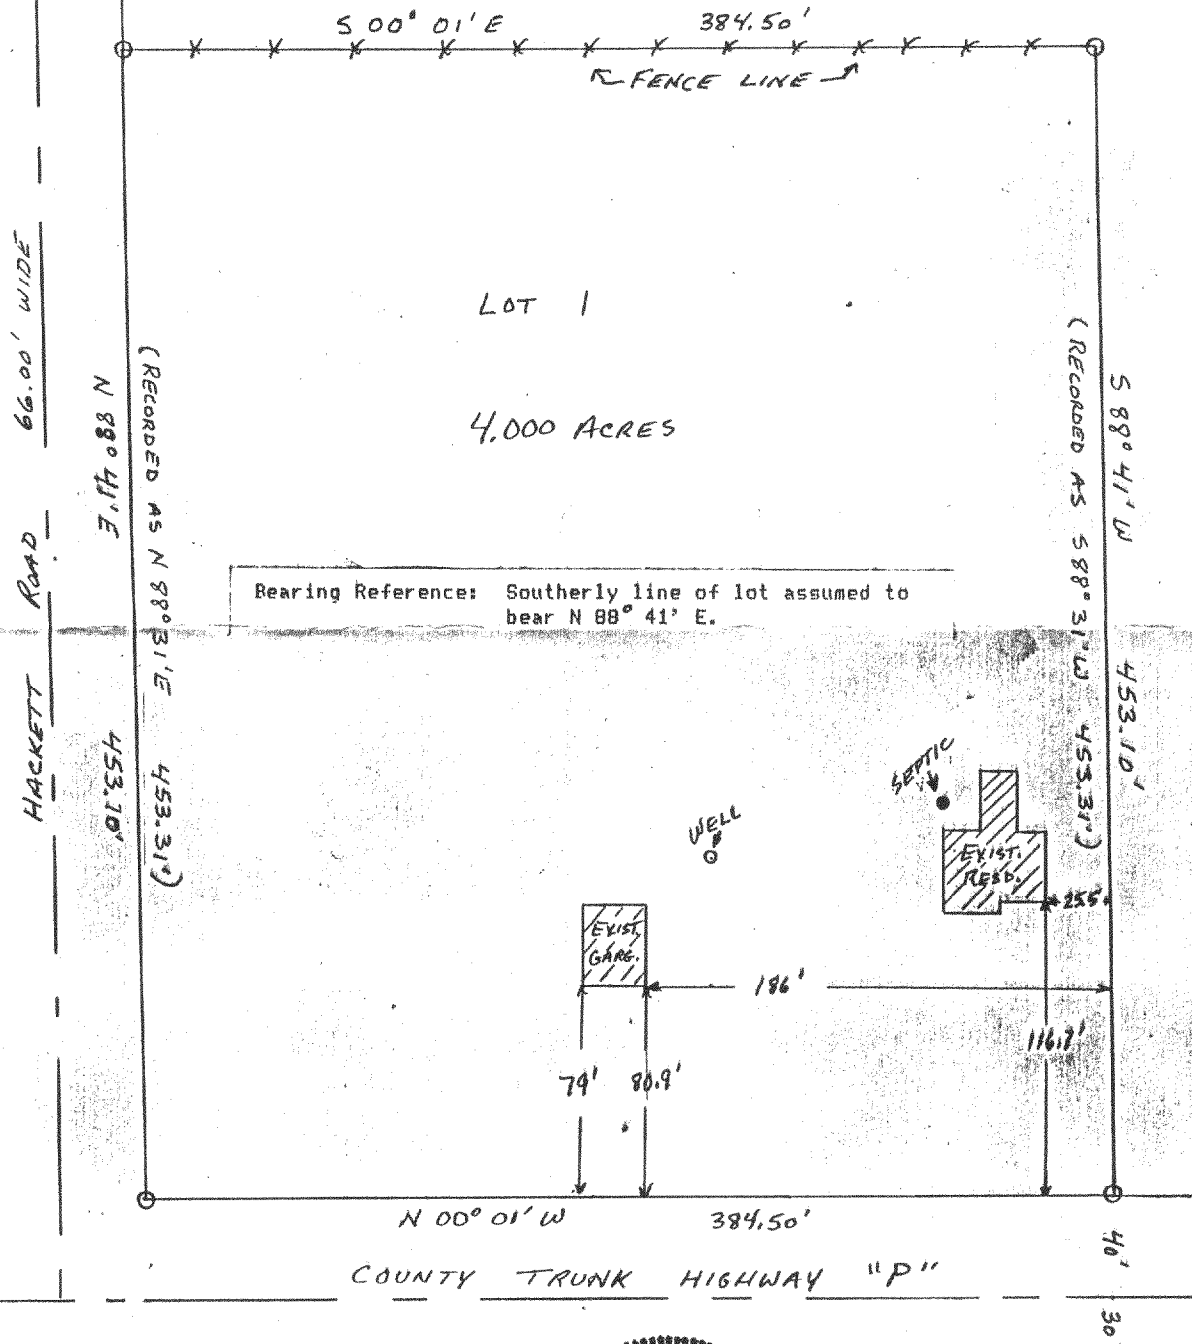

I hereby certify that I have surveyed the property described hereon and that the map shown hereon is a true and accurate representation thereof to the best of my professional knowledge and belief.

Dated this 23rd day of MAY, 1990

Daniel D. Cooper
 Daniel D. Cooper, RLS No. S-1464

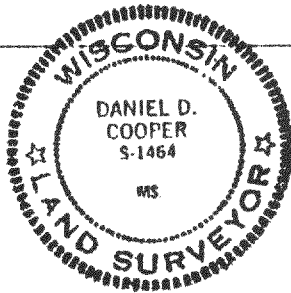


Legend:

- O - found iron pipe
- Ø - set 1" x 24" iron pipe

DRAWING NO. 3632

Reduced

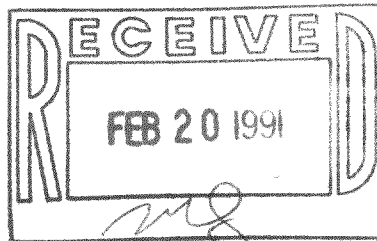

TAX KEY # DA116000001

415-315