


PLAT OF SURVEY OF LOT 2, CERTIFIED SURVEY MAP NO. 906.
being located in the SW $\frac{1}{4}$ of the NW $\frac{1}{4}$ of Section 2, T4N, R15E,
Walworth County, Wisconsin

Survey ordered by Rummel-Devitt and Assc.-Whitewater

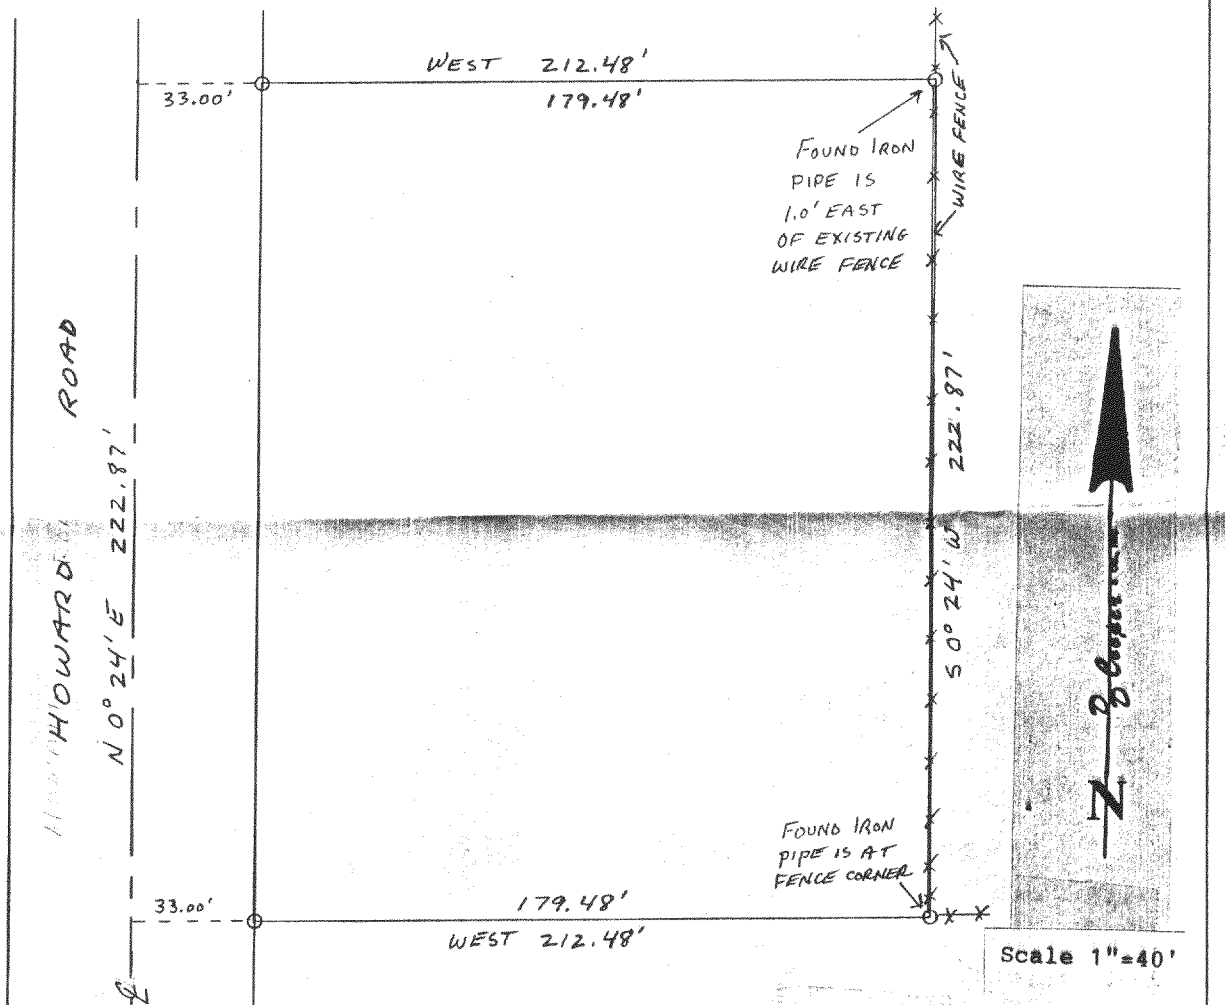

Bearing Reference: Westerly line of parcel assumed
to bear N0°33'40"E as recorded

I hereby certify that I have surveyed the
property described hereon and that the
map shown hereon is a true and accurate
representation thereof to the best of my
professional knowledge and belief.


Dated this 1ST day of AUG., 1989

Daniel D. Cooper
Daniel D. Cooper, RLS No. S-1464

Legend:

- - found iron pipe
- ⊙ - set 3/4"x24" iron rod

DRAWING NO. 3484

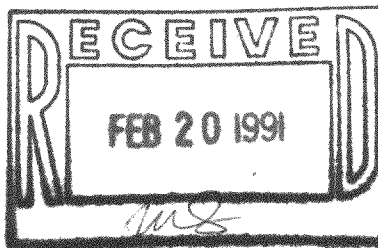

Reduced

TAX KEY # DA 906 - Z

415-320