

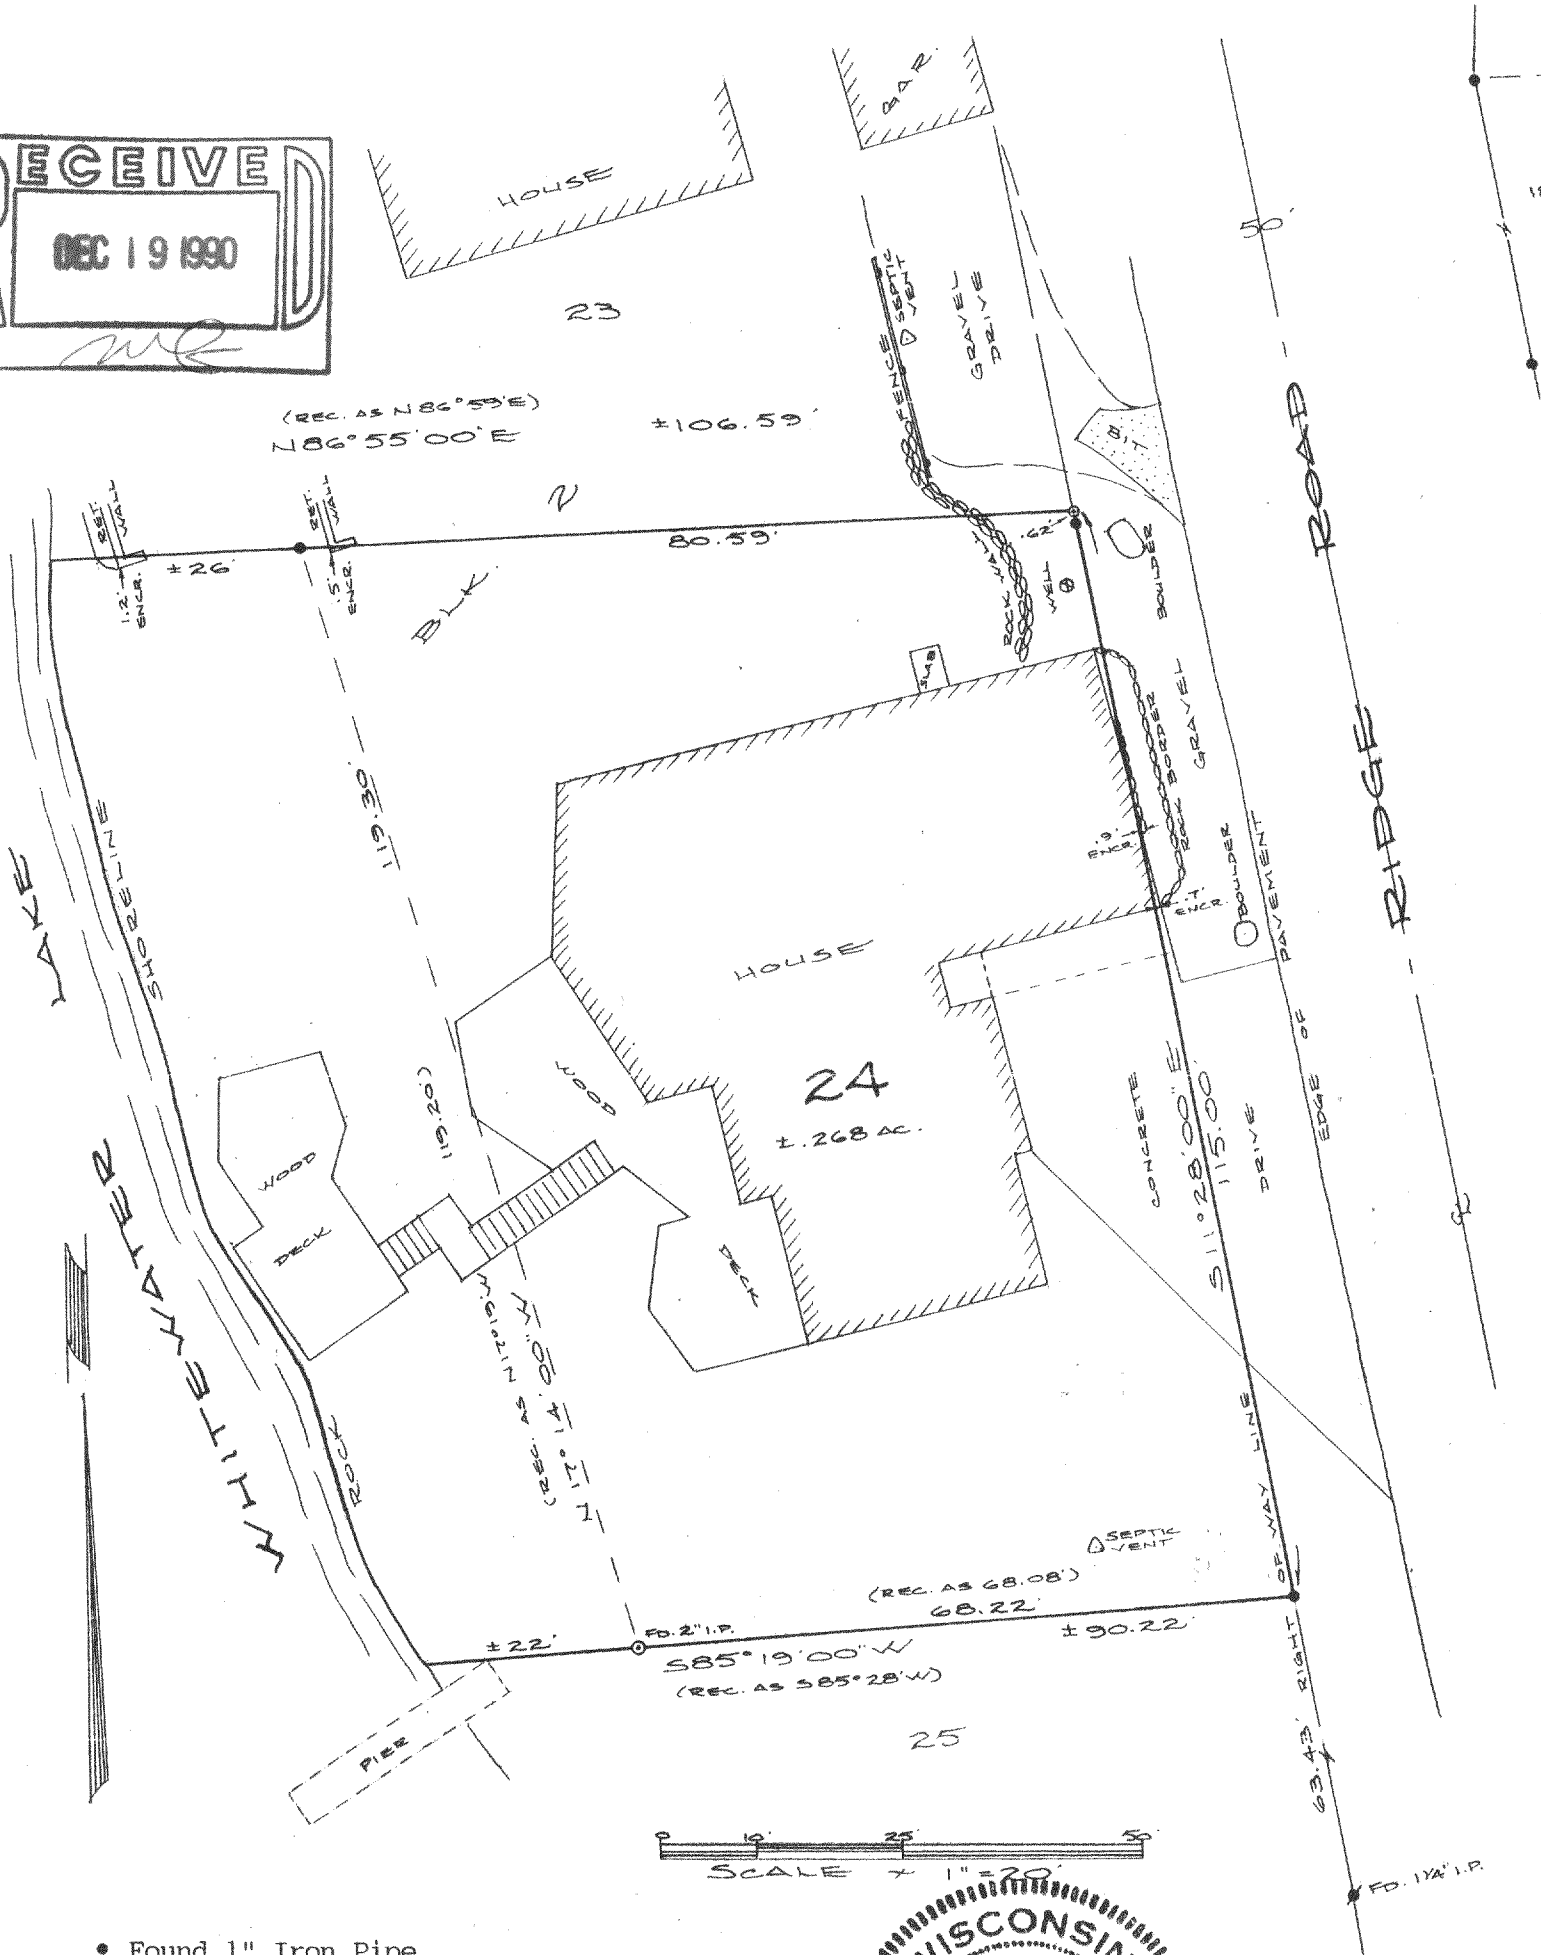


PLAT OF SURVEY

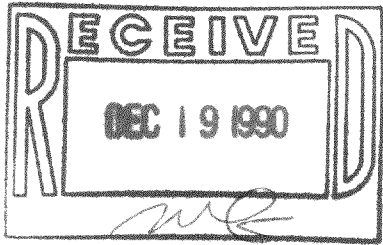

- Found 1" Iron Pipe
- o Set 1"x24" Iron Pipe

Prepared for: Attorney Mitch Simon
304 W. Main Street
Whitewater, WI 53190

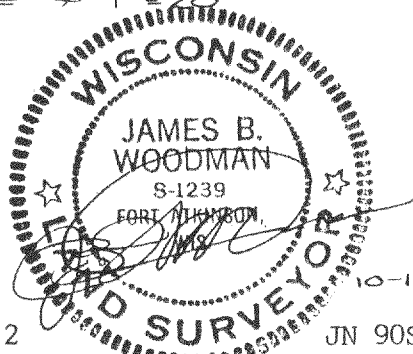

Sheet 1 of 2

JN 90S-121

WOODMAN, ANDERSON & ASSOCIATES
210 Madison Avenue, Fort Atkinson, WI 53538

Registered Land Surveyors
Phone (414) 563-8162

TAX KEY # DMH 00057

415-323

PLAT OF SURVEY

DESCRIPTION



Lot 24, Block 2, MORaine HEIGHTS SUBDIVISION in the NW $\frac{1}{4}$ of
Section 35, T4N, R15E, Town of Whitewater, Walworth County,
Wisconsin.

CERTIFICATION

I hereby certify that the property described above has been
surveyed under my responsible direction and supervision and
that this map is a correct representation of the lot lines
and dimensions and the principle lines of the permanent
structures thereon.

Date 10-18-90


James B. Woodman
Registered Land Surveyor, S-1239

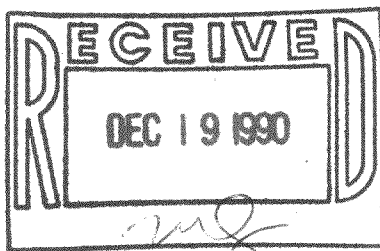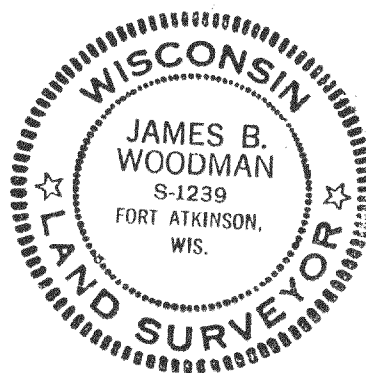

Tax Key # DMH 00057