


ABELL
SURVEYING & MAPPING
DELAVAL, WISCONSIN 53115
414-728-6737

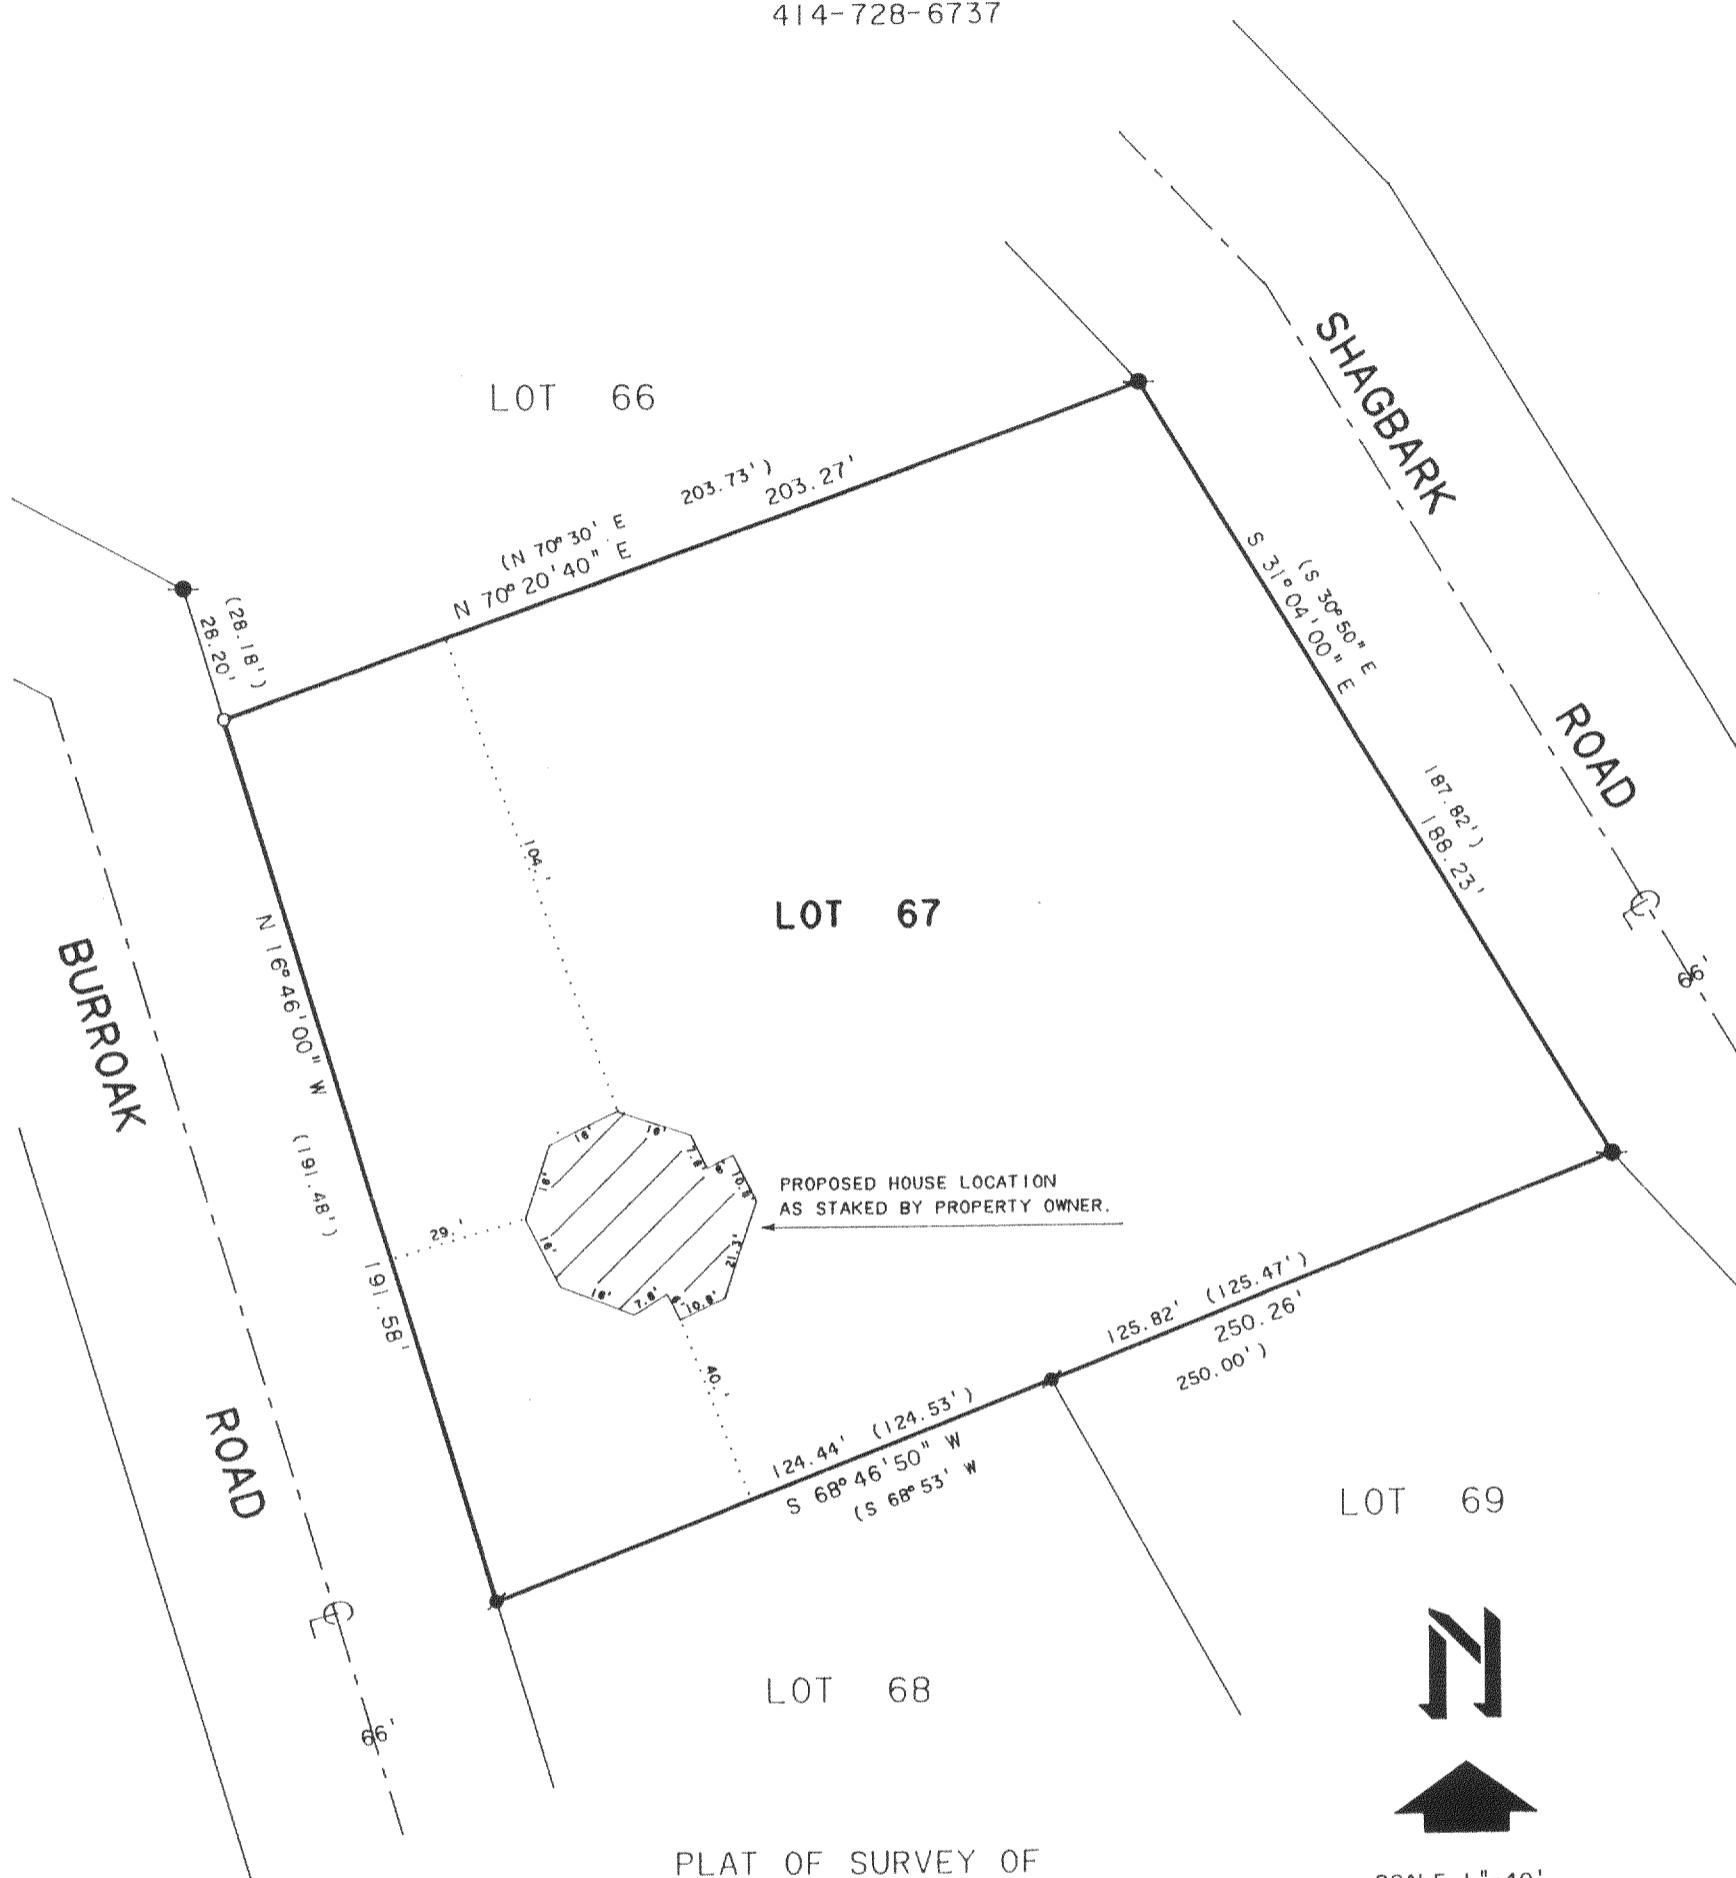

SCALE 1"=40'

LEGEND


- - IRON ROD FOUND
- - IRON BAR FOUND
- - IRON PIPE SET
- () - RECORDED AS

ORDERED BY: EDWARD ERDMANN
1563 W. WILDWOOD NO. 9
WHITEWATER, WI. 53190

NOTE: THE BEARING OF THE WEST LINE OF LOT 67,
IS ASSUMED N 16° 46' W AS SHOWN ON THE
SUBDIVISION PLAT.

I, DAVID F. ABELL, DO HEREBY CERTIFY THAT I HAVE SURVEYED THE PROPERTY HEREON
DESCRIBED ACCORDING TO THE OFFICIAL RECORDS AND THAT THE PLAT HEREON IS A
CORRECT REPRESENTATION OF THE PROPERTY LINES TO THE BEST OF MY KNOWLEDGE AND
BELIEF.

David F. Abell
DAVID F. ABELL
WISCONSIN REGISTERED LAND SURVEYOR, S-1596

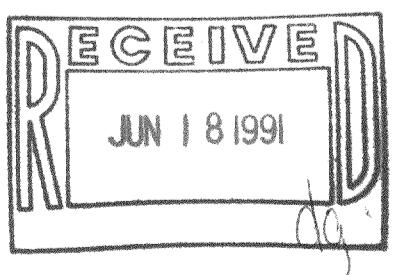

February 13, 1991
DATE: JOB NUMBER - 91022
NOTE: THIS IS NOT A CERTIFIED COPY UNLESS SEALED.