
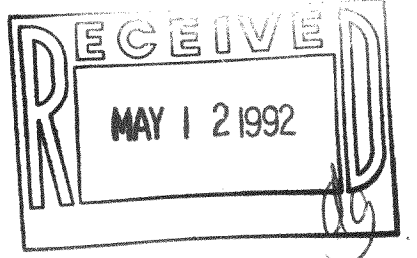


PLAT OF SURVEY

LEGAL DESCRIPTION  
Lot 10 of Block 2 of Minnieska  
Subdivision, Located in the Northeast 1/4  
of Section 35, Town 4 North, Range 15  
East, Town of Whitewater, County of  
Walworth, State of Wisconsin.


Owner: Elizabeth Darbo  
Trustee  
120 Windsor Park Drive  
Carol Stream, Illinois 60188

Ordered by: Sue White  
T L C Realty, Inc.  
239 East Milwaukee Street  
Whitewater, Wisconsin 53190

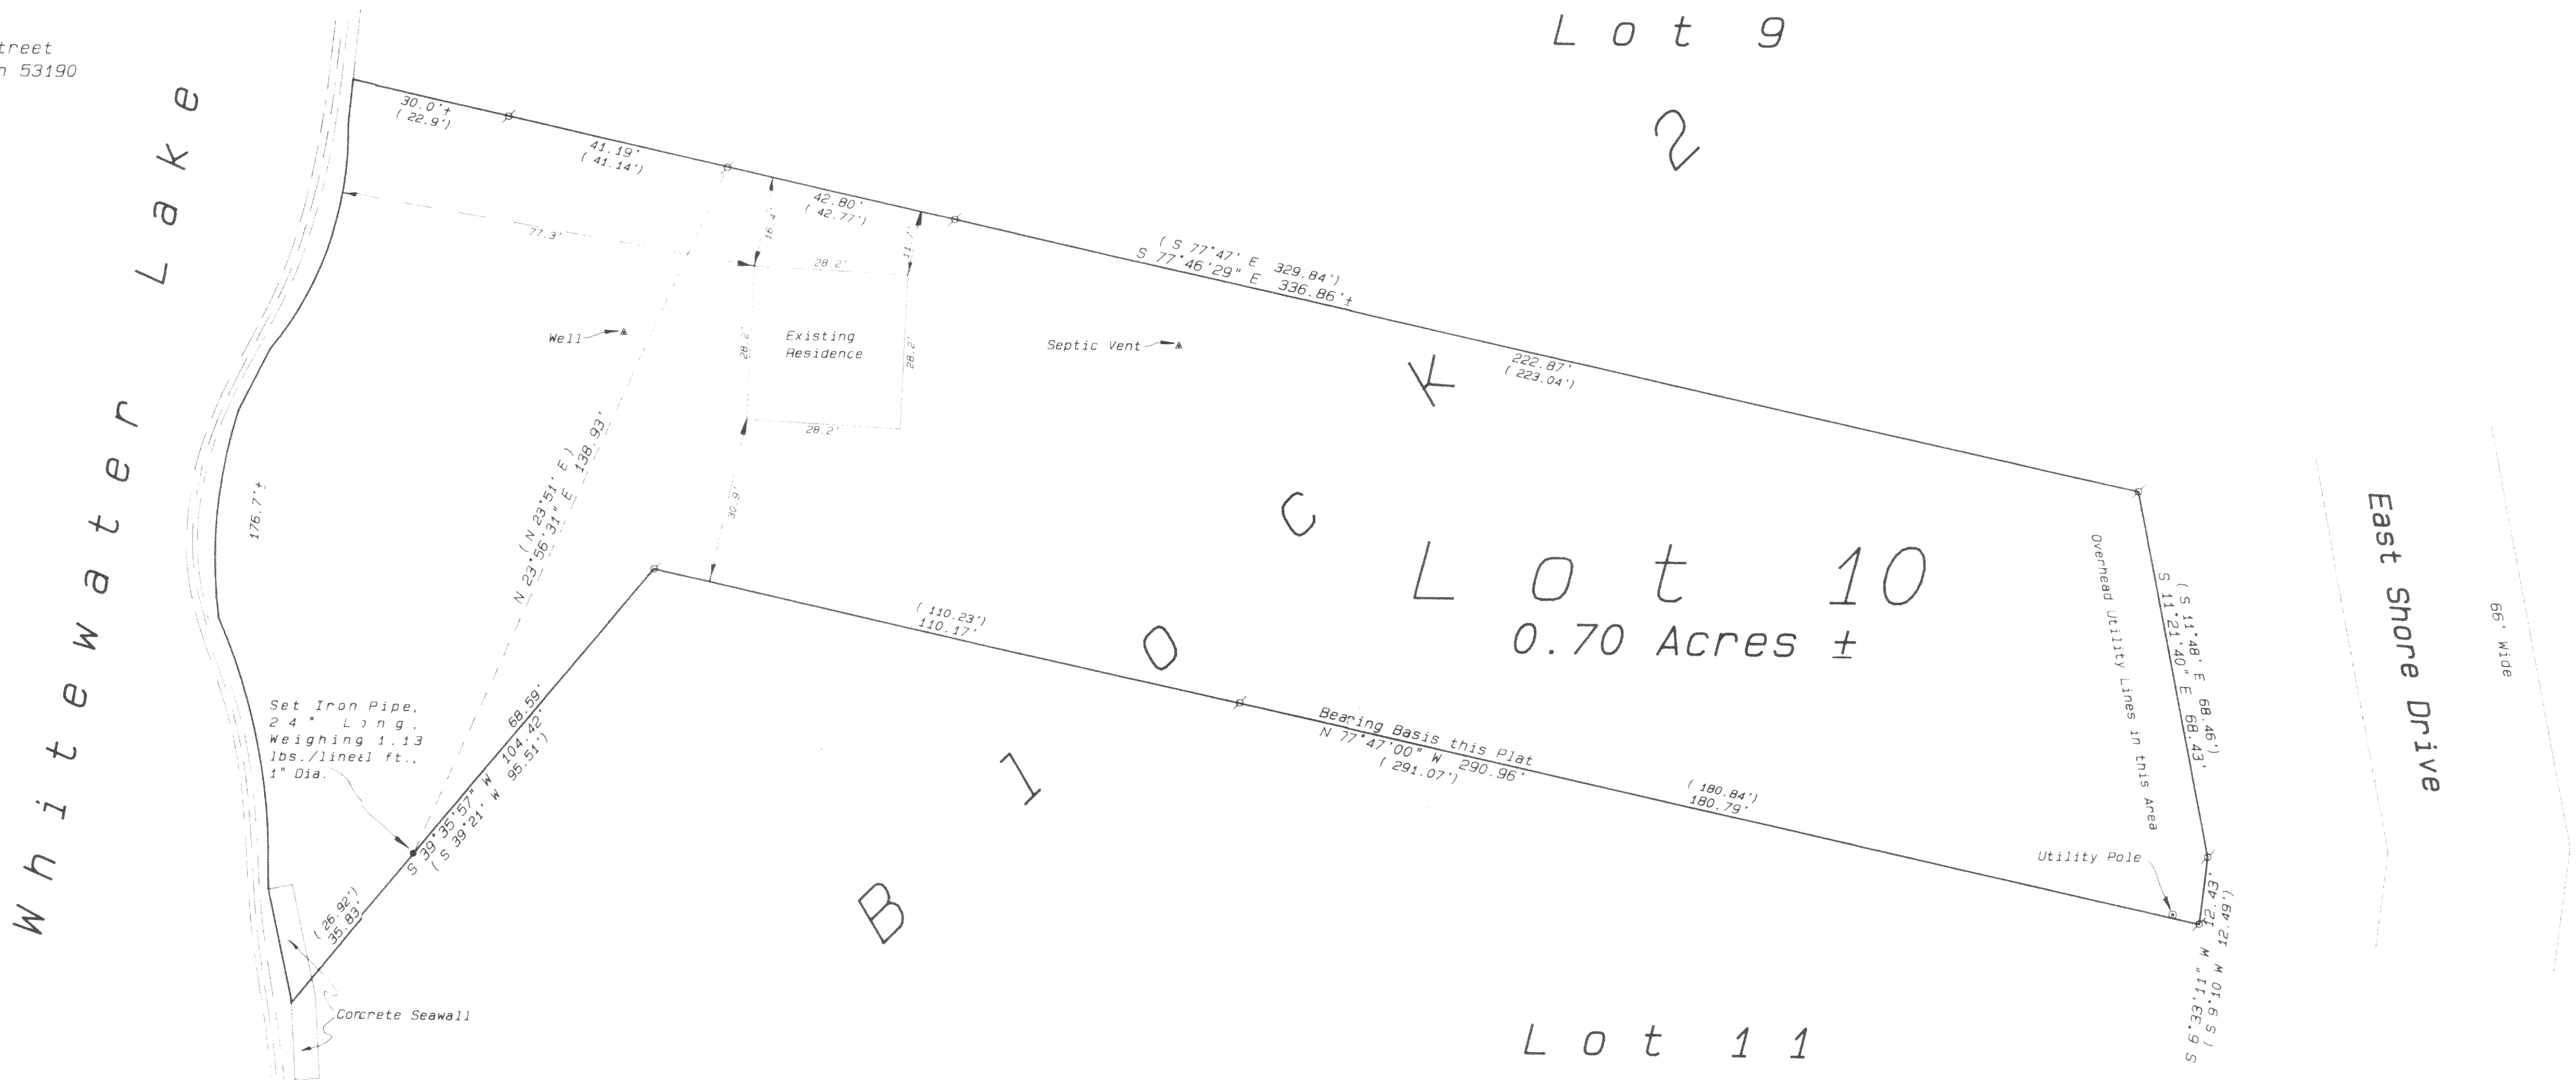

- Legend
- FOUND IRON PIPE
  - FOUND IRON ROD
  - FOUND BRASS CAPPED MONUMENT
  - FOUND CONCRETE MONUMENT
  - CHISEL CUT IN CONCRETE
  - SET IRON ROD, 24" LONG, WEIGHING 1.5 LBS. LINEAL FT., 1/4" DIA.
  - SET IRON ROD, 30" LONG, WEIGHING 4.5 LBS. LINEAL FT., 1/4" DIA.
  - RECORDED AS DIMENSION
  - EXISTING FENCE

SCALE: 1"= 20 FEET

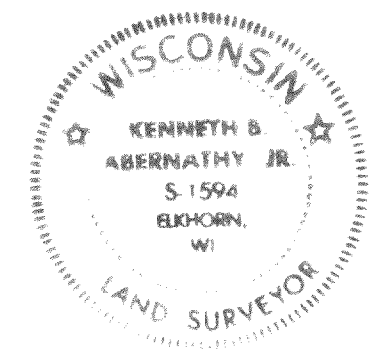

I hereby certify that I have surveyed the above described property and that the above map is a true representation thereof and shows the size and location of the property, its exterior boundaries, the location of all visible structures and dimensions of all principal buildings thereon, boundary fences, apparent easements, roadways and visible encroachments, if any.  
This survey is made for the use of the present owners of the property, and also those who purchase mortgage, or guarantee the title thereto within one year from date hereof.  
Kenneth B. Abernathy Jr.  
KENNETH B. ABERNATHY, JR.  
WISCONSIN REGISTERED LAND SURVEYOR,  
S-1594  
Date: April 21, 1992 Job No. 1992-401