


DUNHAM SURVEYING, S.C.
SURVEYING & SUBDIVIDING
DELAVAN, WISCONSIN 53115

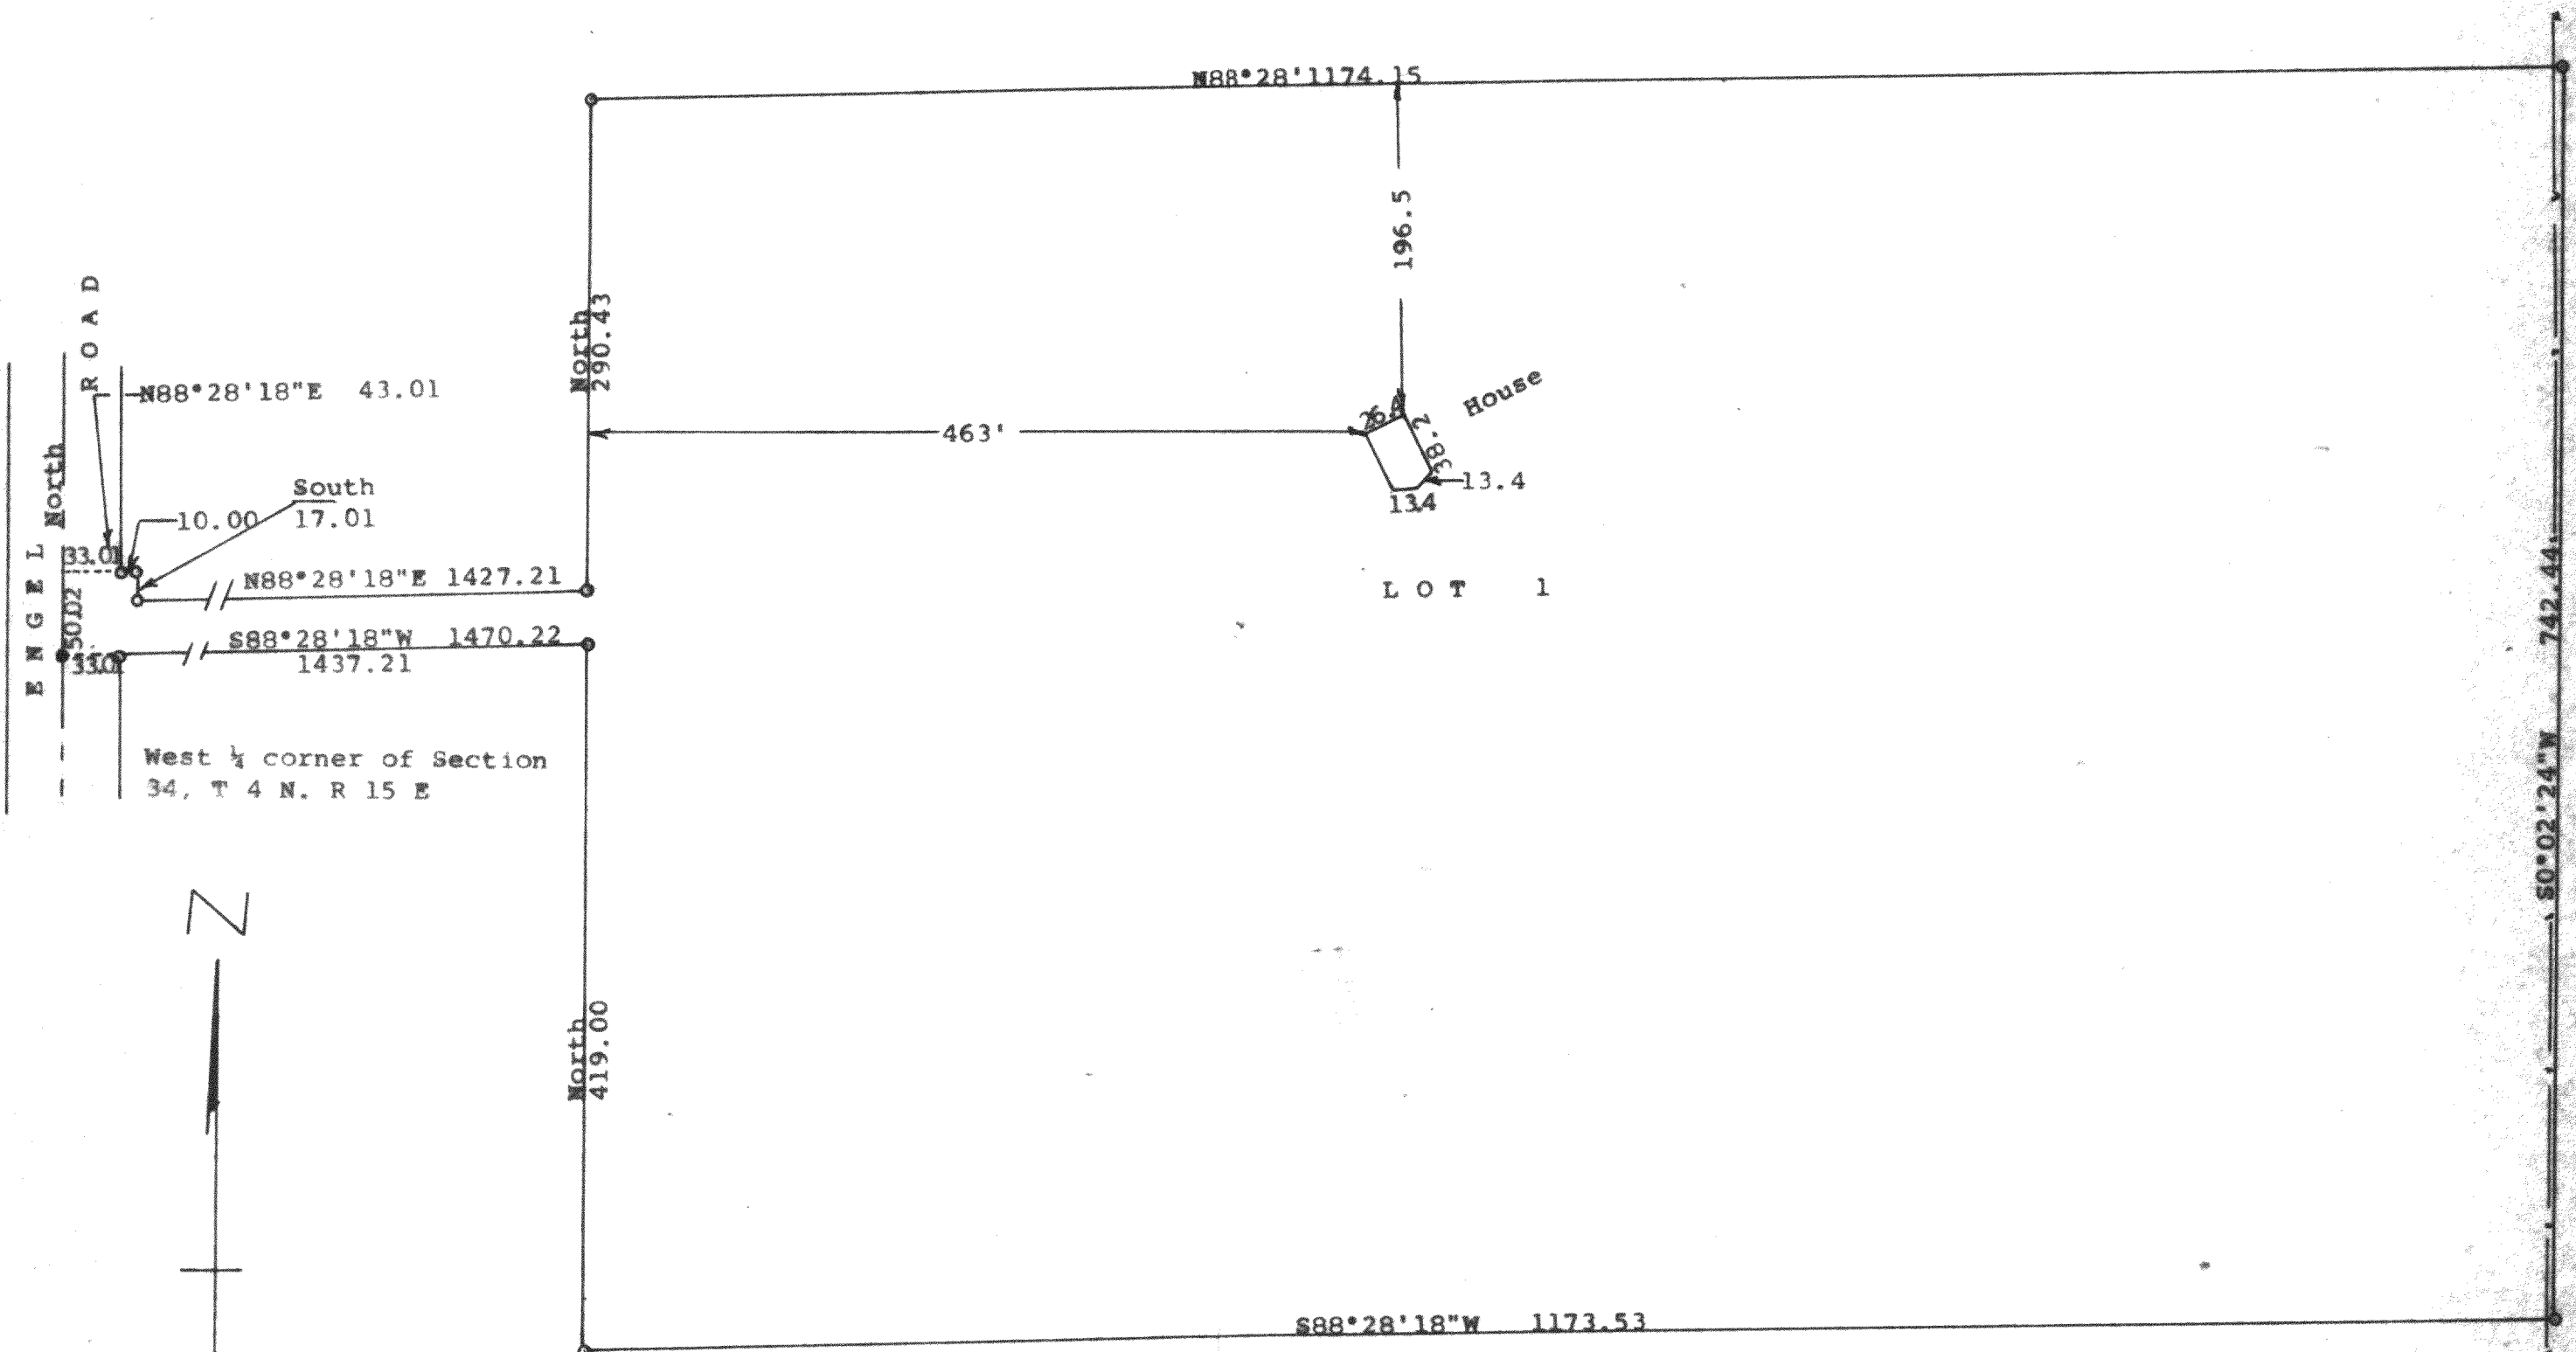

STATE OF WISCONSIN)
COUNTY OF WALWORTH) SS

I, George T. Dunham, Surveyor, certify that I have surveyed the property described as follows:

Lot 1 of Certified Survey Map No. 1889, Document No. 186658, recorded in Volume 9 of Certified Surveys, Page 70, in the Office of the Register of Deeds, Walworth County, Wisconsin, being a parcel of land located in the South 1/2 of the Northwest 1/4 and in the Northeast 1/4 of the Southwest 1/4 of Section 34, T 4 N, R 15 E, Walworth County, Wisconsin

and that the plat shown hereon is a correct representation thereof and shows the size and location of the property, its exterior boundaries, the location of all visible structures and dimensions of all principal buildings thereon, boundary fences, apparent easements, roadways and visible encroachments, if any, and that I have surveyed the property hereon described, according to the official records, to the best of my knowledge and belief.

October 3, 1990

George T. Dunham
George T. Dunham, Surveyor

