



PLAT OF SURVEY

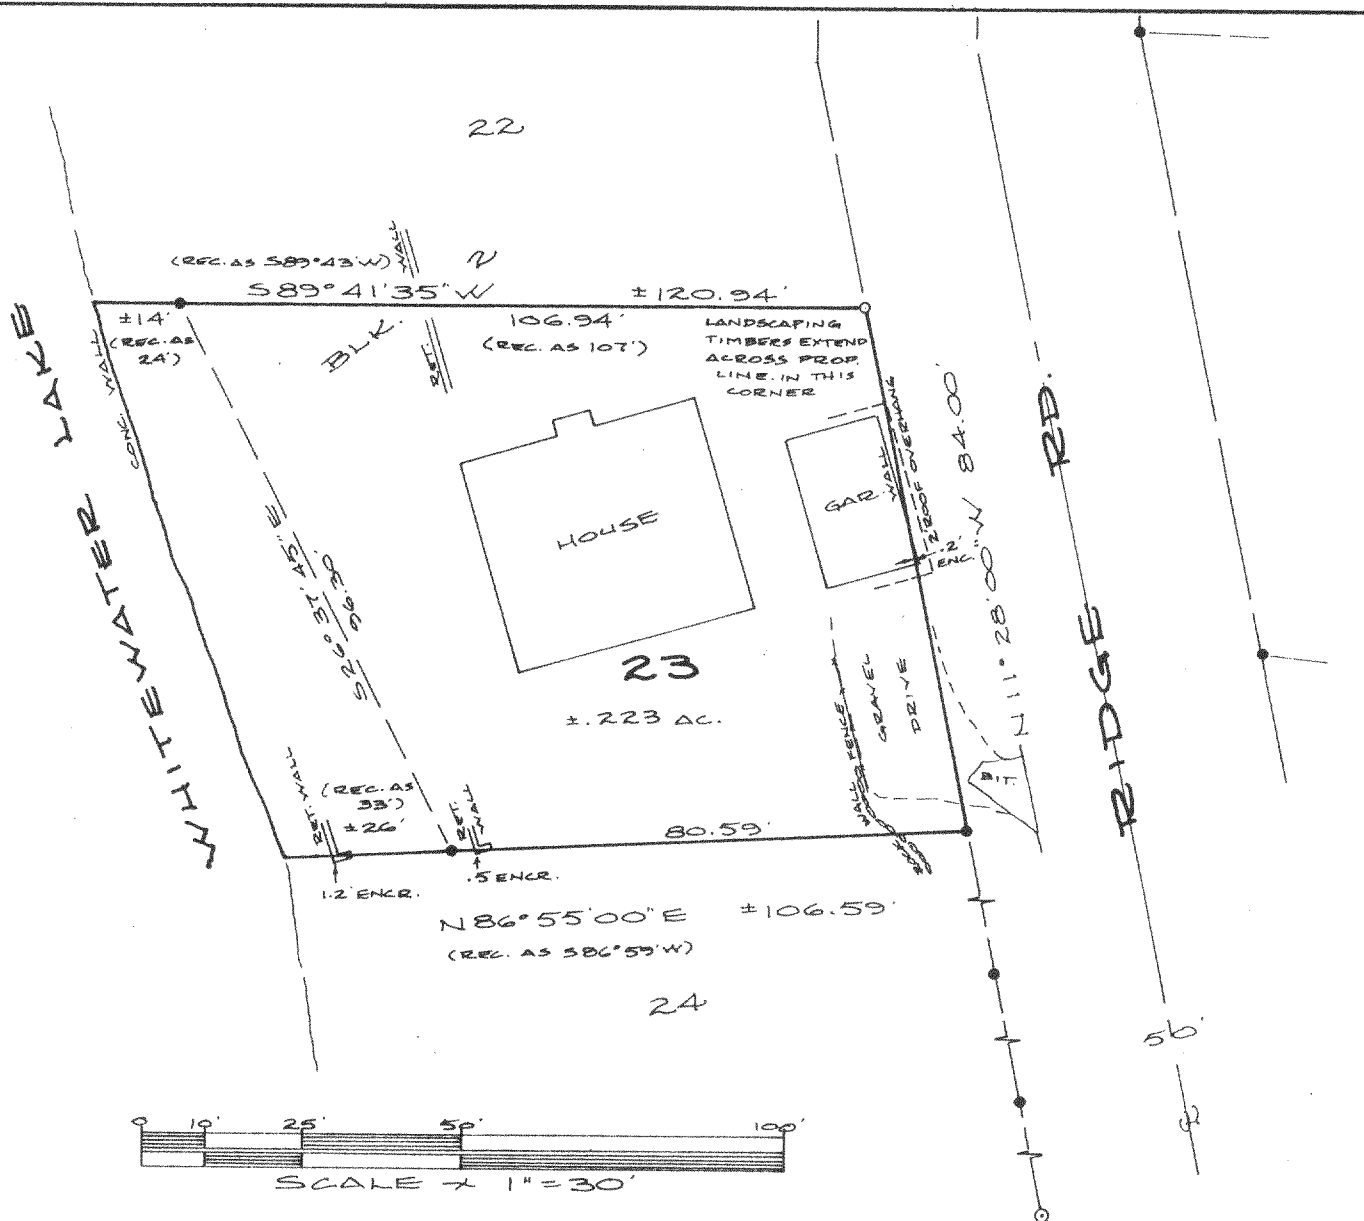

- ⊙ Found 1½" Iron Pipe
- Found 1" Iron Pipe
- ⊙ Set 1"x24" Iron Pipe

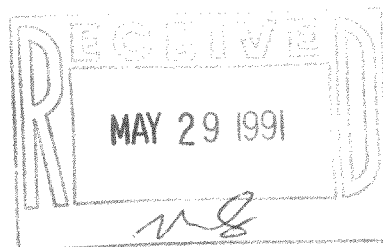

DESCRIPTION

Lot 23, Block 2, MORAINE HEIGHTS SUBDIVISION in the NW¼ of Section 35, T4N, R15E, Town of Whitewater, Walworth County, Wisconsin.

CERTIFICATION

I hereby certify that the property described above has been surveyed under my responsible direction and supervision and that this map is a correct representation of the lot lines and dimensions and the principle lines of the permanent structures thereon.

Date 4-22-91

Prepared for: Richard C. Pickett
c/o Atty. Mark T. Olm
OLM & RACE
1173 W. Main Street
Whitewater, WI 53190

[Signature]
James B. Woodman
Registered Land Surveyor, S-1239

