



COPY PART
OF TAX LISTOR'S
MAP

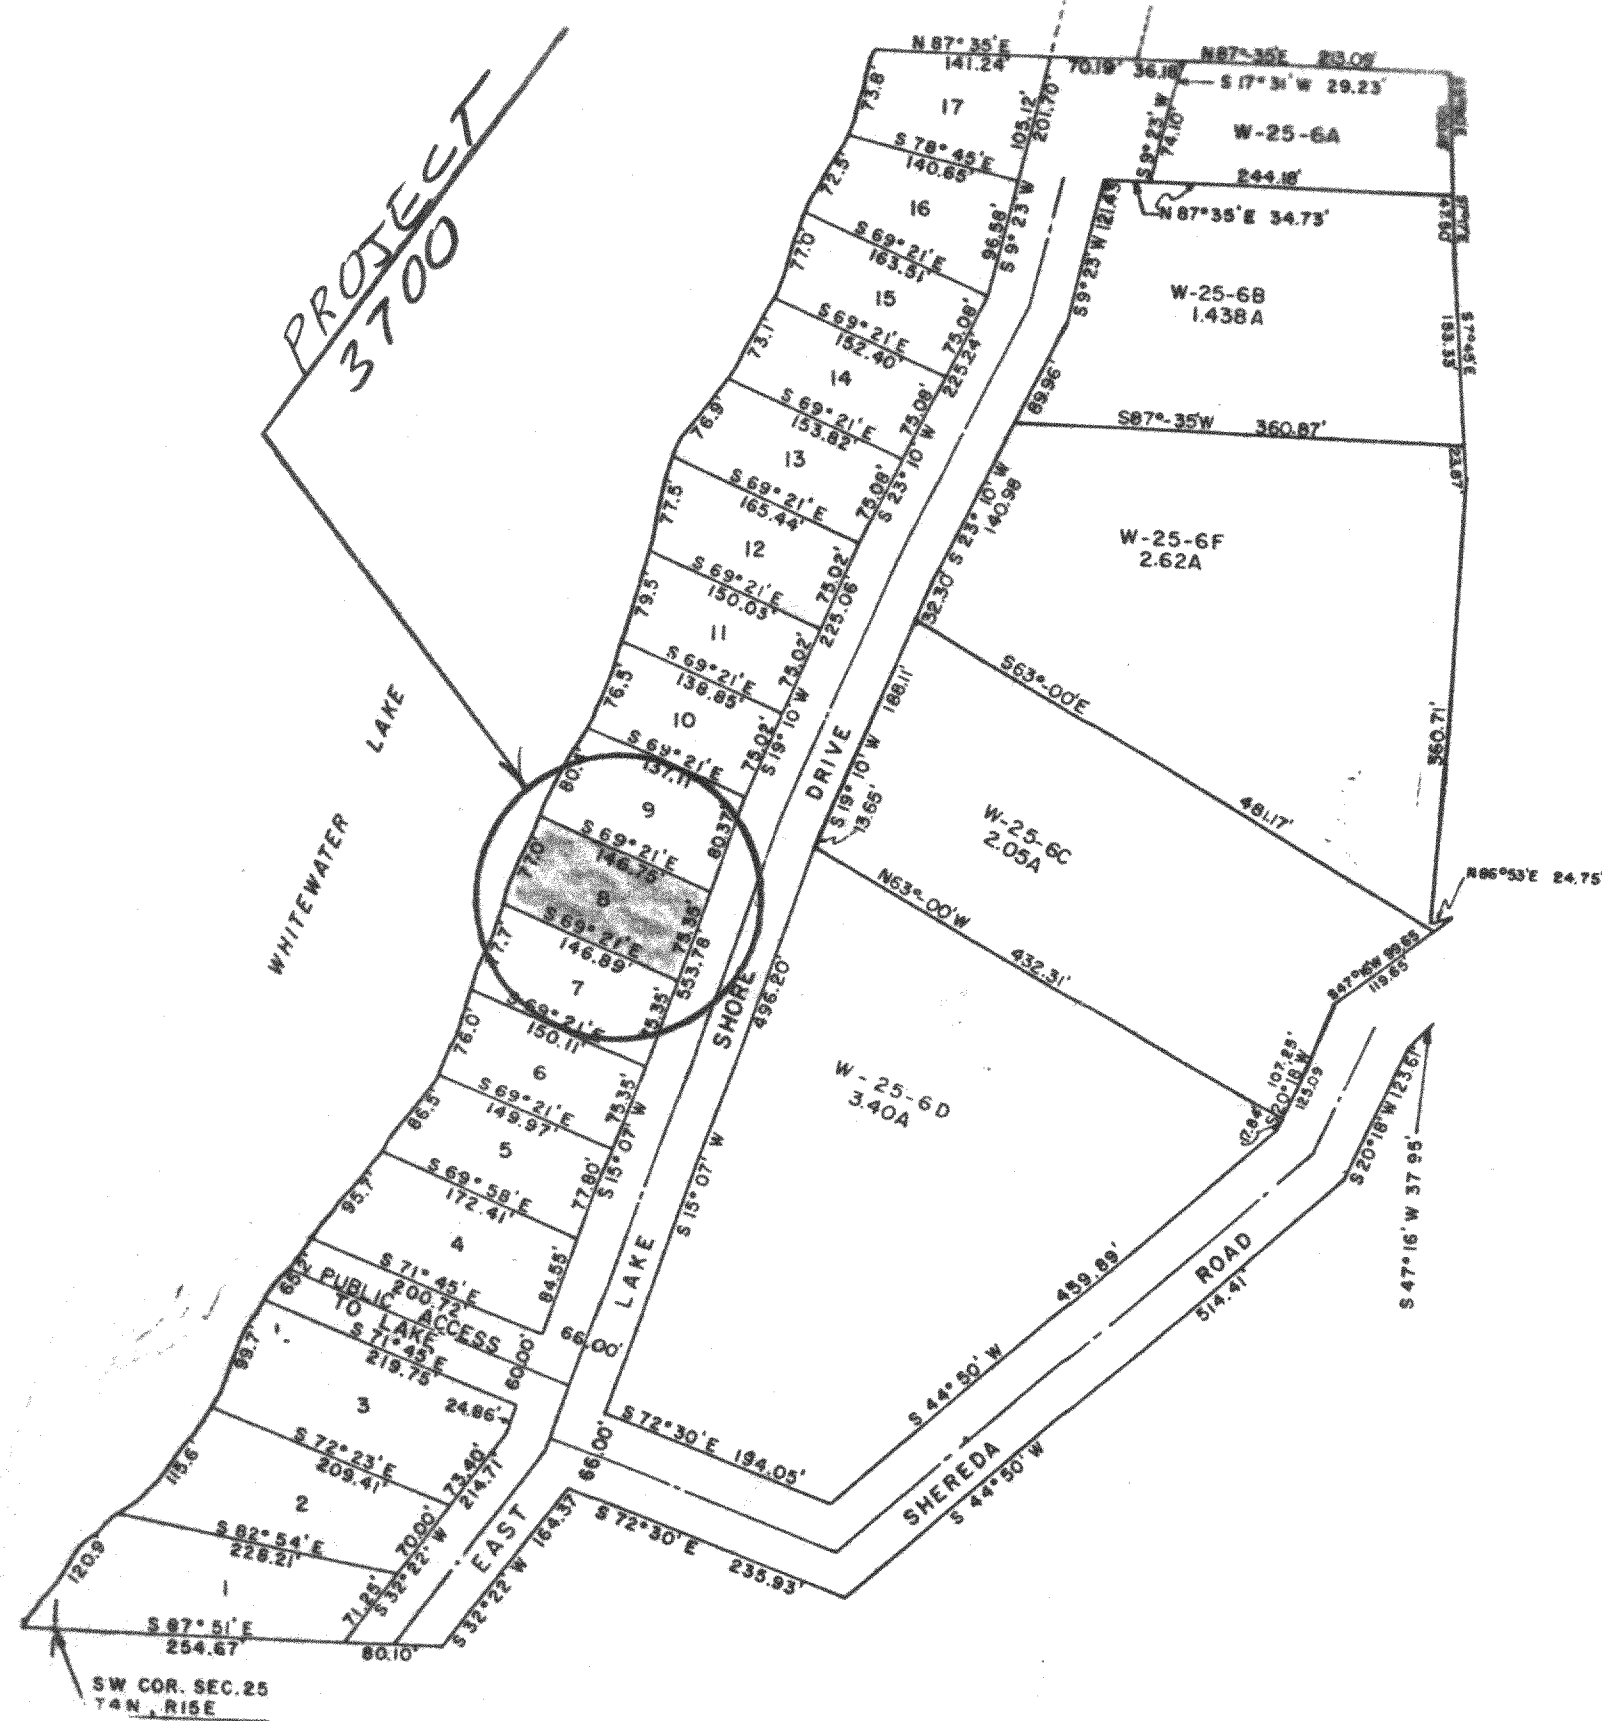



I HEREBY CERTIFY THIS PLAT TO BE A
TRUE AND ACCURATE REPRESENTATION OF THE
BOUNDARY LINES AND BUILDING LOCATIONS
TO THE BEST OF MY PROFESSIONAL KNOWLEDGE
AND BELIEF.

DATED 8/12/92

ROBERT A. FARRIS

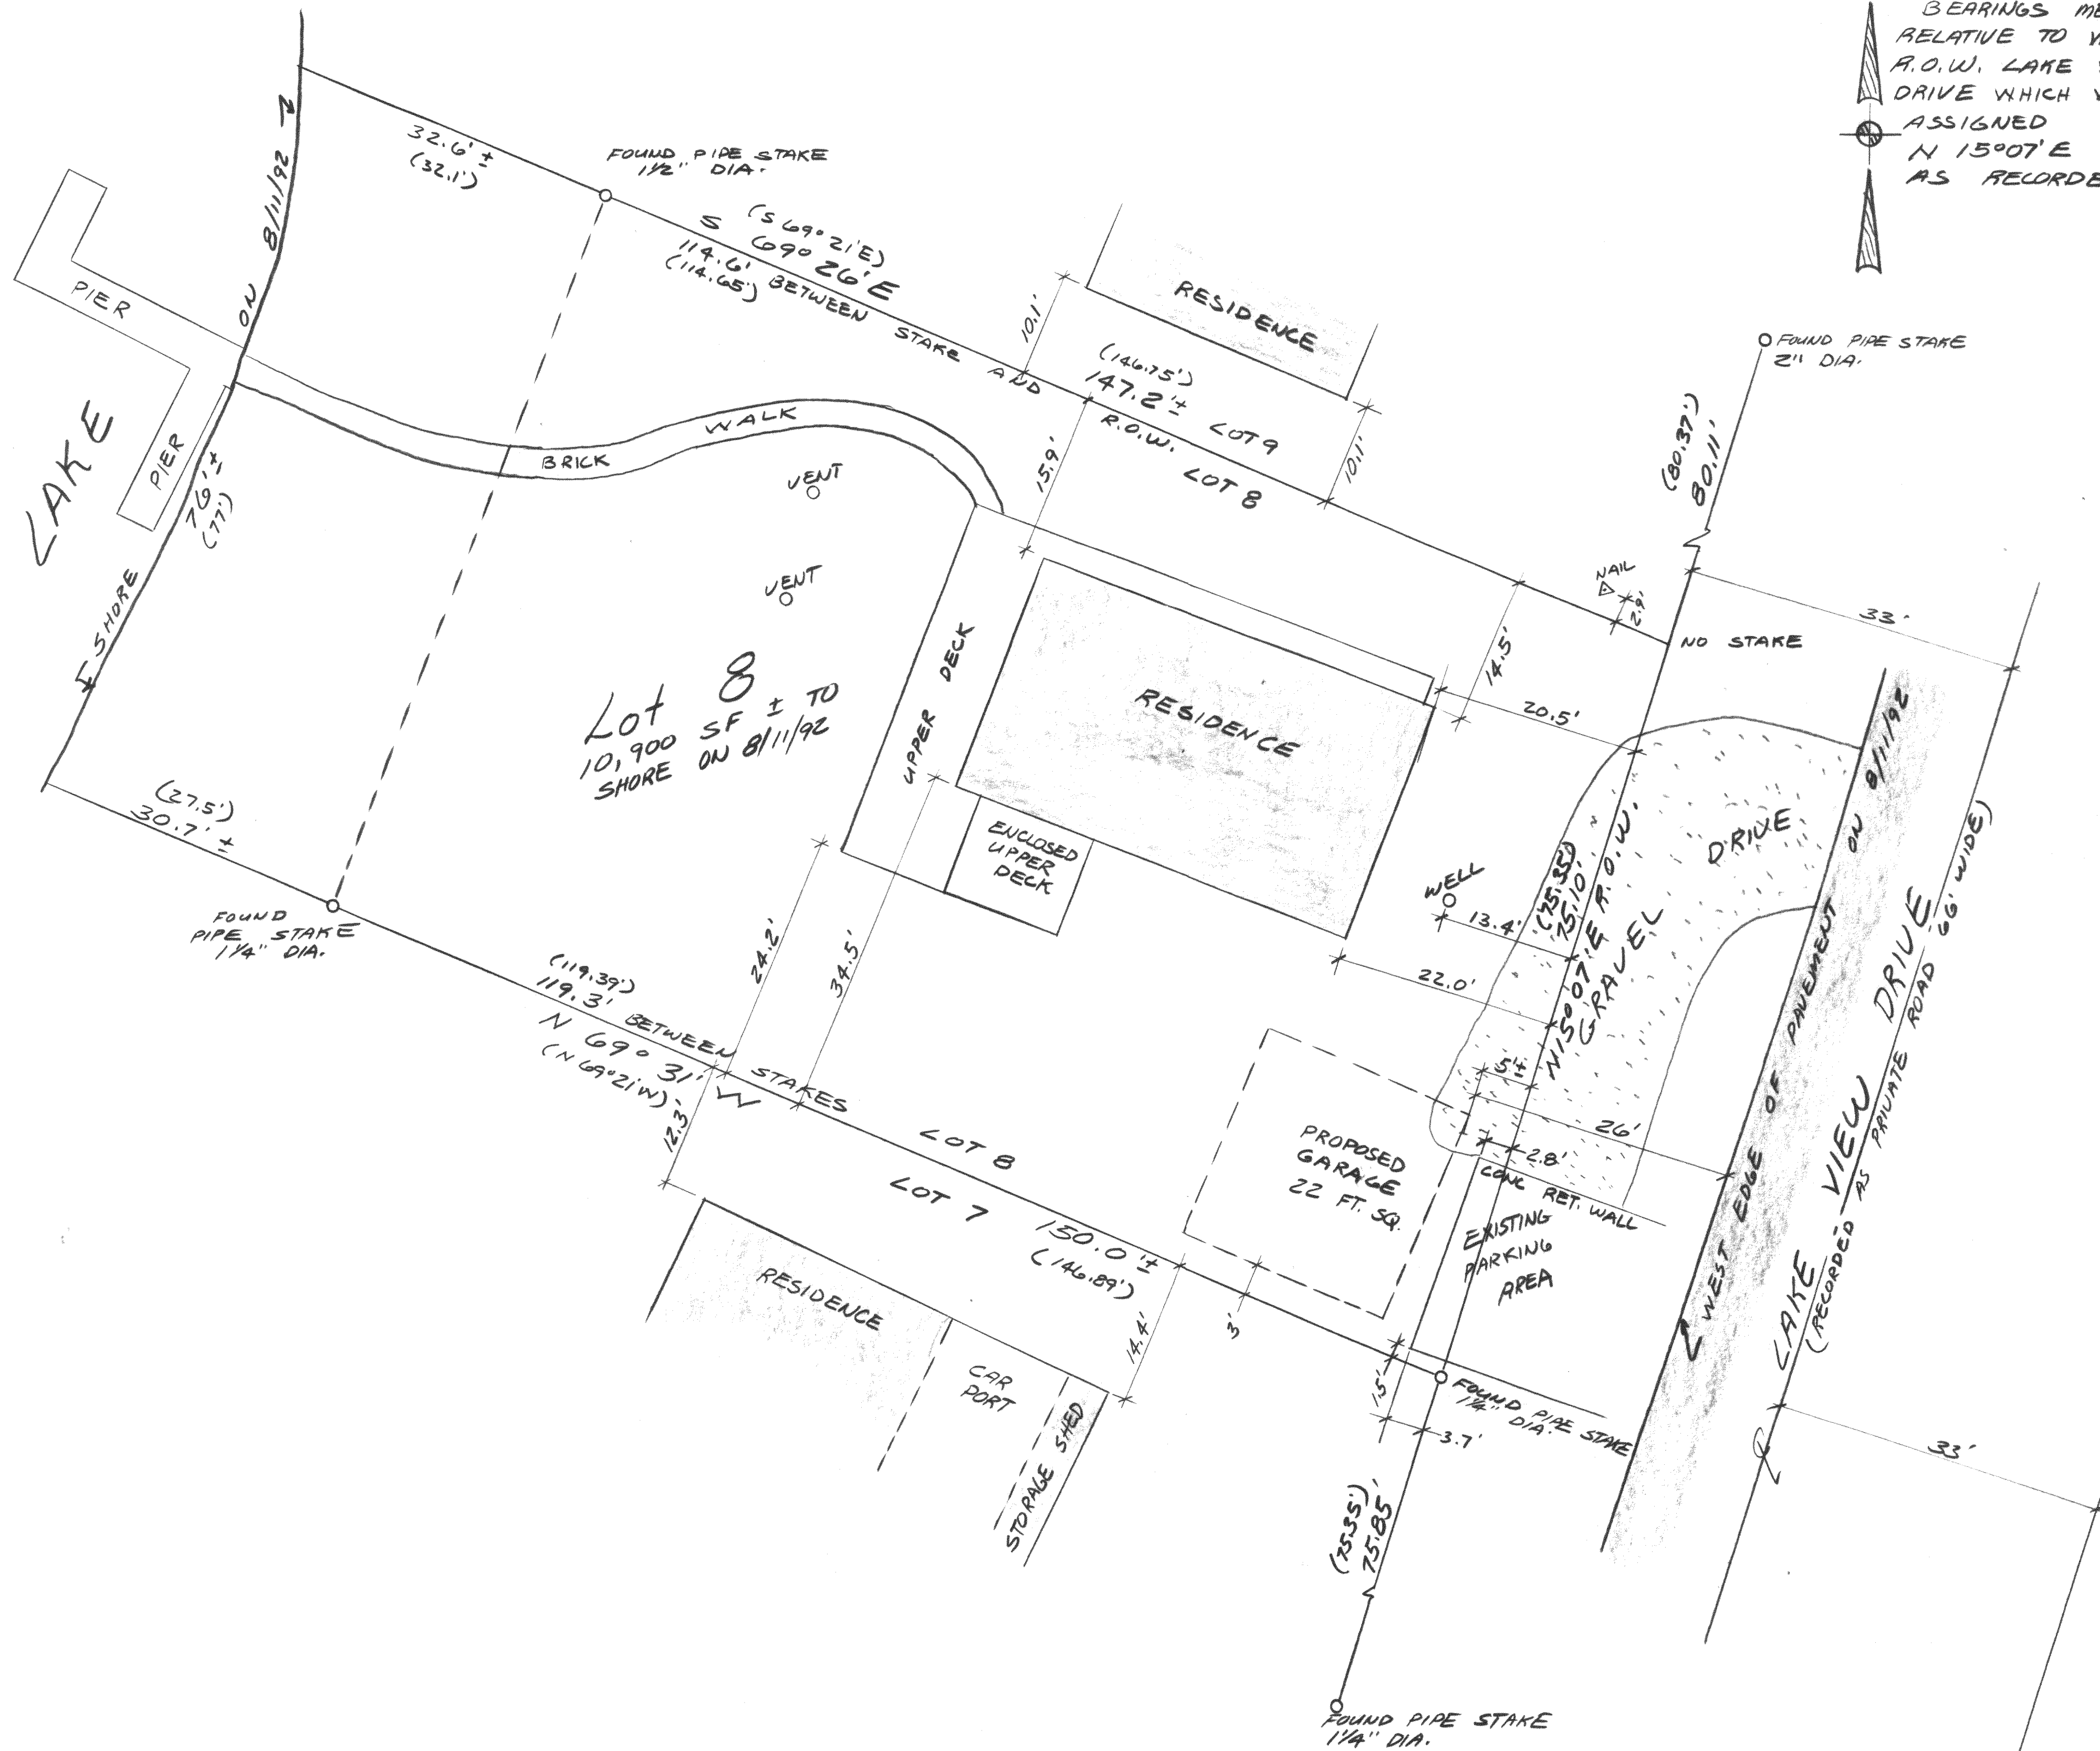

BEARINGS MEAS.
RELATIVE TO WEST
A.O.W. LAKE VIEW
DRIVE WHICH WAS
ASSIGNED
N 15°07'E
AS RECORDED

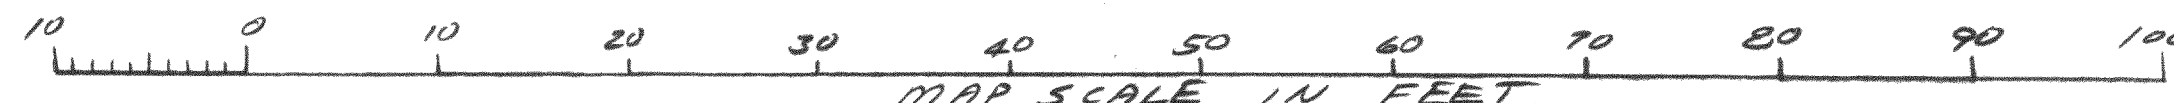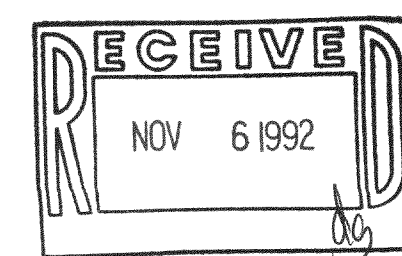

(XXX) = ORIG PLAT DIMENSION

PLAT OF SURVEY
LOT 8 SHEREDA WOODS
IN SW 1/4 25-A-15
WALWORTH CO., WI.

WORK ORDERED BY
WILLIAM SPATES FOR
APPLICATION FOR BUILDING
PERMIT FOR PROPOSED
NEW GARAGE

FARRIS, HANSEN & ASSOCIATES, INC.
Engineering, Architecture, Surveying
7 Ridgway Court P.O. Box 437
ELKHORN, WISCONSIN 53121
Office: (414) 723-2098
Fax: (414) 723-5886

REVISIONS
ORIG. 8/12/92

PROJECT NO
3700
DATE
8/12/92
SHEET NO.
1 of 1