


PLAT OF SURVEY

WHITEWATER LAKE

LOT 37 OF BLOCK 2 OF MORaine
HEIGHTS, A SUBDIVISION LOCATED IN
SECTION 26, TOWN 4 NORTH, RANGE 15
EAST, WALWORTH COUNTY, WISCONSIN.

OWNER: GEORGE RUCK JR.
N 7557 RIDGE
WHITEWATER, WI. 53190


ORDERED BY: TLC REALTY
RT. 5 BOX 5
ELKHORN, WI. 53121

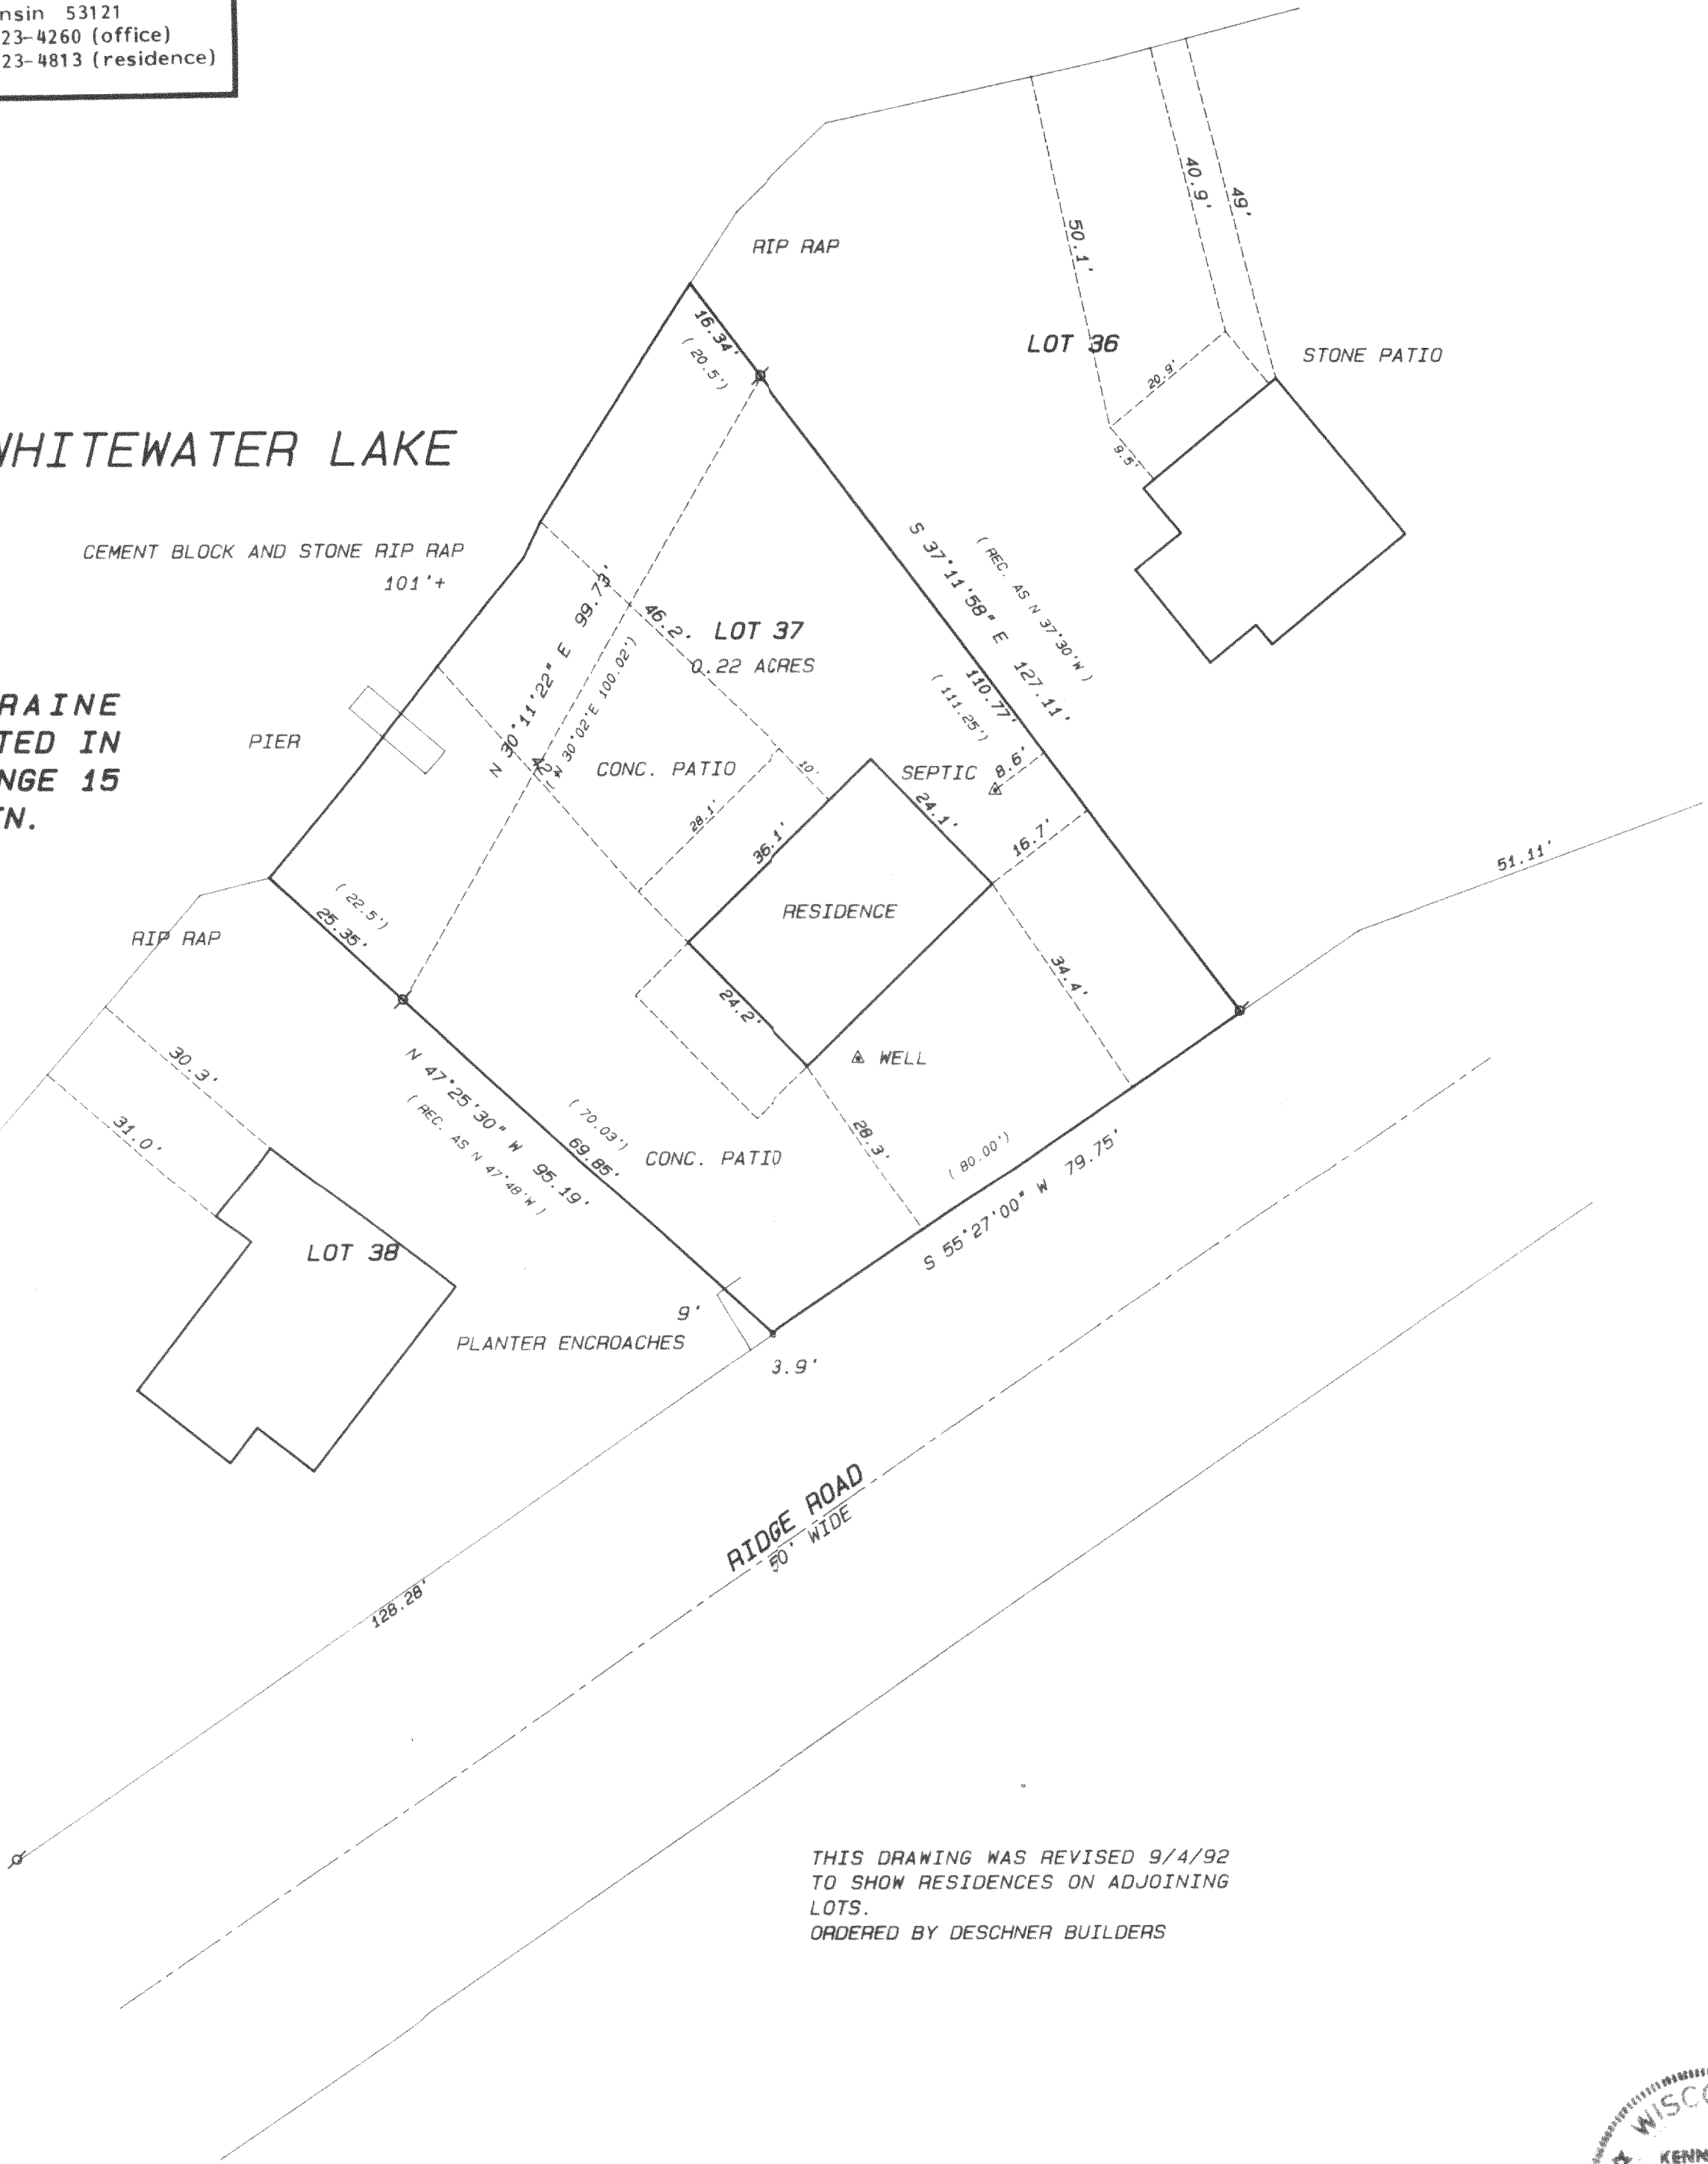

THIS DRAWING WAS REVISED 9/4/92
TO SHOW RESIDENCES ON ADJOINING
LOTS.
ORDERED BY DESCHNER BUILDERS

Legend

- FOUND IRON PIPE
- FOUND IRON ROD
- FOUND BRASS CAPPED MONUMENT
- FOUND CONCRETE MONUMENT
- CHISEL CUT IN CONCRETE
- SET IRON ROD, 24" LONG, WEIGHING 1.5 LBS./LINEAL FT., 3/4" DIA.
- SET IRON ROD, 30" LONG, WEIGHING 4.5 LBS./LINEAL FT., 1-11/16" DIA.
- (xx) RECORDED AS DIMENSION
- EXISTING FENCE

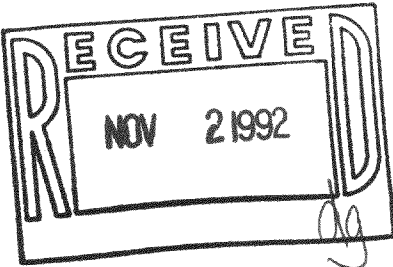

SCALE: 1" = 20 FEET

"I hereby certify that I have surveyed the above described property and that the above map is a true representation thereof and shows the size and location of the property, its exterior boundaries, the location of all visible structures and dimensions of all principal buildings thereon, boundary fences, apparent easements, roadways and visible encroachments, if any."

"This survey is made for the use of the present owners of the property, and also those who purchase, mortgage, or guarantee the title thereto within one year from date hereof."



Kenneth B. Abernathy, Jr.
KENNETH B. ABERNATHY, JR.
WISCONSIN REGISTERED LAND SURVEYOR,
S-1594
Date: 9/4/92 Job No. 92604

ABERNATHY and ASSOCIATES
Kenneth B. Abernathy Jr.
Wisconsin Registered Land Surveyor **S-1594**



Rt. 3, Box 273
Elkhorn, Wisconsin 53121
Phone: (414) 723-4260 (office)
(414) 723-4813 (residence)

PLAT OF SURVEY


**LOT 37 OF BLOCK 2 OF MORaine
HEIGHTS, A SUBDIVISION LOCATED IN
SECTION 26, TOWN 4 NORTH, RANGE 15
EAST, WALWORTH COUNTY, WISCONSIN.**

**OWNER: GEORGE RUCK JR.
N 7557 RIDGE
WHITEWATER, WI. 53190**


**ORDERED BY: TLC REALTY
RT. 5 BOX 5
ELKHORN, WI. 53121**

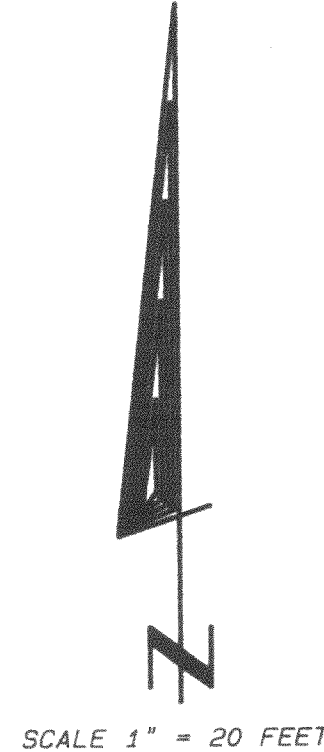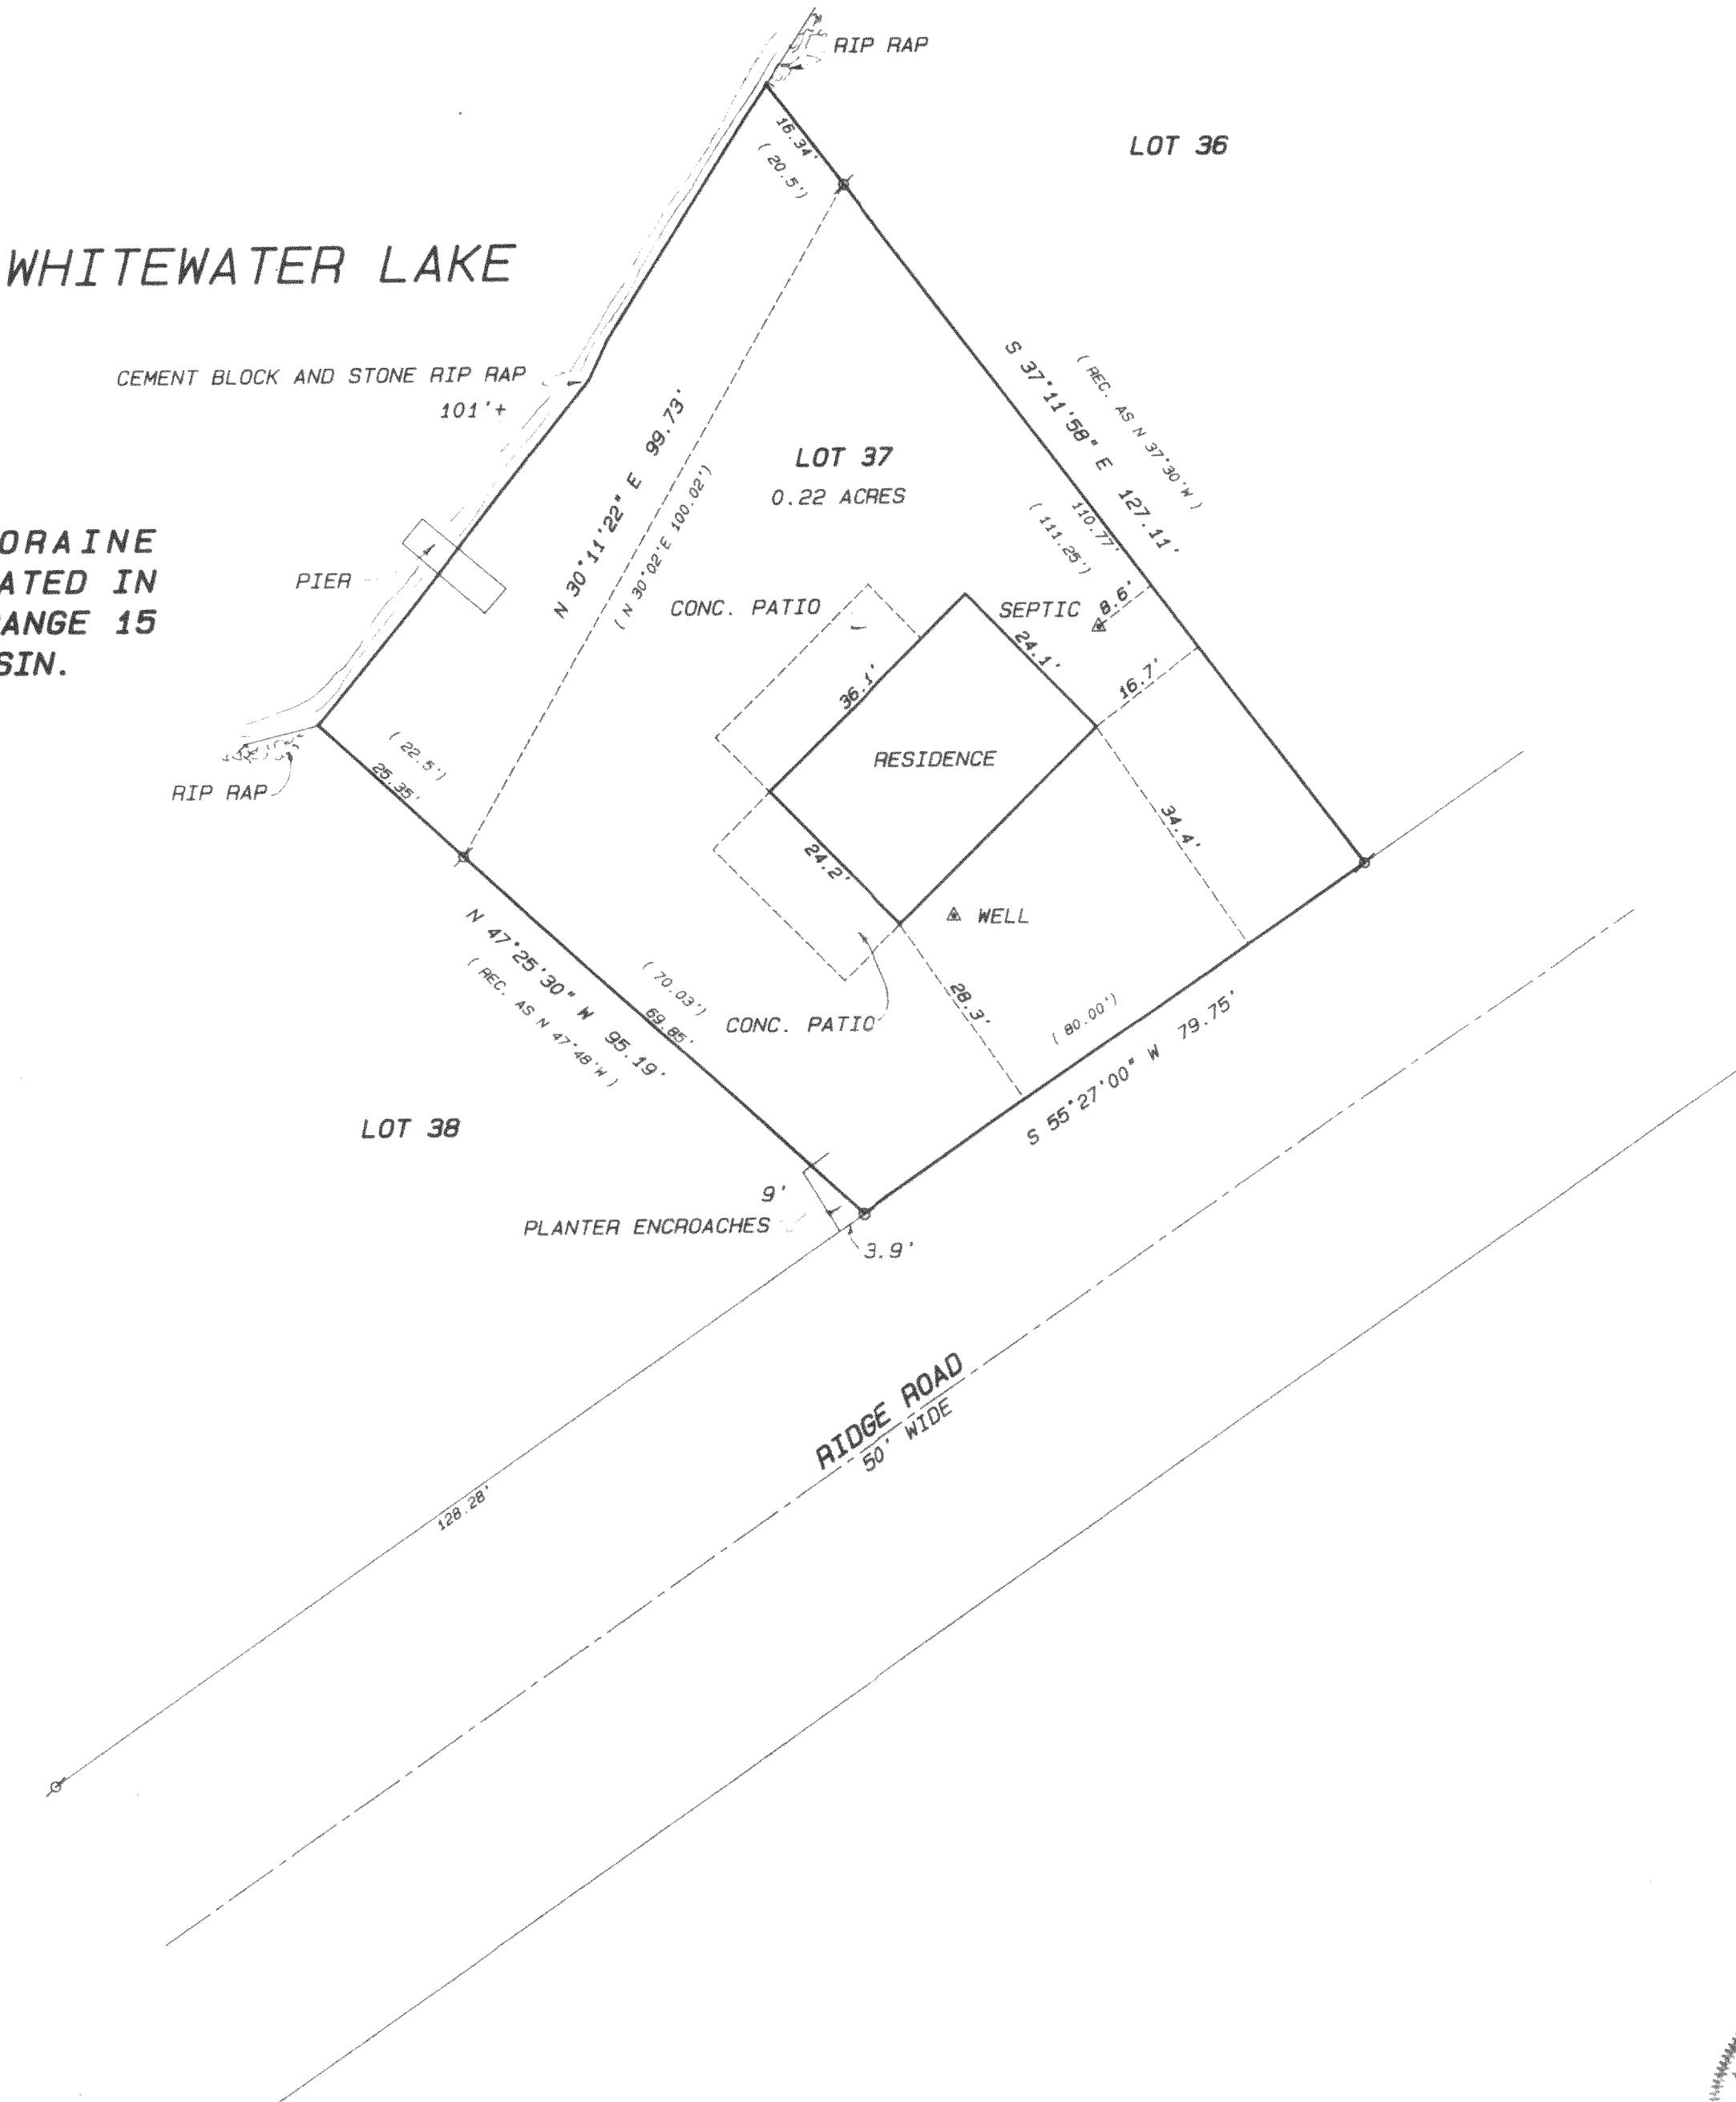

- Legend**
- ✕ FOUND IRON PIPE
 - FOUND IRON ROD
 - FOUND BRASS CAPPED MONUMENT
 - FOUND CONCRETE MONUMENT
 - + CHISEL CUT IN CONCRETE
 - SET IRON ROD, 24" LONG, WEIGHING 1.5 LBS./LINEAL FT., 3/4" DIA.
 - SET IRON ROD, 30" LONG, WEIGHING 4.5 LBS./LINEAL FT., 1-11/16" DIA.
 - (xx) RECORDED AS DIMENSION
 - x-x- EXISTING FENCE

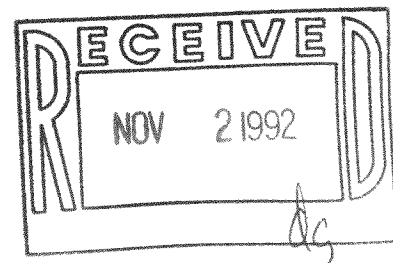

SCALE: 1" = 20 FEET

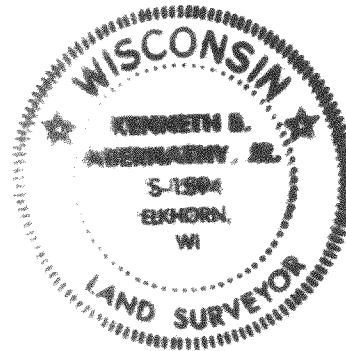

"I hereby certify that I have surveyed the above described property and that the above map is a true representation thereof and shows the size and location of the property, its exterior boundaries, the location of all visible structures and dimensions of all principal buildings thereon, boundary fences, apparent easements, roadways and visible encroachments, if any."

"This survey is made for the use of the present owners of the property, and also those who purchase, mortgage, or guarantee the title thereto within one year from date hereof."

Kenneth B. Abernathy Jr.
KENNETH B. ABERNATHY, JR.
WISCONSIN REGISTERED LAND SURVEYOR
S-1594
Date: JUNE 22, 1992 Job No. 92.604