


PLAT OF SURVEY

of

LOT 4, BLOCK 1 OF MINNIESKA SUBDIVISION, LOCATED IN SECTION 35,
TOWN 4 NORTH, RANGE 15 EAST, TOWN OF WHITEWATER, WALWORTH
COUNTY, WISCONSIN


SURVEYED FOR: WALTON CREECH
86 TOMAHAWK
OSWEGO, IL 60543

BEARINGS REFERENCED TO THE
RECORDED SUBDIVISION PLAT

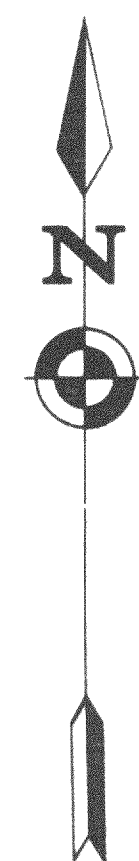

Mapping date: 4-16-92
Revisions: APRIL 29, 1992
415-345

Scale: 1" = 20'
0 20 40 60

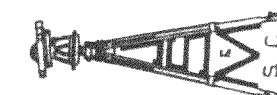


JENSEN SURVEYING & MAPPING S.C.
45 South Wisconsin Street P.O. Box 322
Elkhorn, Wisconsin 53121
(414) 723-3434

Legend
○ - FOUND IRON PIPE
+ - ELEV AT STRUCTURE CORNER
x - SPOT ELEVATION
x - POWER POLE
() - RECORDED DIMENSION

Sheet no. 1 of 1 Sheets
Job reference number 1992-056
1992-056

DM-4

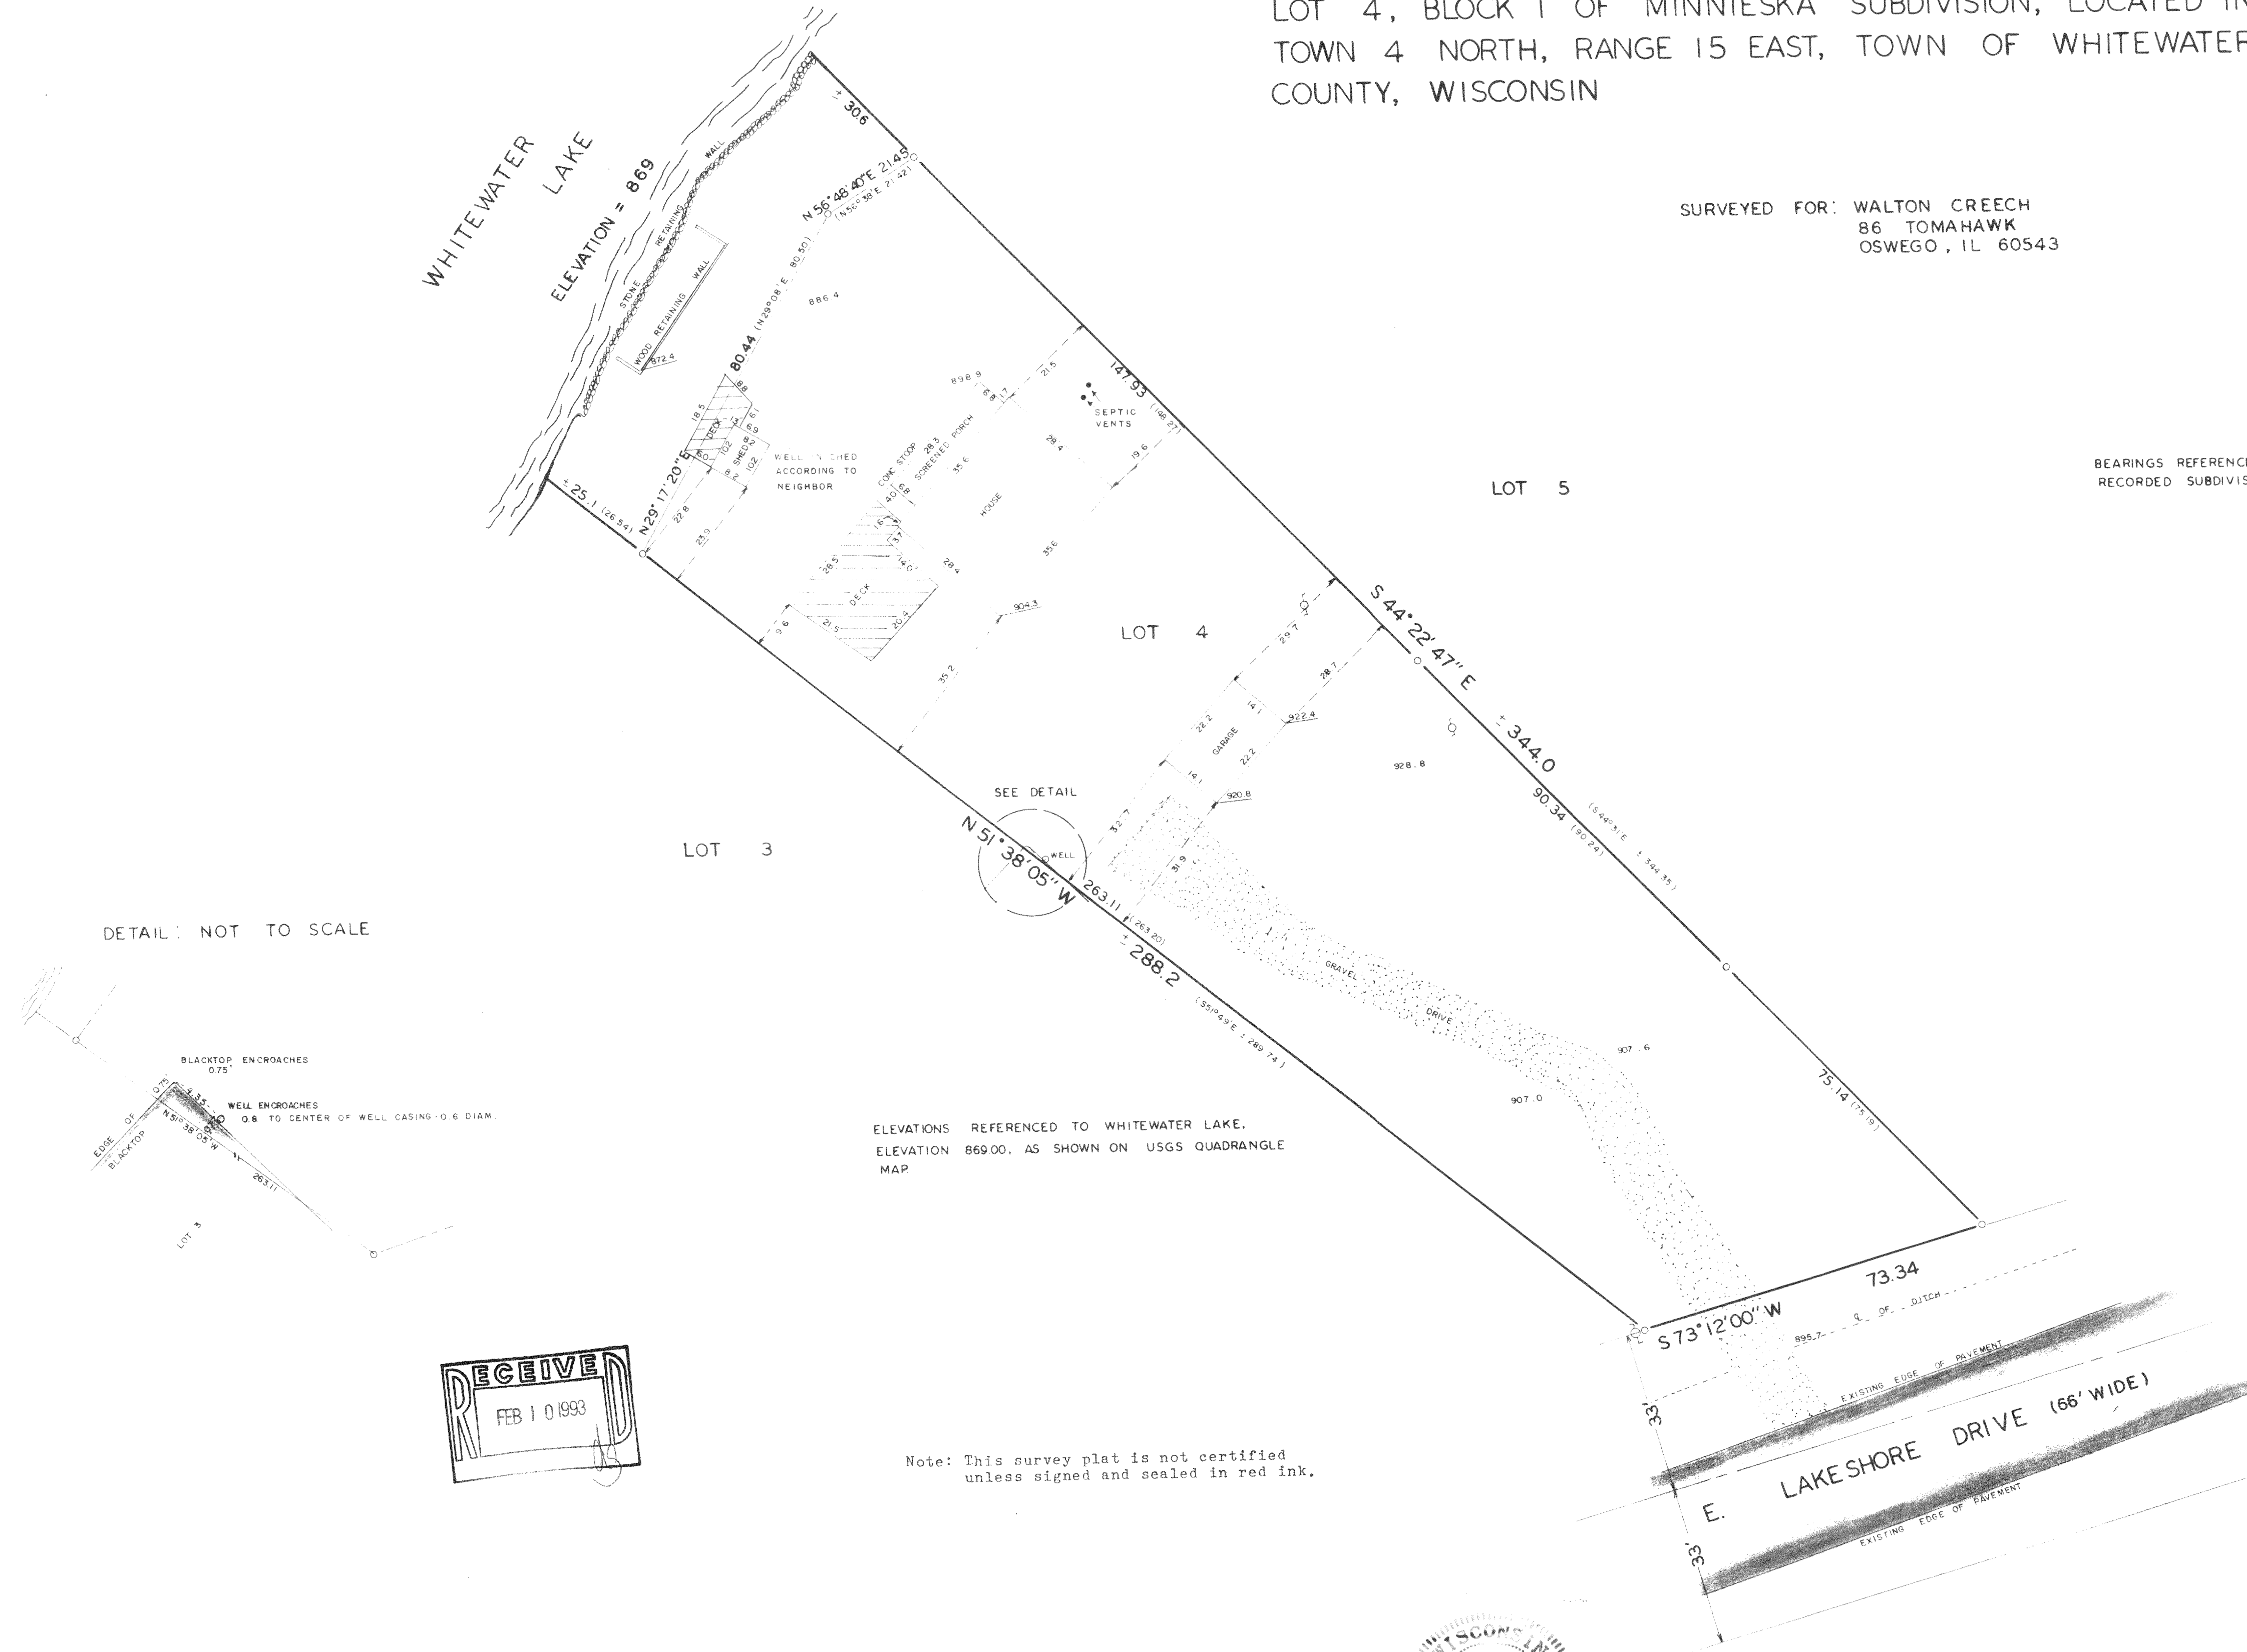


ELEVATIONS REFERENCED TO WHITEWATER LAKE.
ELEVATION 869.00, AS SHOWN ON USGS QUADRANGLE
MAP

Note: This survey plat is not certified
unless signed and sealed in red ink.

I, Thomas P.A. Jensen, Wisconsin Registered Land Surveyor,
do hereby certify that this survey was performed by me, or under
my direction, in full compliance with the owner's/agent's instru-
ctions and Chapter A-E 7 of the Wisconsin Administrative Code
"Minimum Standards For Property Surveys"; and that this map is
an accurate representation thereof to the best of my knowledge
and belief.

Thomas P.A. Jensen R.L.S-1084
Jensen Surveying & Mapping S.C.

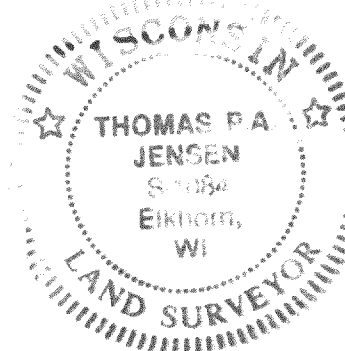

Copyright © 1992 by Jensen Surveying & Mapping S.C.
All rights reserved. No part of this survey plat may be
reproduced or transmitted in any form by any means - graphic,
electronic, or mechanical, including photocopying, tracing, or
information storage and retrieval systems - without permission in
writing from Thomas P.A. Jensen, Jensen Surveying & Mapping S.C.