


Plat of Survey

of

LOT 36 OF SCATTERED OAKS, A SUBDIVISION LOCATED IN THE SW 1/4 OF SECTION 36 AND THE SE 1/4 OF SECTION 35, T 4 N, R 15 E, WALWORTH COUNTY, WISCONSIN

Surveyed for: ED McCULLEY - SCANDIA REALTY
312 S. 7th
DELAVAN, WI 53115


BEARINGS REFERENCED TO THE NORTH LINE OF LITTLE ACORN ROAD RECORDED AS WEST IN THE SUBDIVISION PLAT

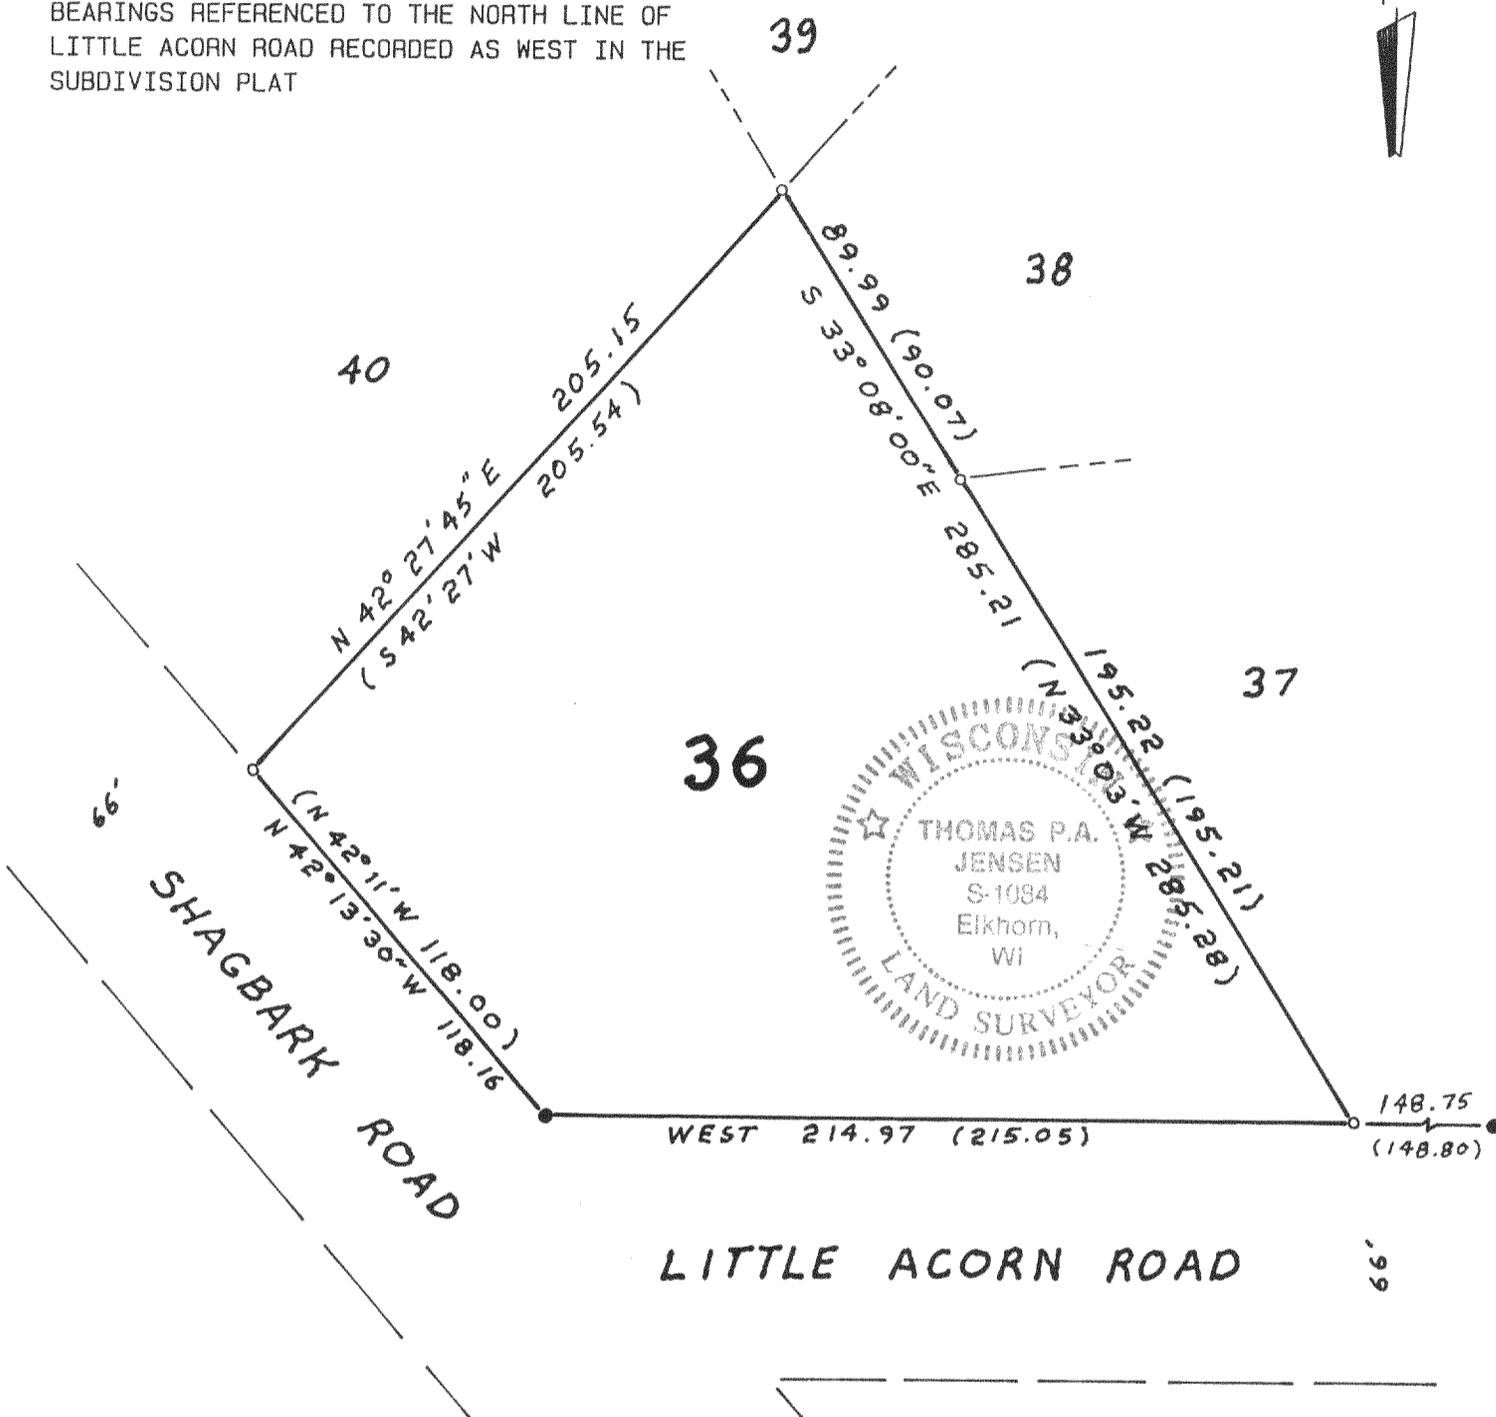

Copyright © 1992 by Jensen Surveying & Mapping S.C.
All rights reserved. No part of this survey plat may be reproduced or transmitted in any form by any means - graphic, electronic, or mechanical, including photocopying, tracing, or information storage and retrieval systems - without permission in writing from Thomas P.A. Jensen.

I, Thomas P.A. Jensen, Wisconsin Registered Land Surveyor, do hereby certify that this survey was performed by me, or under my direction, in full compliance with the owner's/agent's instructions and Chapter A-E 7 of the Wisconsin Administrative Code ' Minimum Standards For Property Surveys ', and that this map is an accurate representation thereof to the best of my knowledge and belief.

Note: This survey plat is not certified unless signed and sealed in red ink.

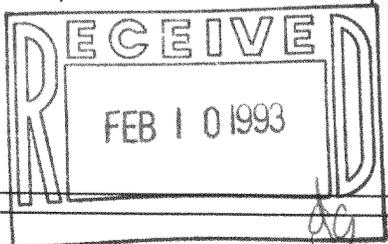

Thomas P.A. Jensen
Thomas P.A. Jensen R.L.S. 1084

Jensen Surveying & Mapping S.C.

45 South Wisconsin Street P.O. Box 322
Elkhorn, Wisconsin, 53121.
(414) 723-3434

Mapping date: MAY 8, 1992

Revisions: 415-368

- Legend
- Found iron rod, 1" dia.
 - Found iron rod, 3/4" dia.
 -) Recorded as dimension

Scale: 1 = 50'



Sheet 1 of 1 Sheets

Job reference number:
1992.064

DSO-36