


ABELL
SURVEYING & MAPPING
DELAVER, WISCONSIN 53115
414-728-6737

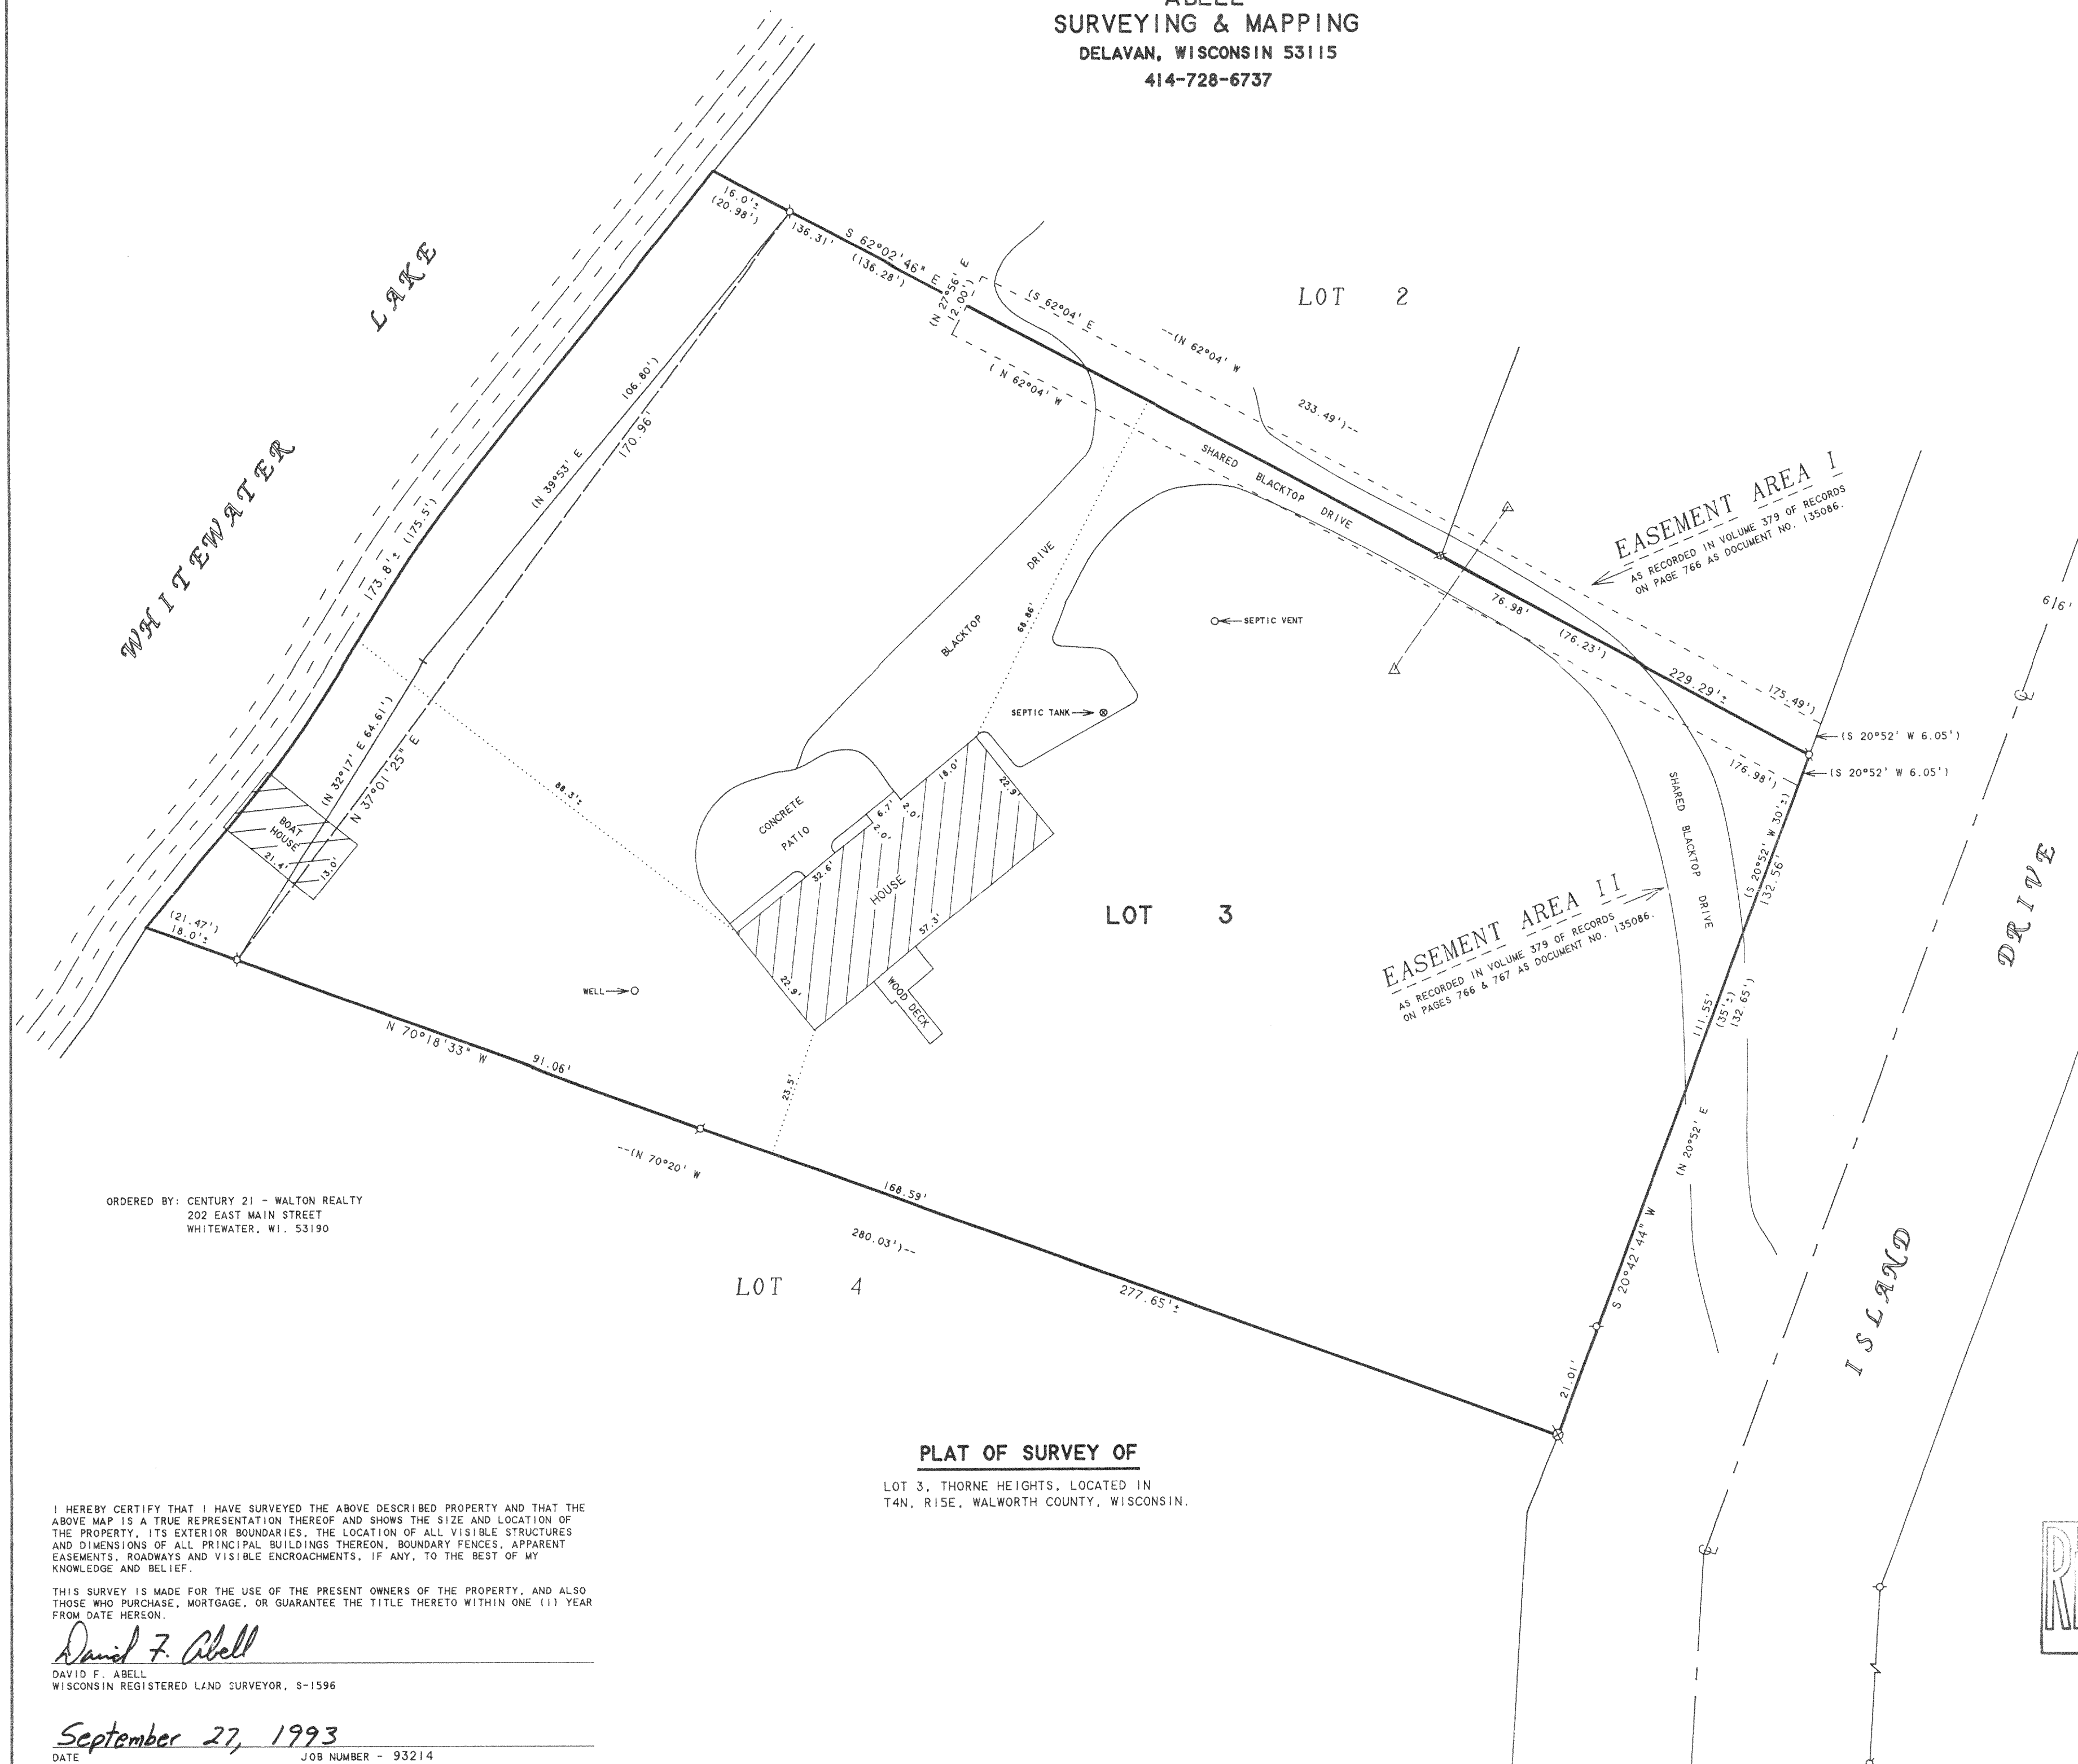

NOTE: BEARINGS ARE REFERENCED TO THE
RECORDED SUBDIVISION PLAT.



SCALE 1"=20'

LEGEND

-  -IRON PIPE FOUND
 -PK NAIL FOUND
 -LARGE SPIKE FOUND
 -UTILITY POLE
 _____ -OVERHEAD UTILITY LINES
 () -RECORDED AS

RECEIVED
JAN 26 1994

415-404