


Wisconsin Registered Land Surveyor S-1594

Rt. 3, Box 273
Elkhorn, Wisconsin 53121
Phone: (414) 723-4260 (office)
(414) 723-4813 (residence)

PLAT OF SURVEY

LOT 4 OF BLOCK 1 OF MORAIN HEIGHTS SUBDIVISION,
LOCATED IN THE SOUTHWEST 1/4 OF THE SOUTHEAST 1/4
OF SECTION 26, AND THE NORTHWEST 1/4 OF SECTION
35, AND THE NORTHEAST 1/4 OF SECTION 35, AND THE
SOUTHEAST 1/4 OF SECTION 35, TOWN 4 NORTH, RANGE
15 EAST, WALWORTH COUNTY, WISCONSIN AS RECORDED IN
THE REGISTER OF DEEDS OFFICE IN AND FOR THE COUNTY
OF WALWORTH, ON THE 20th DAY OF OCTOBER, 1948 IN
VOL. 12 OF PLATS ON PAGE 19, 20 AND 21.

OWNERS: DAVID, ROBERT AND KATHLEEN RANSFORD
C/O DAVID RANSFORD
2409 HASTINGS AVE.
EVANSTON, IL. 60201

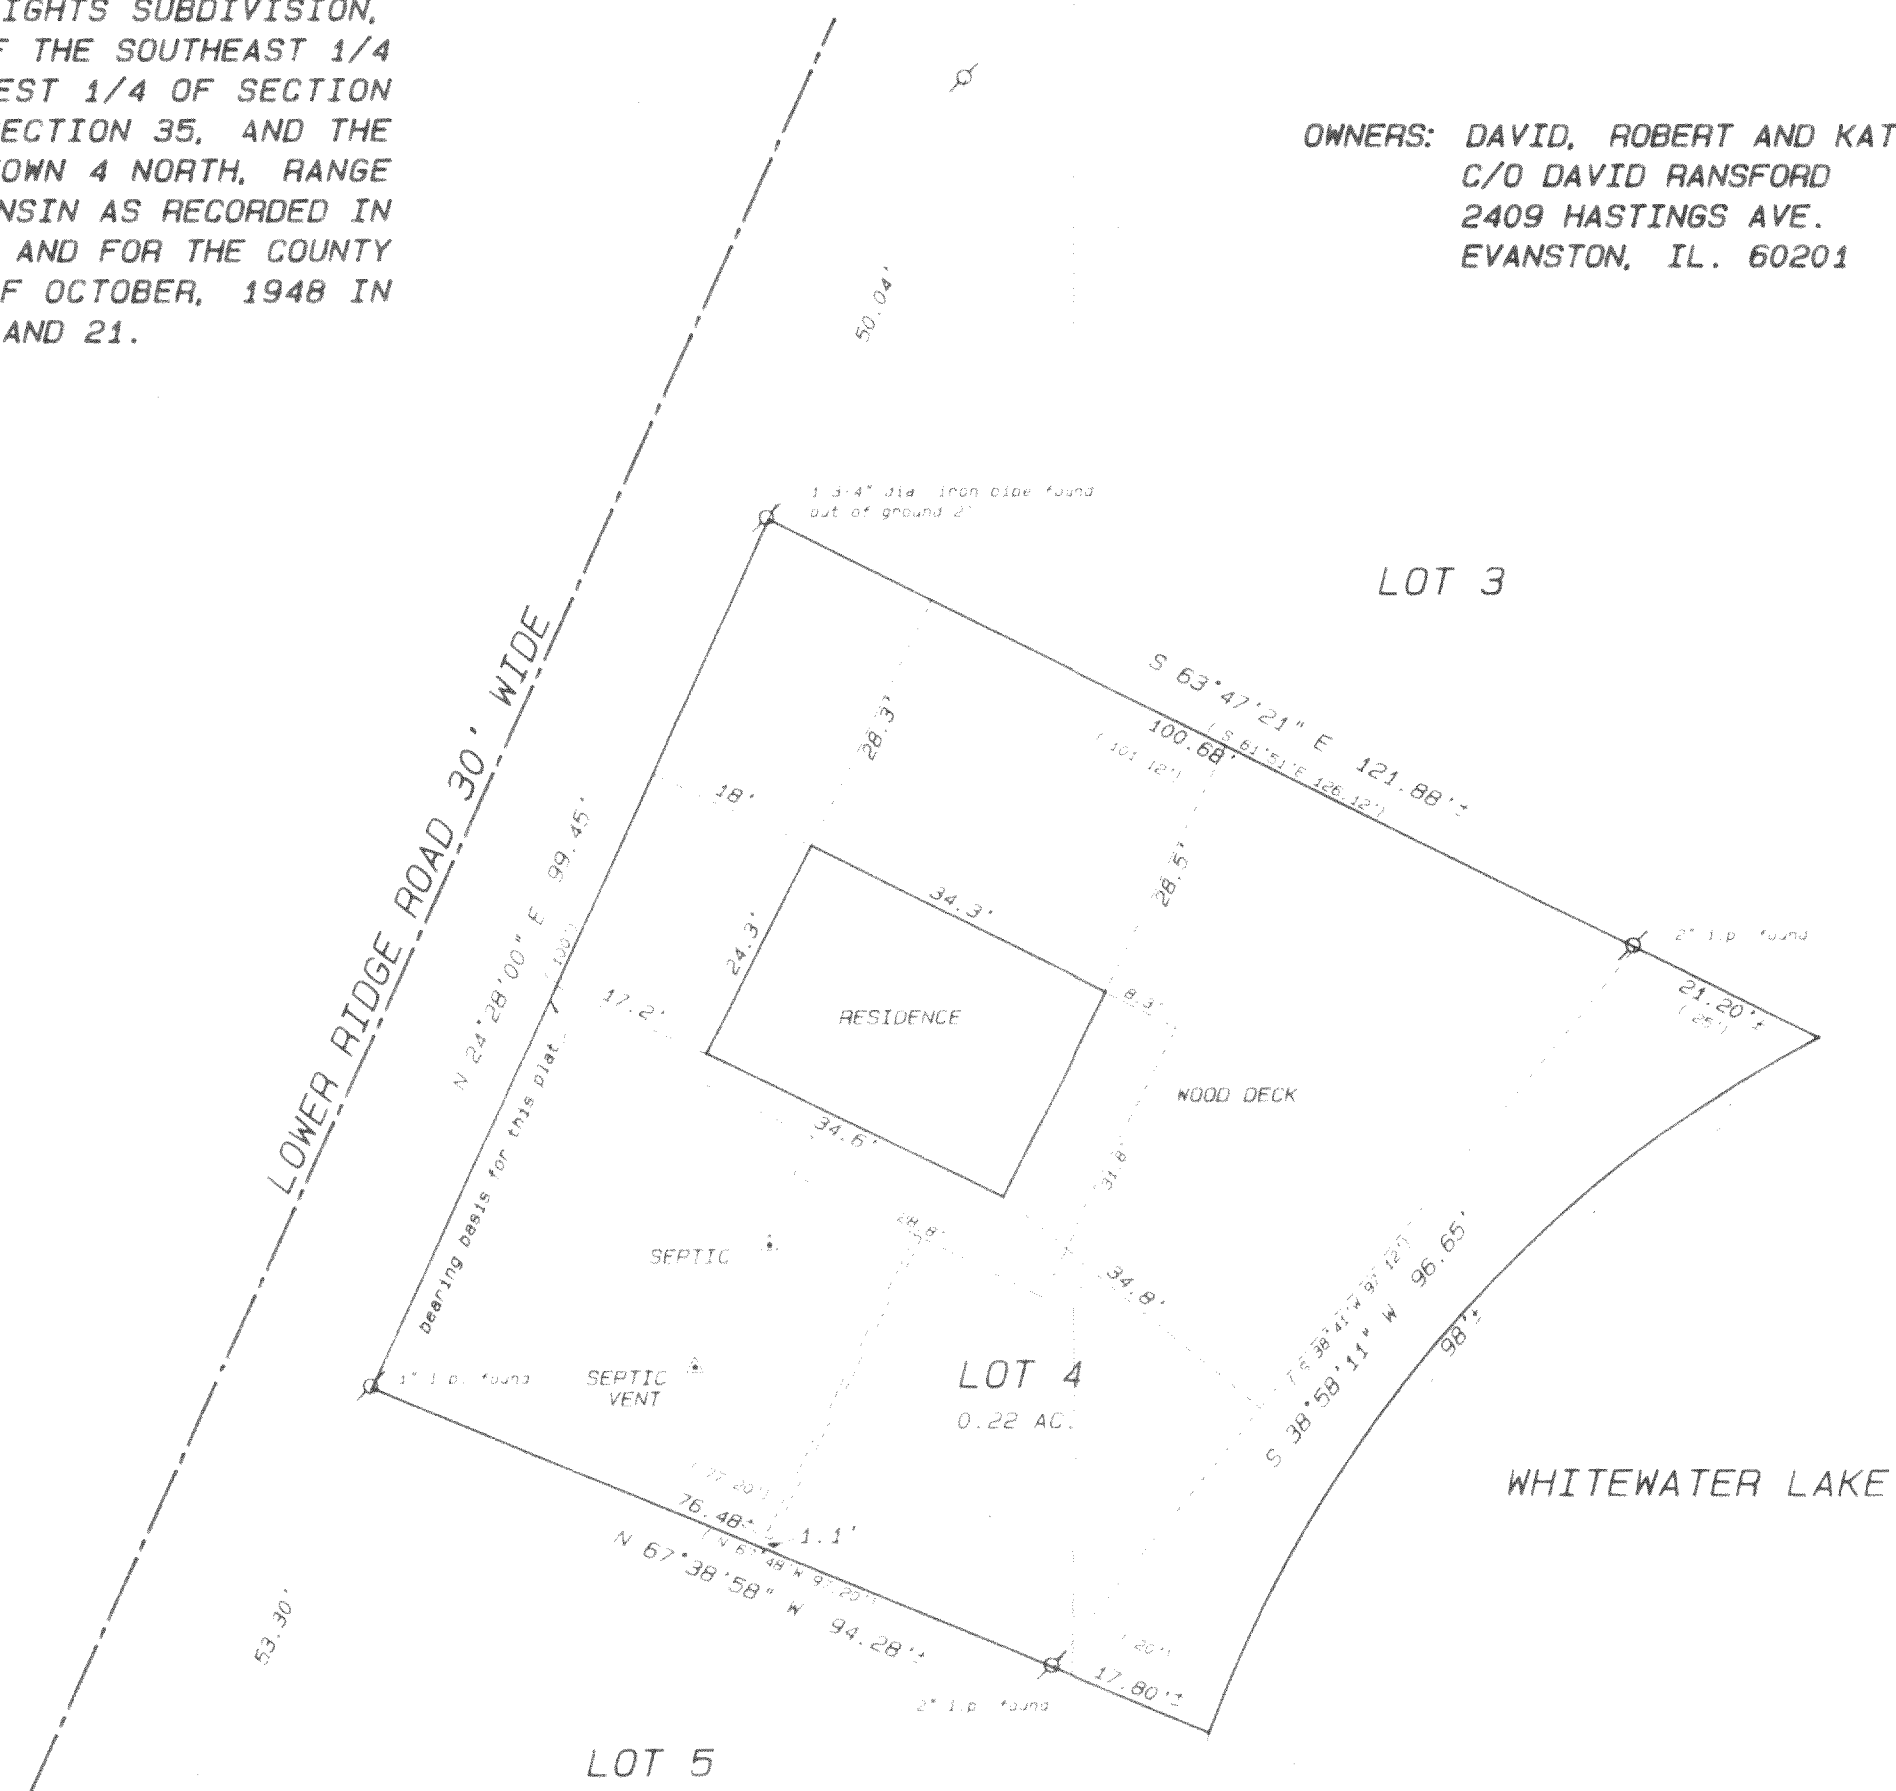

Legend

- FOUND IRON PIPE
- FOUND IRON ROD
- FOUND BRASS CAPED MONUMENT
- ✕ FOUND CONCRETE MONUMENT
- ✕ CHISEL CUT IN CONCRETE
- SET IRON ROD 14' LONG, WEIGHING 15 LBS. LINEAL FT. 1 1/2" DIA.
- SET IRON ROD 10' LONG, WEIGHING 45 LBS. LINEAL FT. 1 1/2" DIA.
- RECORDED AS DIMENSION
- ✕ EXISTING FENCE

RECEIVED
JAN 21 1994
Jen

SCALE: 1" = 50 FEET

I hereby certify that I have surveyed the above described property and that the above map is a true representation thereof and shows the size and location of the property, its exterior boundaries, the location of all visible structures and dimensions of all principal buildings thereon, boundary fences, apparent easements, roadways and visible encroachments, if any.

This survey is made for the use of the present owners of the property and shall not affect those who purchase, mortgage or guarantee the title thereto within one year from date hereof.

Kenneth B. Abernathy, Jr.
KENNETH B. ABERNATHY, JR.
WISCONSIN REGISTERED LAND SURVEYOR,
S-1594

Date: Jan. 3, 1994 Job No. 94104

415-405

DMH-4