



PLAT OF SURVEY

Lot 8 of Block 4 of Moraine Heights Subdivision, located in part of the Southeast 1/4 of Section 26 and part of the Southwest 1/4 of Section 26 and part of the Northwest 1/4 of Section 35 and part of the Northeast 1/4 of Section 35 and part of the Southwest 1/4 of Section 35, Town 4 North, Range 15 East, Town of Whitewater, County of Walworth, State of Wisconsin.

Whitewater Lake

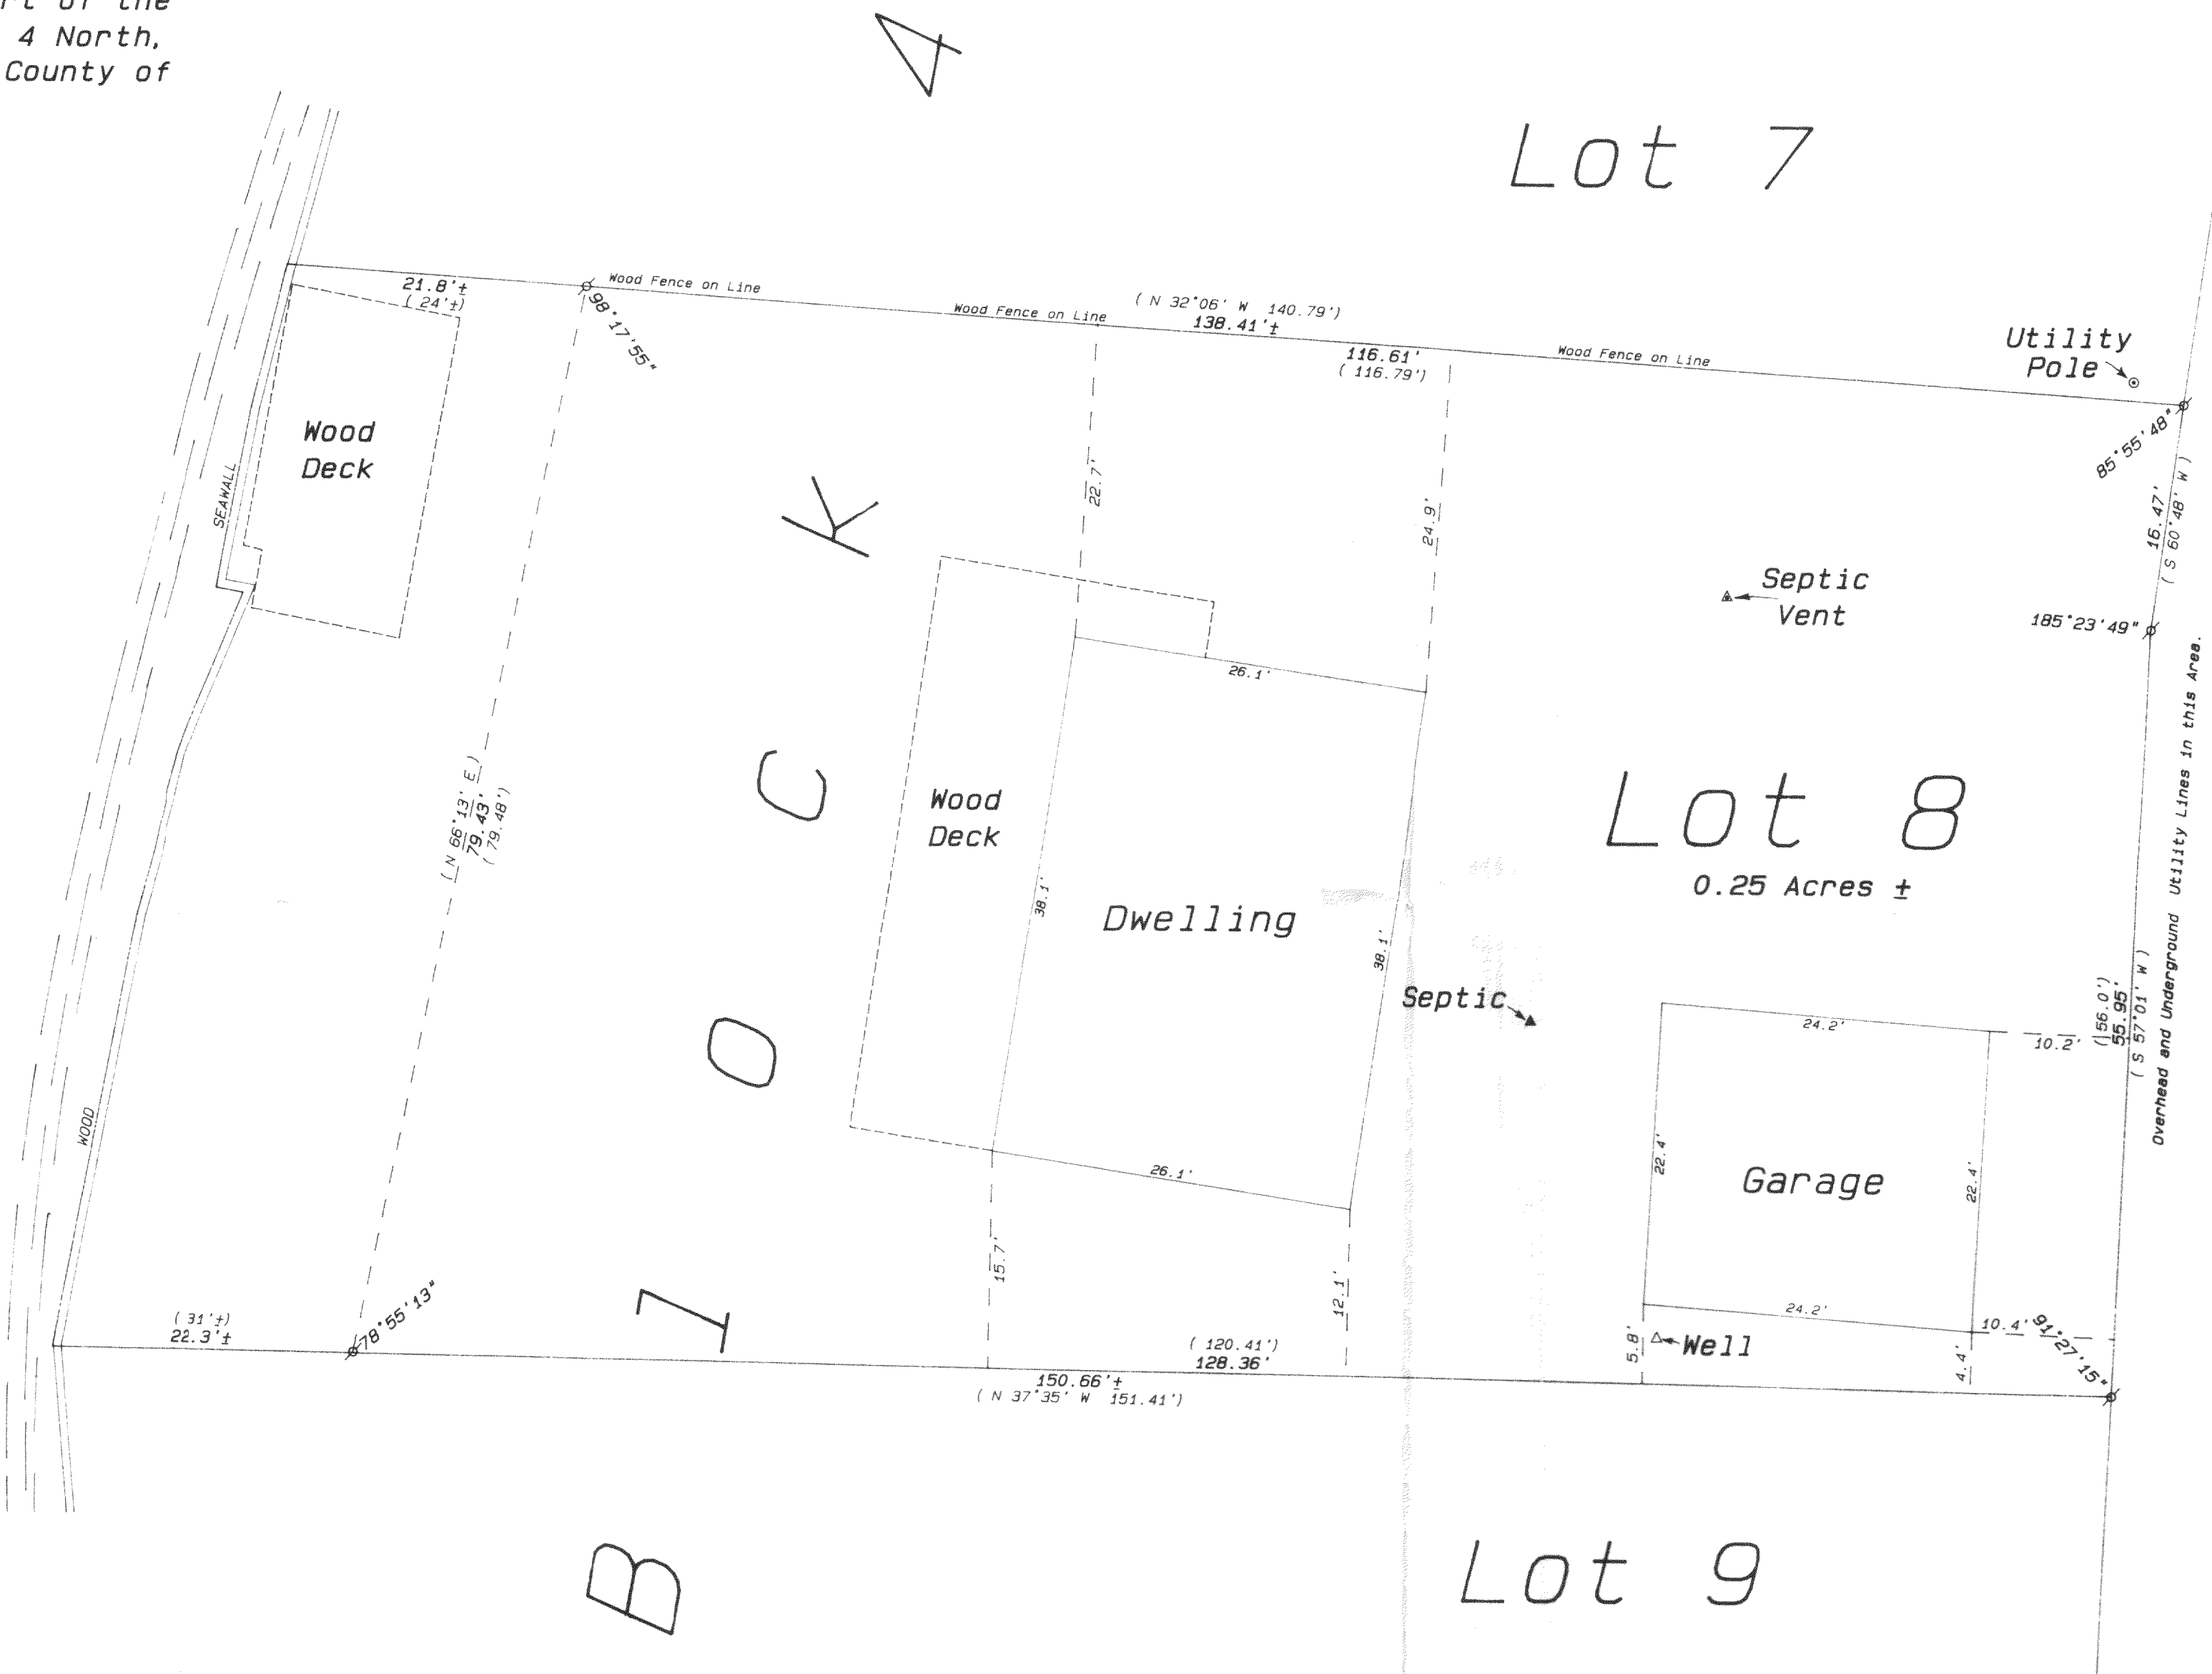

Ordered by: Charles Pease
2 Headwater Cove
South Barrington, Illinois
60010

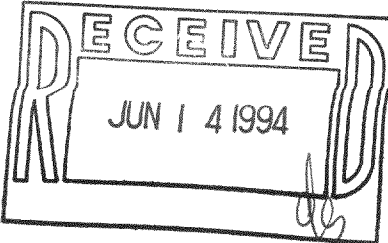

- Legend
- FOUND IRON PIPE
 - FOUND IRON ROD
 - FOUND BRASS CAPPED MONUMENT
 - FOUND CONCRETE MONUMENT
 - CHISEL CUT IN CONCRETE
 - SET IRON ROD, 24" LONG, WEIGHING 1.5 LBS., LINEAL FT. 3" DIA.
 - SET IRON ROD, 18" LONG, WEIGHING 4.5 LBS., LINEAL FT. 1-11/16" DIA.
 - RECORDED AS DIMENSION
 - EXISTING FENCE



SCALE: 1"= 10 FEET

I hereby certify that the above described property has been surveyed by me or under my direction and that the above map is a true representation thereof and shows the size and location of the property, its exterior boundaries, the location of all visible structures and easements, roadways and visible encroachments, if any. This survey is made for the use of the present owners of the property, and also those who purchase, mortgage, or guarantee the title thereto within one year from date hereof.

Kenneth B. Abernathy, Jr.
KENNETH B. ABERNATHY, JR.
WISCONSIN REGISTERED LAND SURVEYOR
S-1594
Date: April 25, 1994 Job No. 1994.418