

DESCRIPTION


CERTIFICATION

This inspection is made for the exclusive use of the present owners and also those who purchase, mortgage or guarantee the title thereto and is certified for one year from date hereto.

Date 11-2-94

Prepared for: Dan Korth
P.O. Box 77
105 Spring Street
Cambridge, WI 53523

James E. Woodman
Registered Land Surveyor S-1239

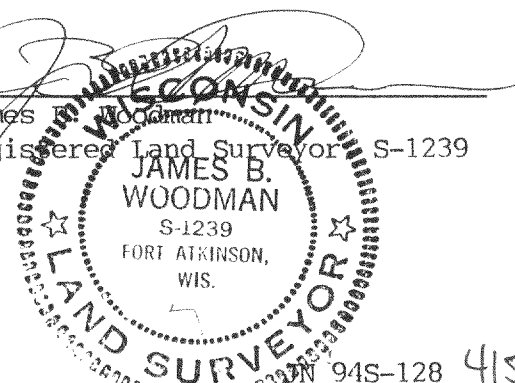

Sheet 1 of 1

UN 94S-128

Registered Land Surveyors
Phone (414) 563-8162