


**ABELL
SURVEYING & MAPPING
DELAVER, WISCONSIN 53115
414-728-6737**



PLAT OF SURVEY OF


Lot 14 in Thorne Heights Subdivision,
located in the Town of Whitewater,
according to the recorded plat thereof.
Also that part of Lot 15 in said Thorne Heights Subdivision
described as follows: Beginning at the Southeast corner of
said Lot 15; thence North 73° 50' West along the South line
of said Lot 164.21 feet more or less to the shore of White-
water Lake; thence Northerly along the shore of Whitewater
Lake, 16.0 feet; thence Southeasterly to the place of begin-
ning, County of Walworth, State of Wisconsin.

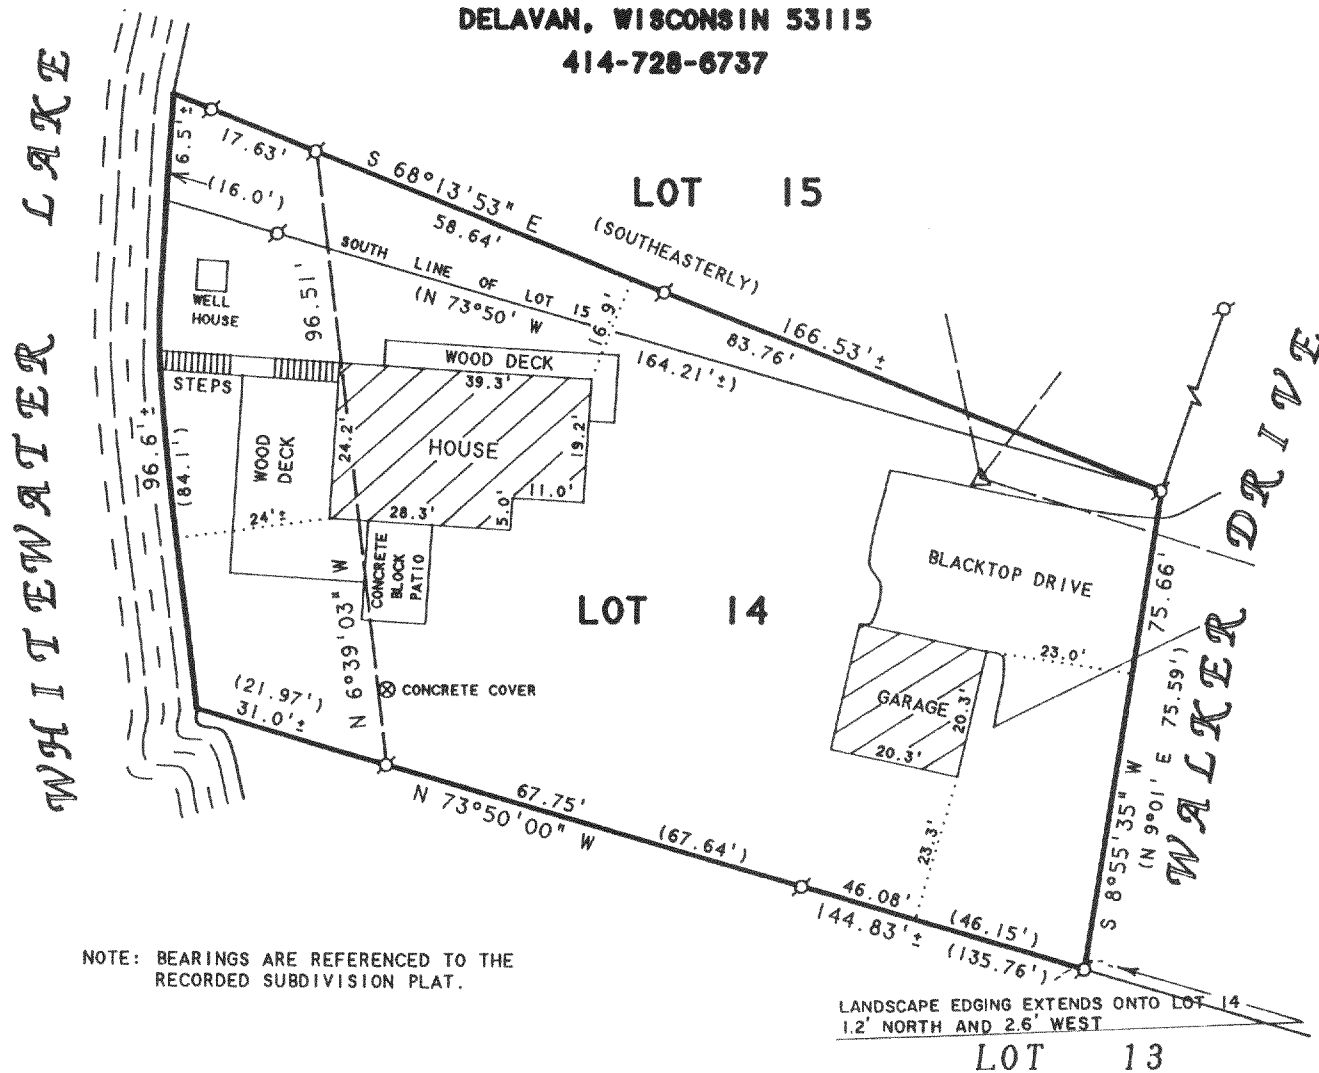

SCALE 1"=30'

LEGEND

- -IRON PIPE FOUND
- △ -UTILITY POLE
- -OVERHEAD UTILITY LINES
- () -RECORDED AS

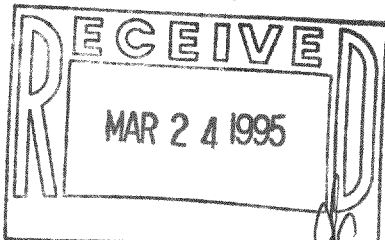

ORDERED BY: COLDWELL BANKER TLC
RT. 5 BOX 5
ELKHORN, WI. 53121

I HEREBY CERTIFY THAT I HAVE SURVEYED THE ABOVE DESCRIBED PROPERTY AND THAT THE
ABOVE MAP IS A TRUE REPRESENTATION THEREOF AND SHOWS THE SIZE AND LOCATION OF
THE PROPERTY, ITS EXTERIOR BOUNDARIES, THE LOCATION OF ALL VISIBLE STRUCTURES
AND DIMENSIONS OF ALL PRINCIPAL BUILDINGS THEREON, BOUNDARY FENCES, APPARENT
EASEMENTS, ROADWAYS AND VISIBLE ENCROACHMENTS, IF ANY, TO THE BEST OF MY
KNOWLEDGE AND BELIEF:

THIS SURVEY IS MADE FOR THE USE OF THE PRESENT OWNERS OF THE PROPERTY, AND ALSO
THOSE WHO PURCHASE, MORTGAGE, OR GUARANTEE THE TITLE THERETO WITHIN ONE (1) YEAR
FROM DATE HEREON.

David F. Abell

DAVID F. ABELL
WISCONSIN REGISTERED LAND SURVEYOR, S-1596

December 21, 1994

REVISED - 1/3/95

DATE JOB NUMBER - 94223
NOTE: THIS IS NOT A CERTIFIED COPY UNLESS SEALED.

DTH-14

415-473