

ABERNATHY and ASSOCIATES


Kenneth B. Abernathy Jr.

Wisconsin Registered Land Surveyor S-1594

Rt. 1 Box 273
Elkhorn, Wisconsin 53121
Phone (414) 723 4260 (office)
(414) 723 7209 (FAX)

PLAT OF SURVEY



LOT 1 OF CERTIFIED SURVEY MAP
NUMBER 2622, LOCATED IN PART OF
THE NORTHWEST 1/4 OF THE
SOUTHEAST 1/4 OF SECTION 15, TOWN
4 NORTH, RANGE 15 EAST, TOWN OF
WHITEWATER, WALWORTH COUNTY,
WISCONSIN.

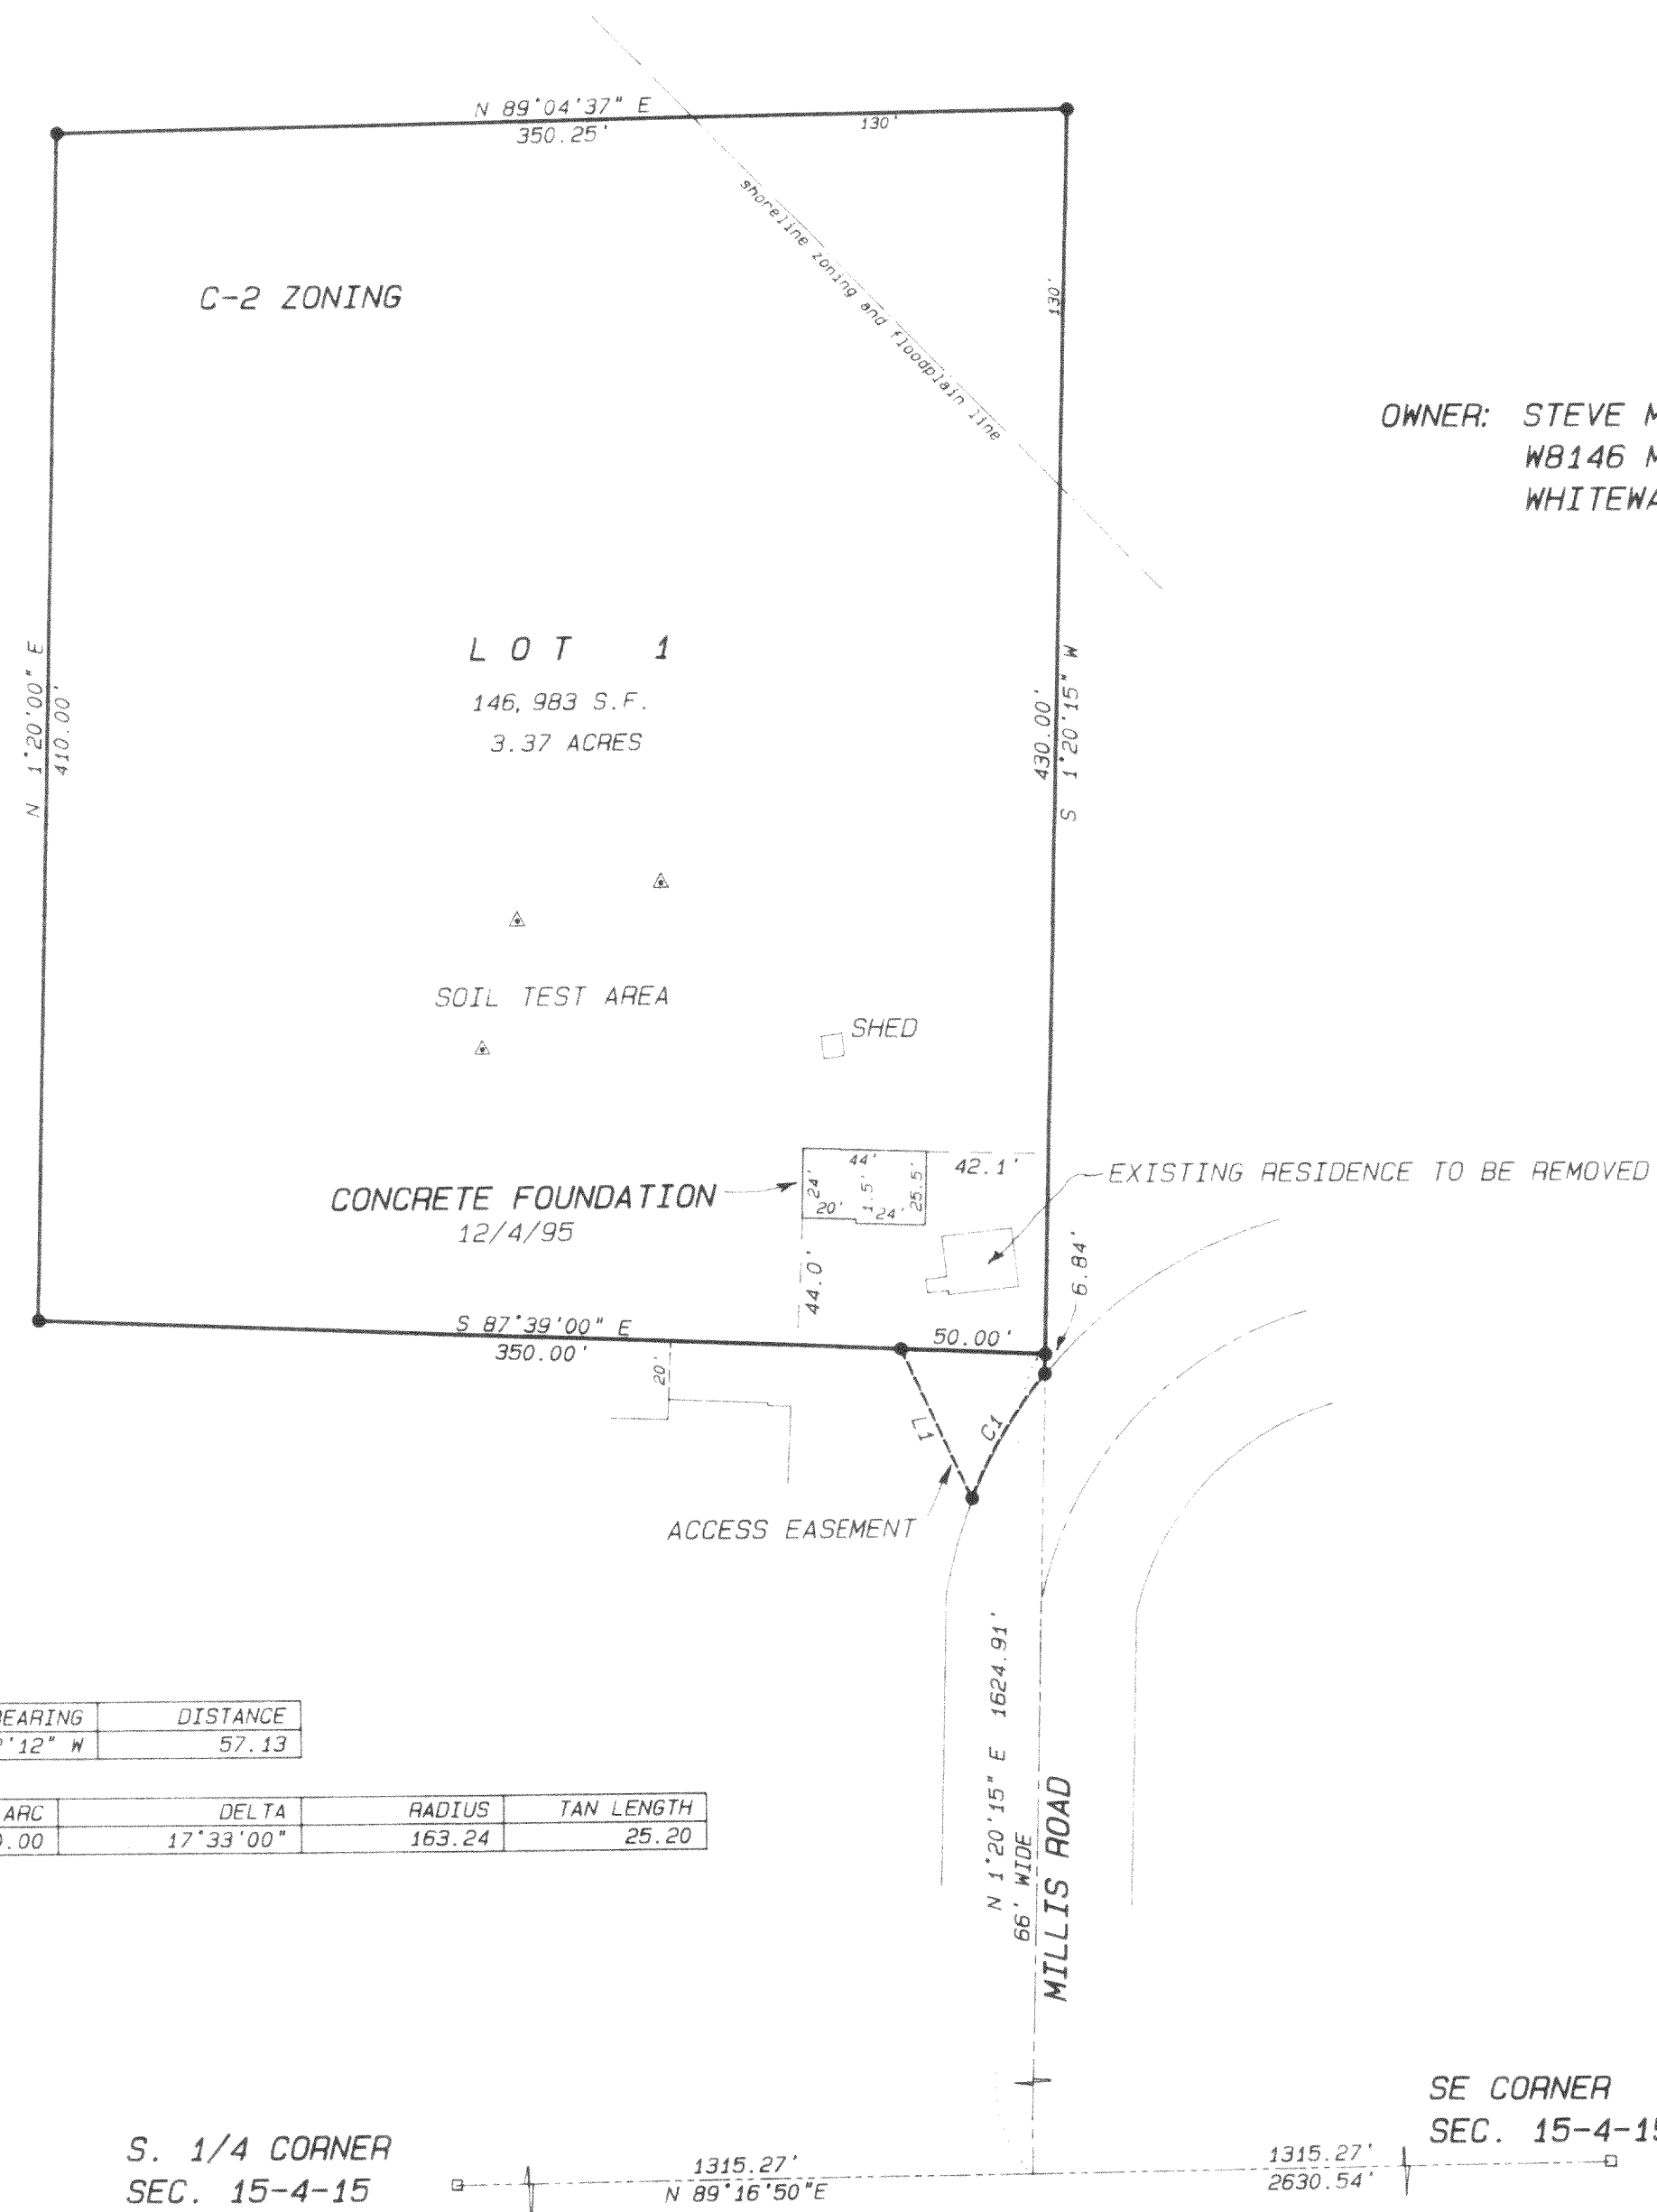

OWNER: STEVE MILLIS
W8146 MILLIS ROAD
WHITEWATER, WI. 53190

Legend

- FOUND IRON PIPE
- FOUND IRON ROD
- FOUND BRASS CLAPPED MONUMENT
- ✱ FOUND CONCRETE MONUMENT
- ✱ CHISEL CUT IN CONCRETE
- SET IRON ROD, 24" LONG, WEIGHING 1.5 LBS., LINEAL FT. 1/4" DIA.
- SET IRON ROD, 30" LONG, WEIGHING 4.5 LBS., LINEAL FT. 1/4" DIA.
- (XXX) RECORDED AS DIMENSION
- ✱✱✱ EXISTING FENCE

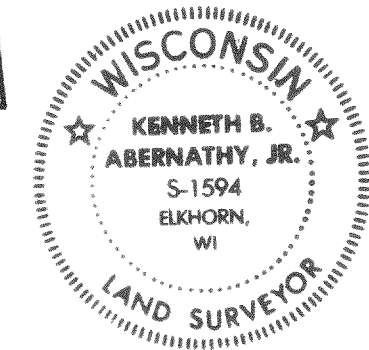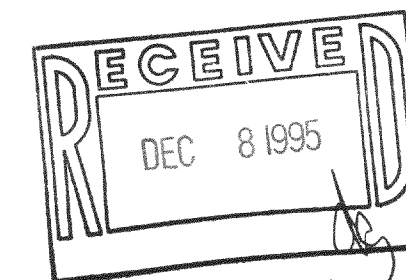

SCALE: 1" = 60 FEET

I hereby certify that the above described property has been surveyed and mapped in accordance with the laws of the State of Wisconsin, and that the above map is a true and correct representation thereof and shows the size and location of the property, its exterior boundaries, the location of all visible structures and dimensions of all principal buildings thereon, boundaries, fences, apparent easements, railroad and vehicle encroachments, if any.

This survey is made for the use of the present owners of the property and those who purchase mortgage, or guarantee the title thereto, and are not to be relied upon for any other purpose.

Kenneth B. Abernathy, Jr.

KENNETH B. ABERNATHY, JR.
WISCONSIN REGISTERED LAND SURVEYOR,
S-1594

Date: DECEMBER 7, 1995 Job No. 1995.406FL

DA-2622-1
HIS-506