

PLAT OF SURVEY

SURVEYOR'S CERTIFICATE


I, JAMES K. LANGONE, REGISTERED LAND SURVEYOR, CERTIFY THAT I HAVE SURVEYED THE PROPERTY HEREON DESCRIBED, AND THAT THE PLAT SHOWN HEREON IS A CORRECT REPRESENTATION OF THE BOUNDARIES THEREOF.

DATE: 6/24/96

JAMES K. LANGONE
REGISTERED LAND SURVEYOR S-1347

LEGAL DESCRIPTION

LOT 17, BLOCK 4, MORaine HEIGHTS SUBDIVISION
LOCATED IN THE SW 1/4, SECTION 35, T4N, R15E
WALWORTH COUNTY, WISCONSIN

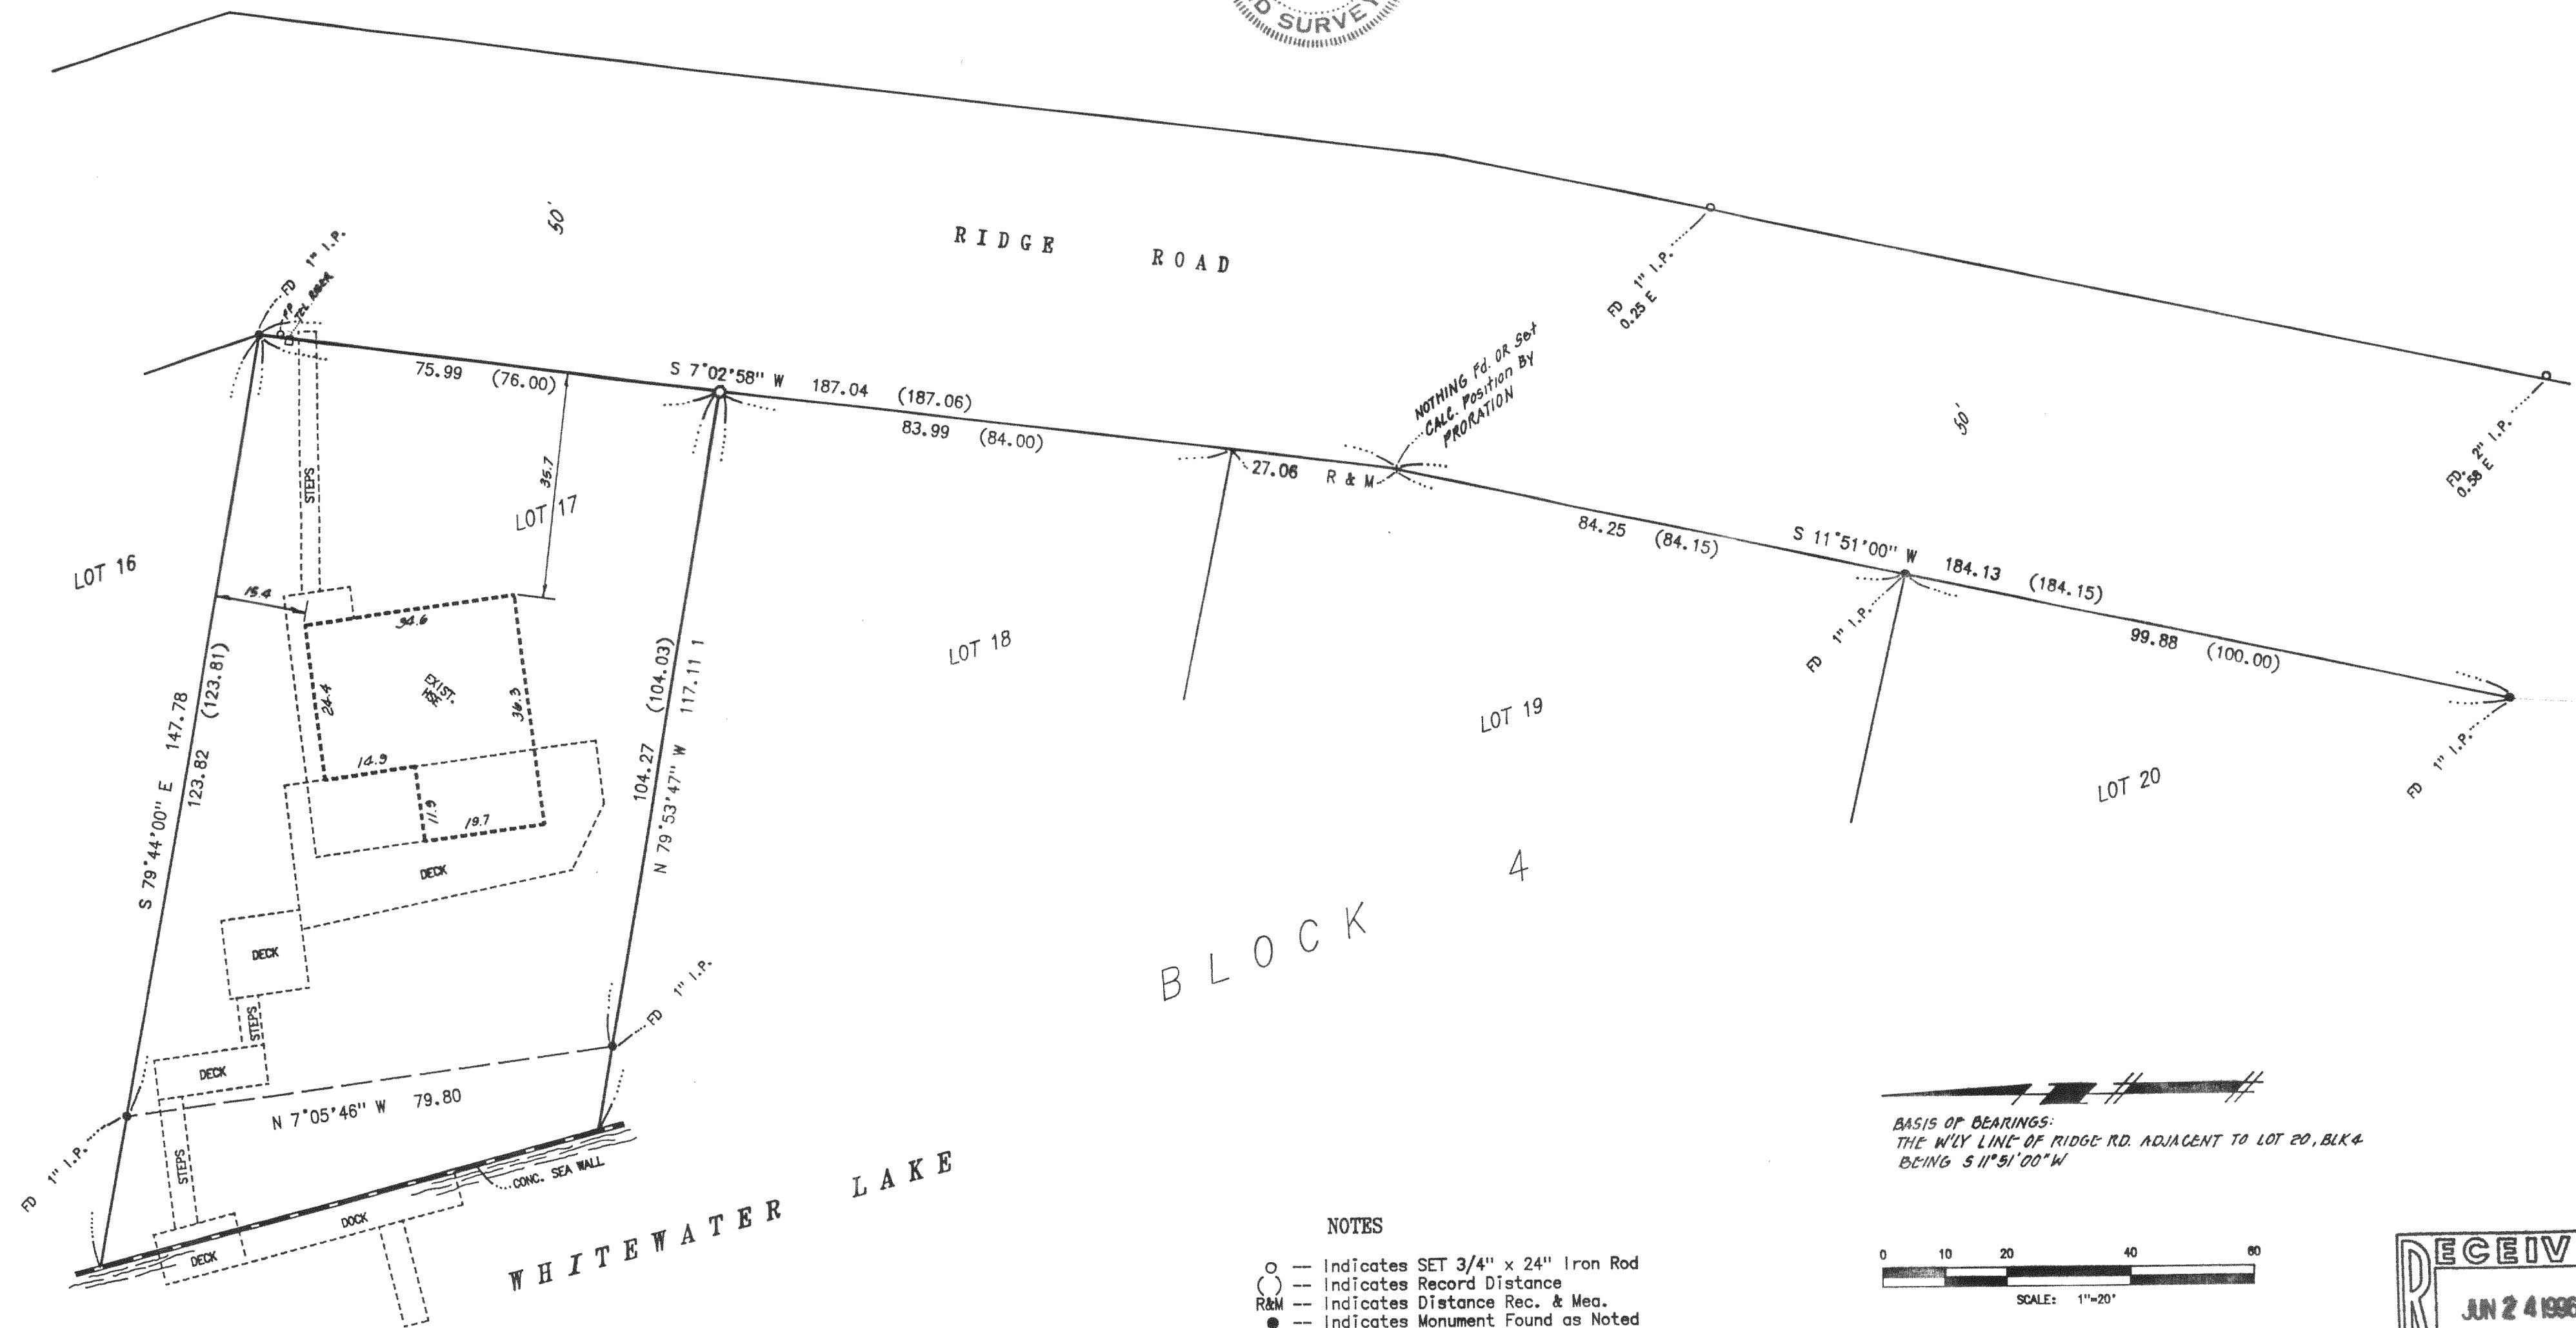


NOTES

- -- Indicates SET 3/4" x 24" Iron Rod
- () -- Indicates Record Distance
- R & M -- Indicates Distance Rec. & Mea.
- -- Indicates Monument Found as Noted



BASIS OF BEARINGS:
THE W'Y LINE OF RIDGE RD. ADJACENT TO LOT 20, BLK 4
BEING S 11°51'00" W

SCALE: 1"=20'

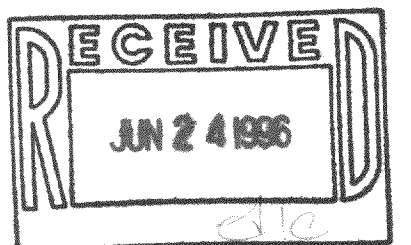

JAMES K. LANGONE LAND SURVEYS & CIVIL ENGINEERING		
N339 Co. Rd. "W" (Upper) Whitewater, WI. 53190-2842		(414) 473-4119
SCALE 1" = 20'	APPROVED BY	DRAWN BY JKL
DATE 6/21/96	REVISED	
CLIENT MEL CORK	DRAWING NUMBER 96-116	

DMH-99A