


DUNHAM SURVEYING, S.C.
SURVEYING & SUBDIVIDING
DELAVER, WISCONSIN 53115

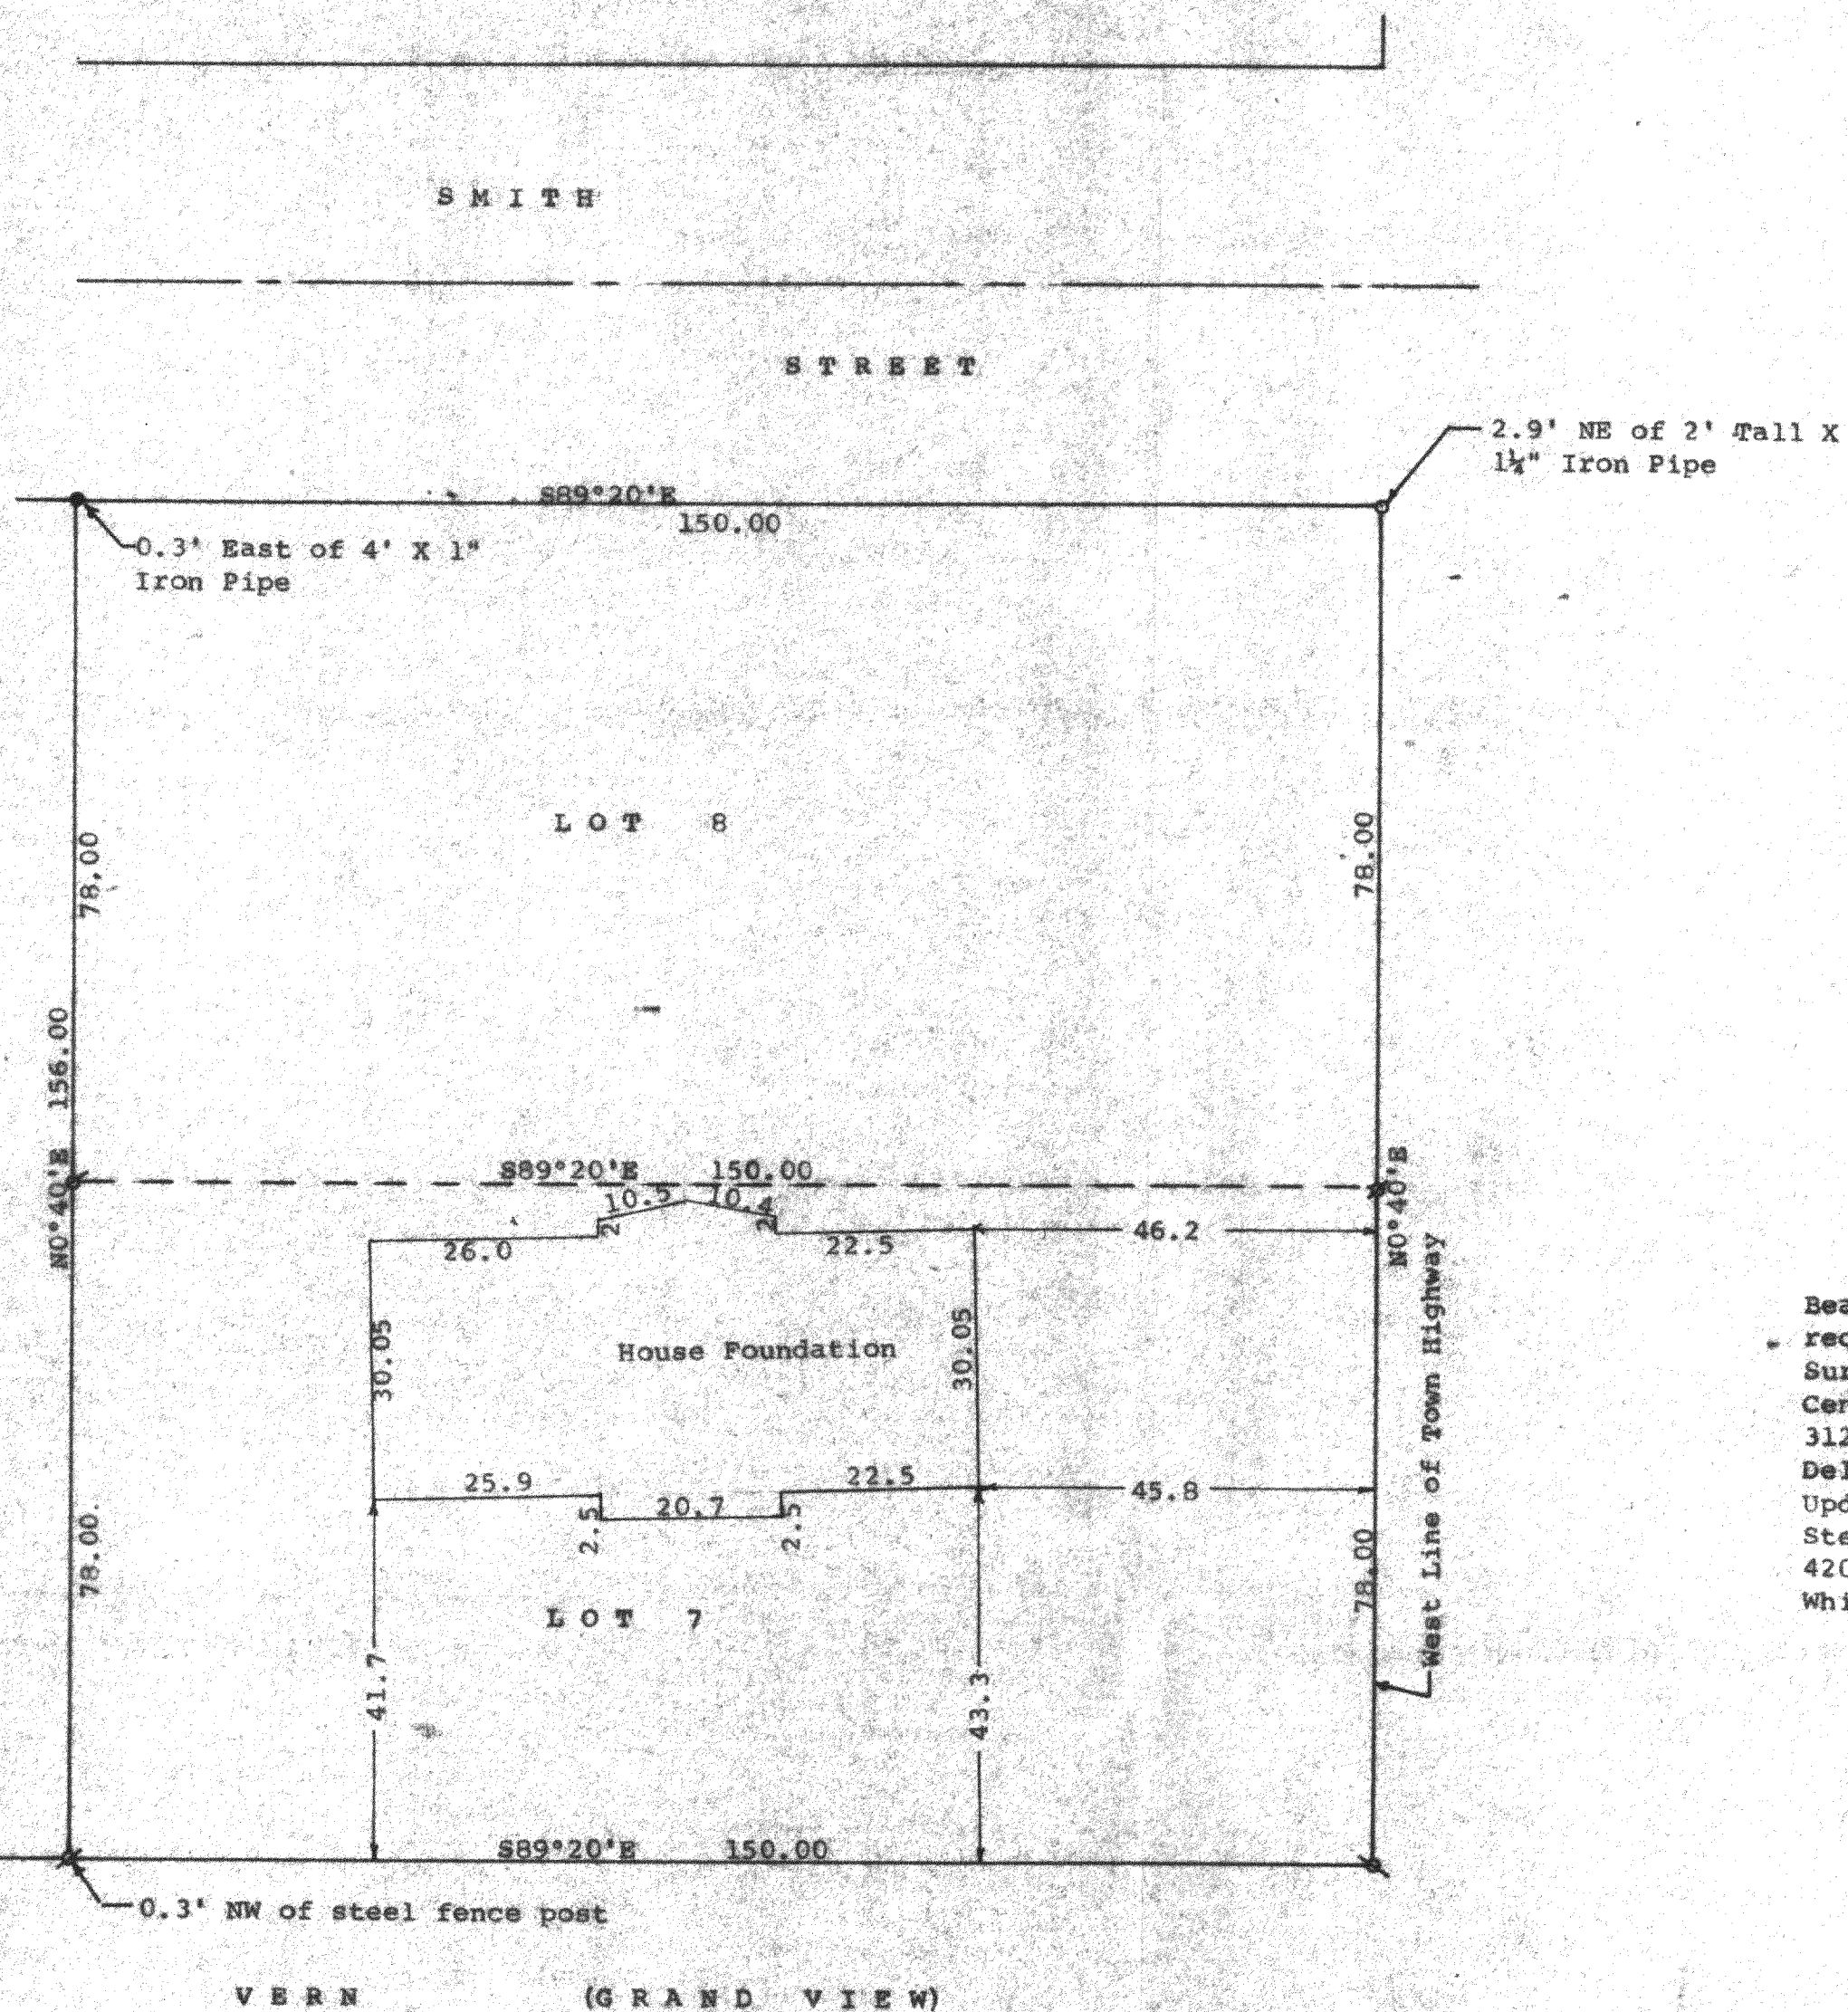

Scale - 1" = 20'

- = 2" Iron Pipe Found
- = 1" Iron Pipe Found
- = 3/4" X 24" Iron Pipe Set
- ⊙ = 60 penny spike found. 3/4" X 24" iron pipe Set

Bearings used are those shown on the recorded plat of Grand View Subdivision.
Survey ordered by:
Century 21, Skandia Realty
312 South 7th Street
Delavan, WI 53115
Updating and recertification ordered by:
Steve Downs
420 N. University Boulevard
Whitewater, WI 53190

STATE OF WISCONSIN)
COUNTY OF WALWORTH)

I, George T. Dunham, Surveyor, certify that I have surveyed the property described as follows:
Lots 7 and 8 in Block 5, Grand View Subdivision located in Section 34, T 4 N, R 15 E, Walworth County, Wisconsin.
and that the plat shown hereon is a correct representation thereof and shows the size and location of the property, its exterior boundaries, the location of all visible structures and dimensions of all principal buildings thereon, boundary fences, apparent easements, roadways and visible encroachments, if any, and that I have surveyed the property hereon described, according to the official records, to the best of my knowledge and belief.
March 7, 1989

Updated and recertified to this
30th day of October, 1995

George T. Dunham
George T. Dunham, Surveyor

