


LEGEND:
O - DENOTES NO. 6 REBAR W/CAP SET
ALL BEARINGS ARE REFERENCED TO GRID NORTH,
SOUTH ZONE OF THE WISCONSIN STATE PLANE
COORDINATE SYSTEM.
● - DENOTES IRON PIPE FOUND

STATE OF WISCONSIN
COUNTY OF RACINE

The above-described property has been surveyed under my direction and
the above map is a correct representation thereof.

DATED AT: NORTH CAPE, THIS 20TH DAY OF SEPTEMBER, 1996.

AMERICAN SURVEYING COMPANY, INC.
PETE L. BAILEY, RLS NO. 1398
RECEIVED 01/16/96

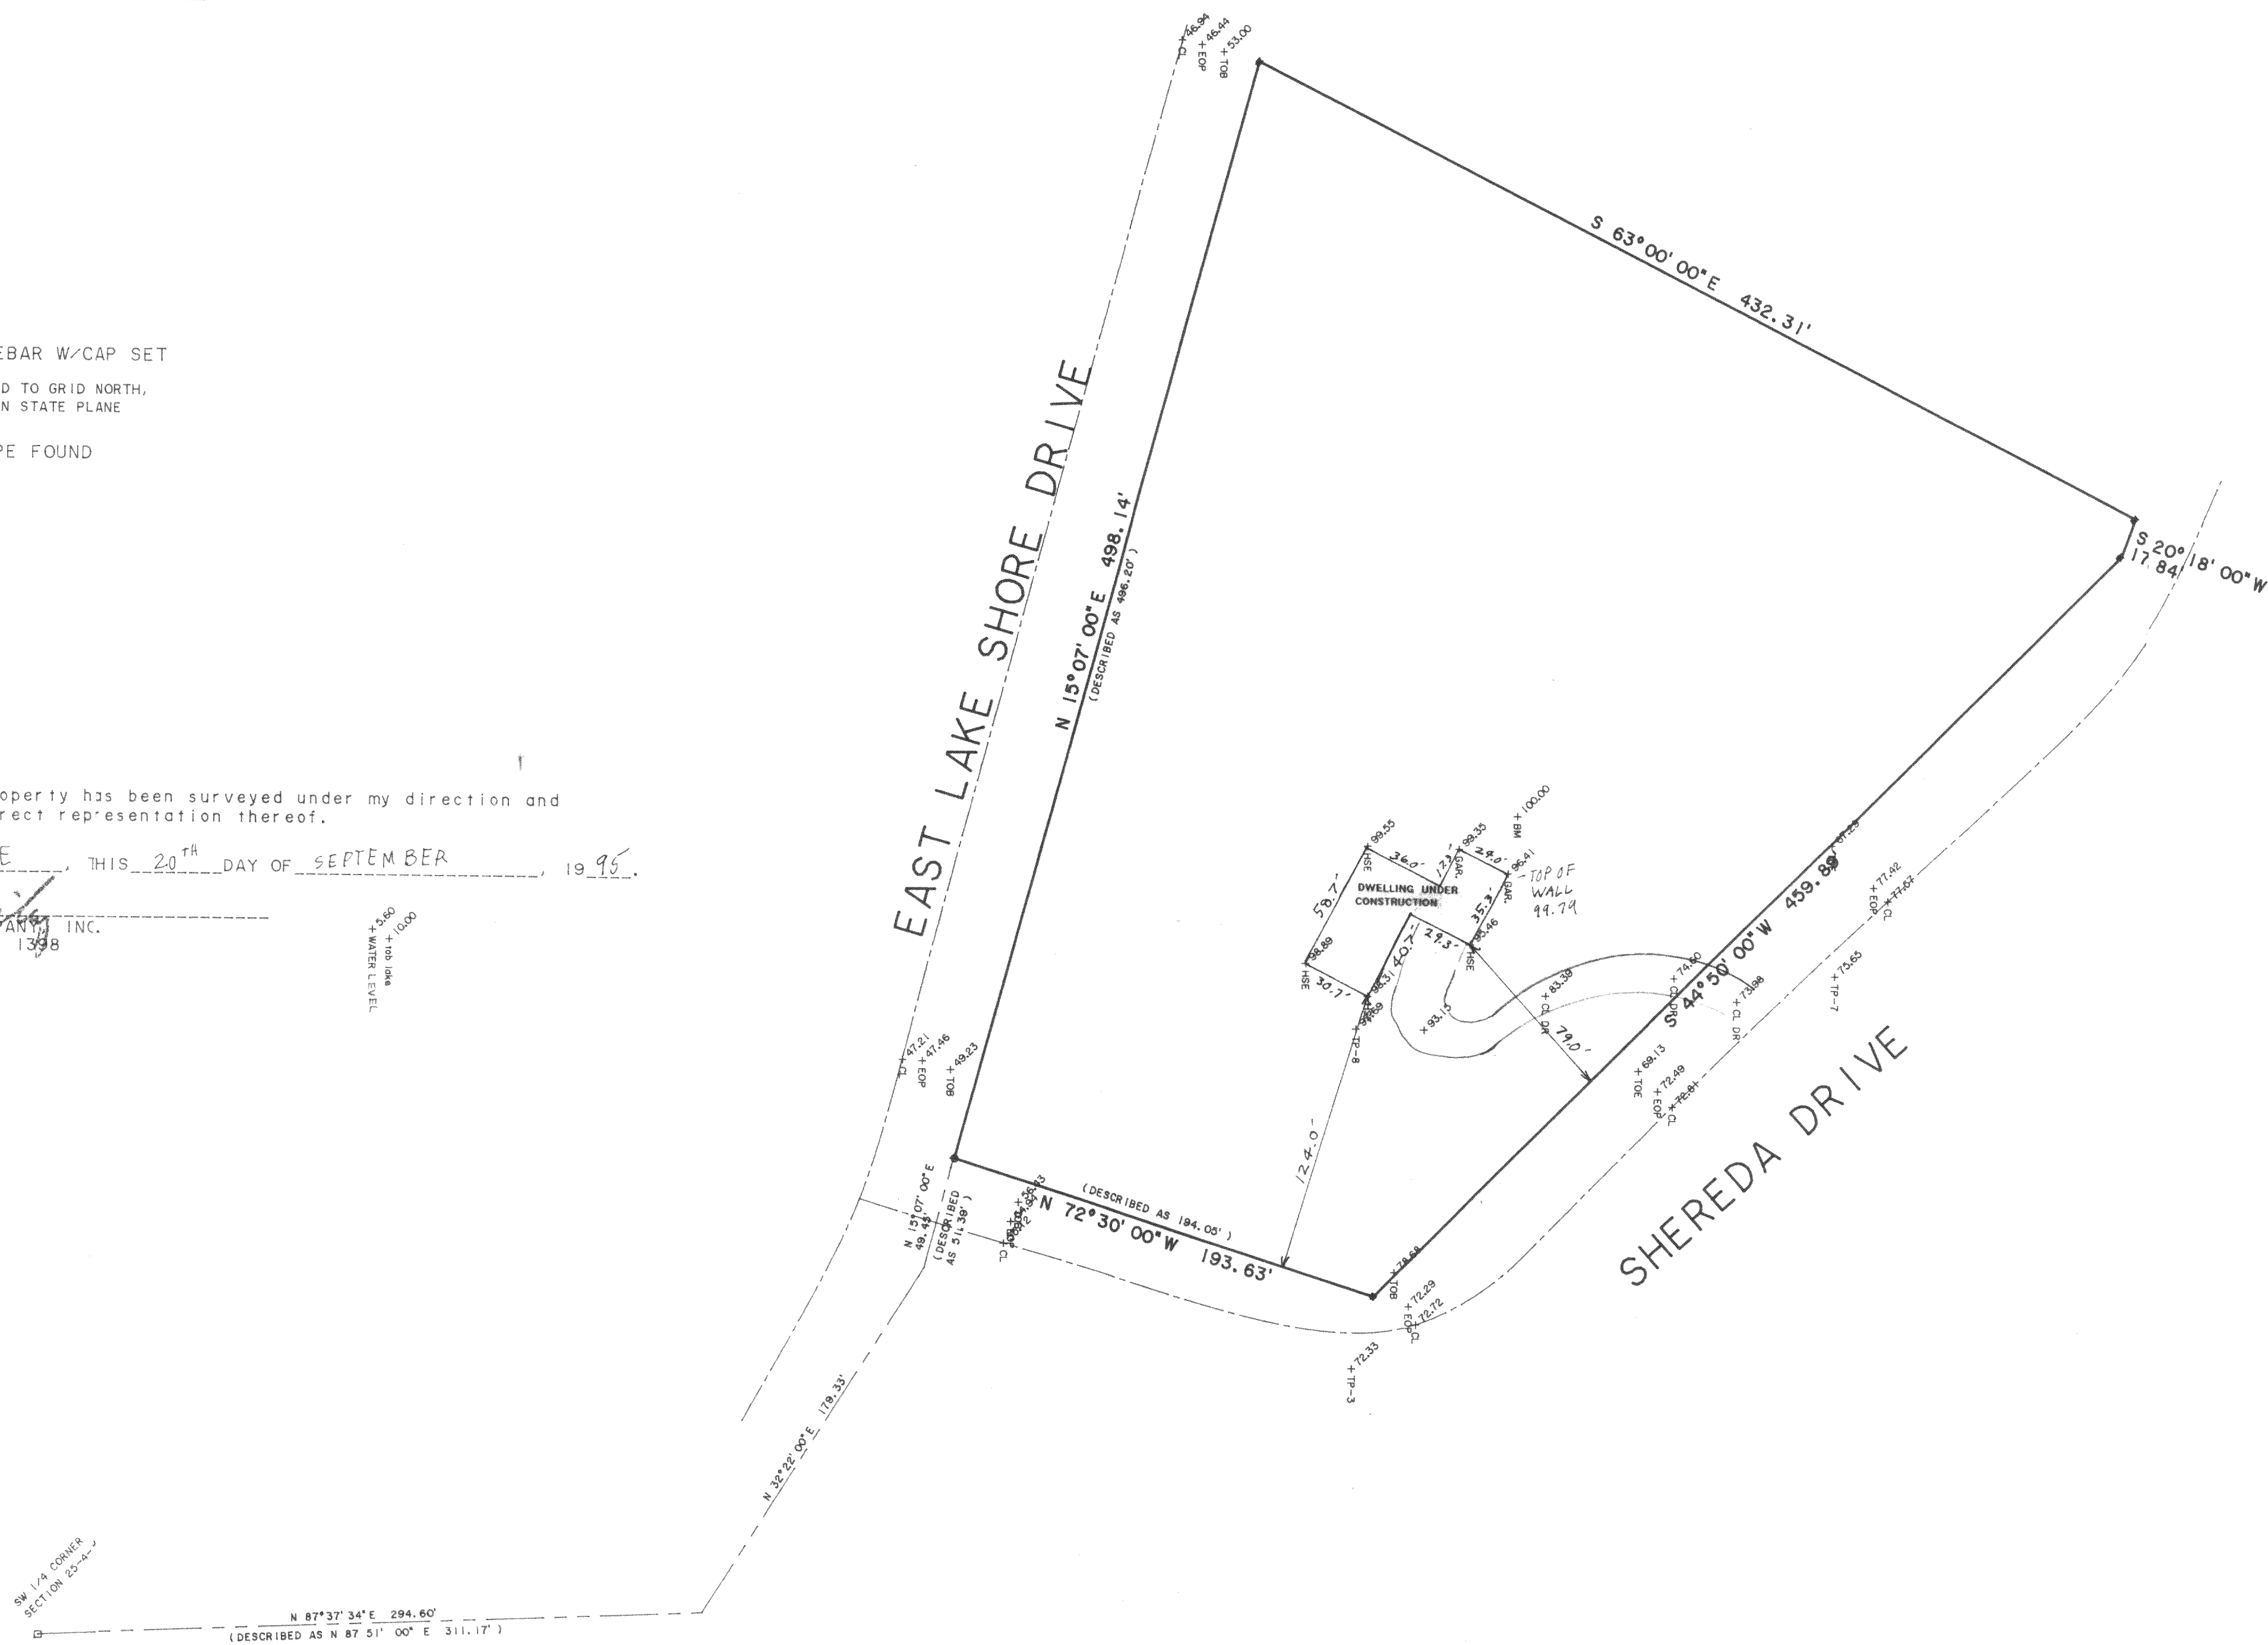

LEGAL DESCRIPTION

A TRACT OF LAND BEING PART OF THE SOUTHWEST 1/4 OF THE
SOUTHWEST 1/4 OF SECTION 25, TOWN 4 NORTH, RANGE 15 EAST, TOWN OF
WHITEWATER, COUNTY OF WALWORTH, STATE OF WISCONSIN, BOUNDED AND
DESCRIBED AS FOLLOWS:


COM SW COR SEC 25 T4N R15E, N 87D51' E 311.17' TO ELY LN LAKEVIEW DR, N 32D22' E
179.33', N 15D07' E 51.39' TO POB, CONT NE 496.20', S 63D00' E 432.31' TO NWLY LN
SHEREDA DR, S 20D18' W 17.84', S 44D50' W 459.89', N 72D30' W 194.05' TO POB.

TOWN OF WHITEWATER

AMERICAN SURVEYING COMPANY, INC.
12207 C.T.H. "K", NORTH CAPE
FRANKSVILLE, WIS.
(414) 835-4774

HOUSE STAKEOUT

PREPARED FOR: NORM KEEKER & SONS

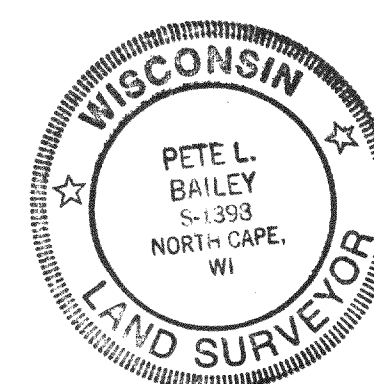

DRAWN: PJB	APPROVED:	JOB NUMBER: 95183	SHEET 1 OF 1
DATE: 09/20/96	DATE:	FILE NUMBER: JN95226	

DW-25-60

1964 415-520