
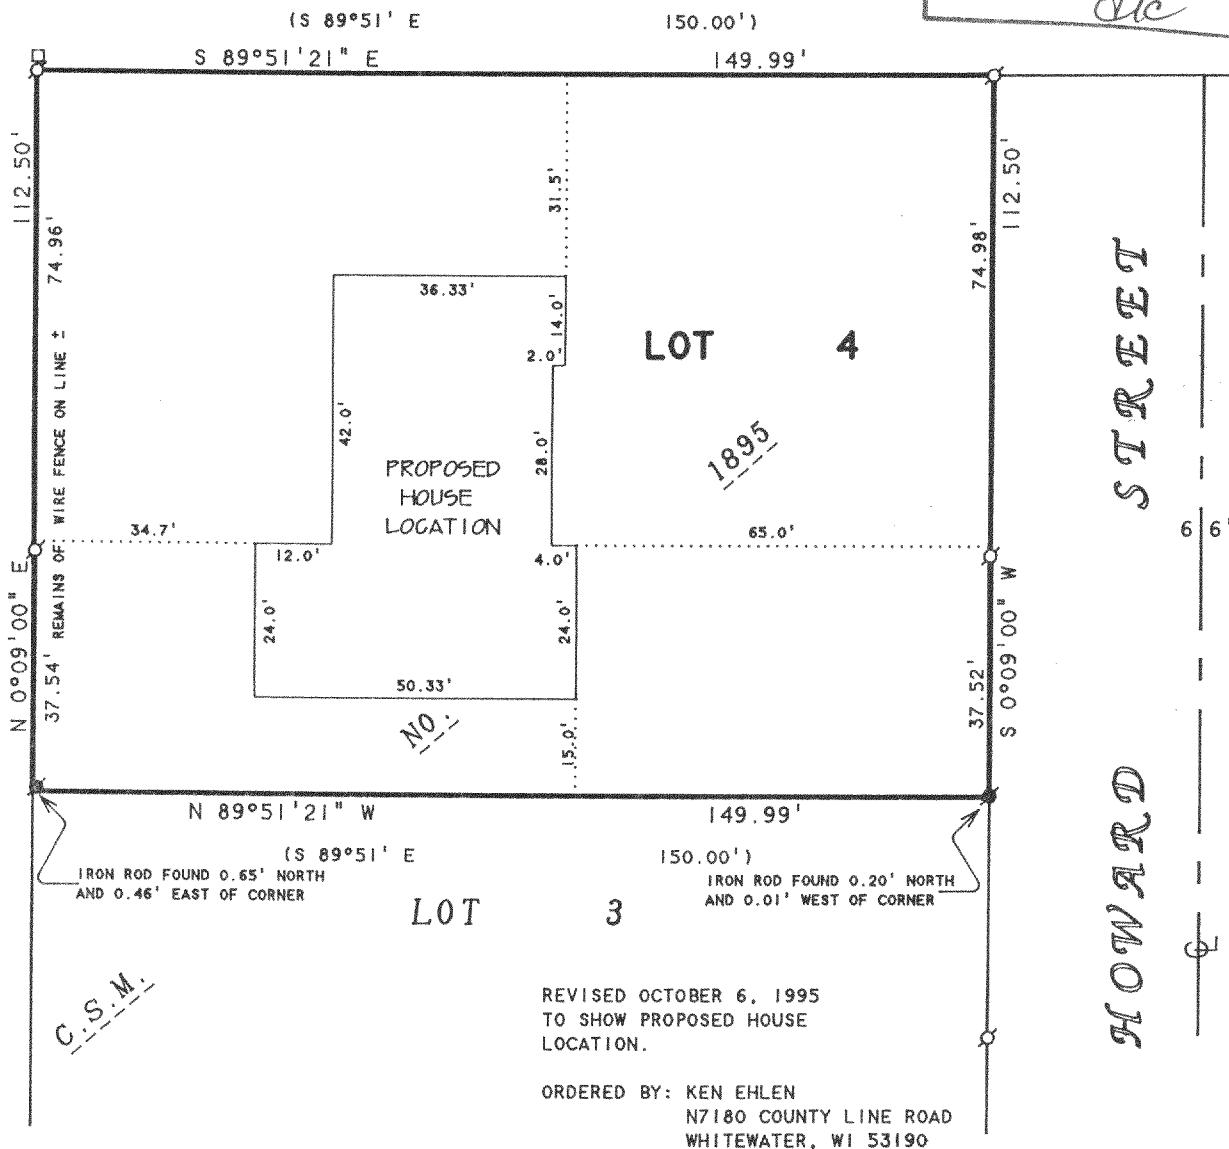


ABELL
SURVEYING & MAPPING
DELAVER, WISCONSIN 53115
414-728-6737

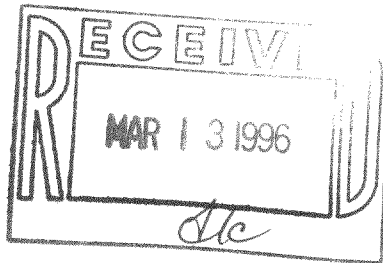

ORDERED BY: VERN LUTKE
N7480 GRANDVIEW DRIVE
WHITEWATER, WI 53190

PLAT OF SURVEY OF

NOTE: BEARINGS ARE REFERENCED TO
CERTIFIED SURVEY MAP NO. 1895.

LOT 4, CERTIFIED SURVEY MAP NO. 1895, LOCATED
IN SOUTHEAST 1/4 OF SECTION 34, T4N, R15E,
WALWORTH COUNTY, WISCONSIN.

N



SCALE 1"=30'

LEGEND

- -IRON PIPE FOUND
- -IRON ROD FOUND
- -UTILITY PED.
- () -RECORDED AS

I HEREBY CERTIFY THAT I HAVE SURVEYED THE ABOVE DESCRIBED PROPERTY AND THAT THE ABOVE MAP IS A TRUE REPRESENTATION THEREOF AND SHOWS THE SIZE AND LOCATION OF THE PROPERTY, ITS EXTERIOR BOUNDARIES, THE LOCATION OF ALL VISIBLE STRUCTURES AND DIMENSIONS OF ALL PRINCIPAL BUILDINGS THEREON, BOUNDARY FENCES, APPARENT EASEMENTS, ROADWAYS AND VISIBLE ENCROACHMENTS, IF ANY, TO THE BEST OF MY KNOWLEDGE AND BELIEF.

THIS SURVEY IS MADE FOR THE USE OF THE PRESENT OWNERS OF THE PROPERTY, AND ALSO THOSE WHO PURCHASE, MORTGAGE, OR GUARANTEE THE TITLE THERETO WITHIN ONE (1) YEAR FROM DATE HEREON.

David F. Abell

DAVID F. ABELL
WISCONSIN REGISTERED LAND SURVEYOR, S-1596



July 12, 1995

DATE JOB NUMBER - 95110
NOTE: THIS IS NOT A CERTIFIED COPY UNLESS SEALED.

DA-1895-4

415-523

ABELL
SURVEYING & MAPPING
DELAVER, WISCONSIN 53115
414-728-6737

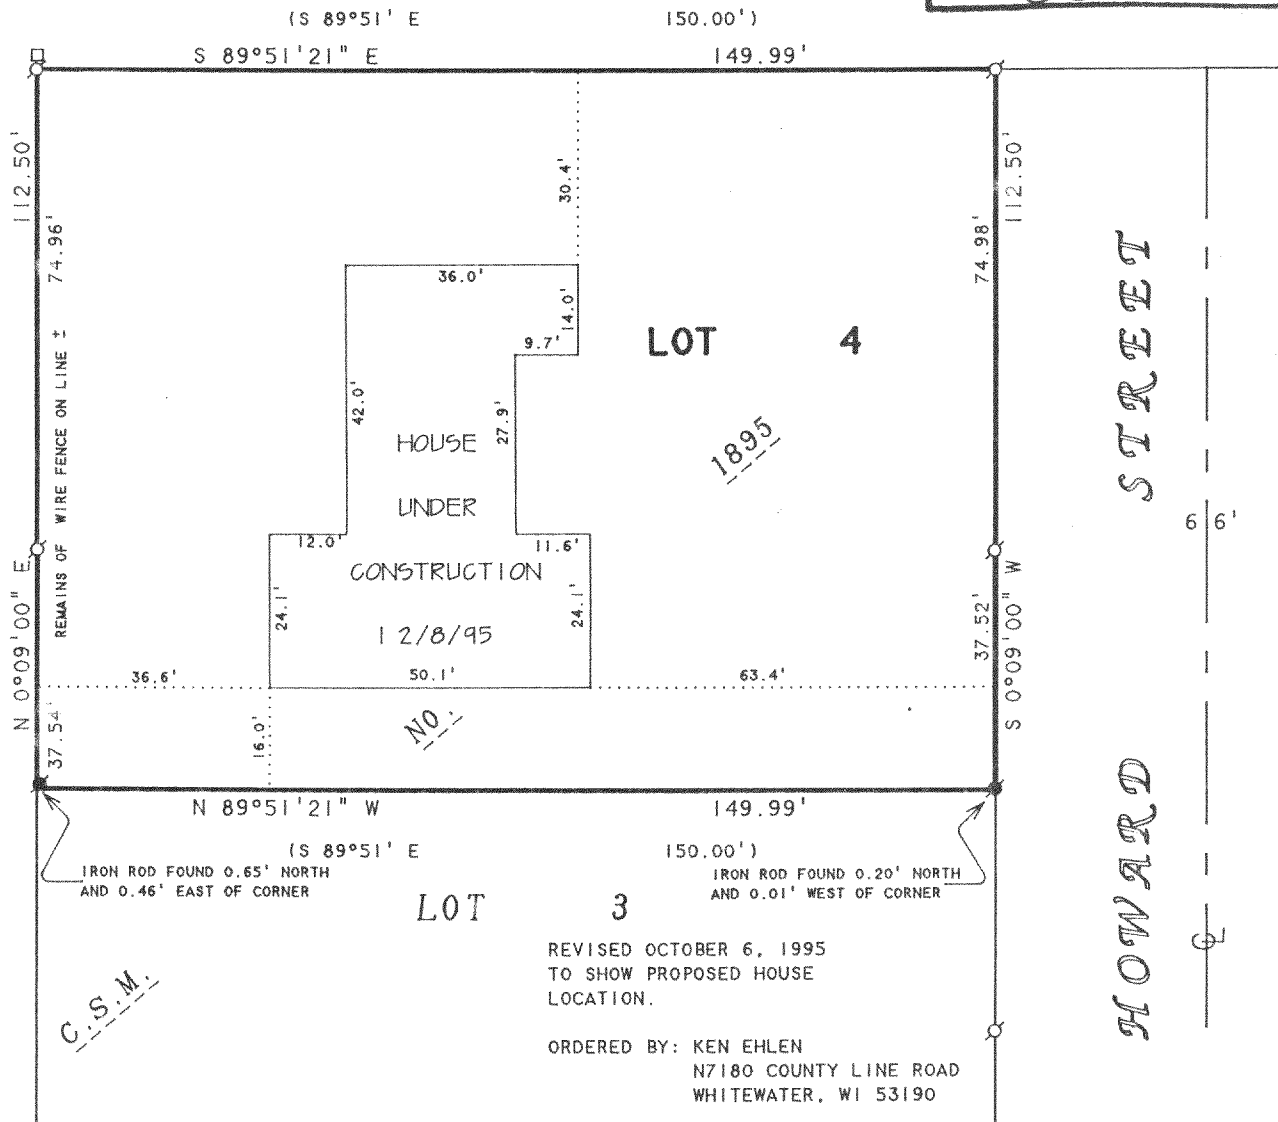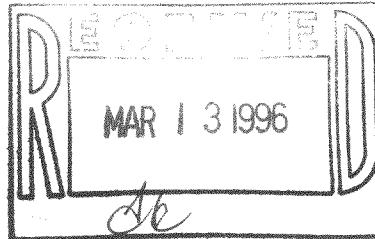

ORDERED BY: VERN LUTKE
N7480 GRANDVIEW DRIVE
WHITEWATER, WI 53190

REVISED OCTOBER 6, 1995
TO SHOW PROPOSED HOUSE
LOCATION.

ORDERED BY: KEN EHLEN
N7180 COUNTY LINE ROAD
WHITEWATER, WI 53190

REVISED DECEMBER 8, 1995
TO SHOW HOUSE UNDER
CONSTRUCTION.

ORDERED BY: M & I BANK - JANESVILLE

NOTE: BEARINGS ARE REFERENCED TO
CERTIFIED SURVEY MAP NO. 1895.

PLAT OF SURVEY OF

LOT 4, CERTIFIED SURVEY MAP NO. 1895, LOCATED
IN SOUTHEAST 1/4 OF SECTION 34, T4N, R15E,
WALWORTH COUNTY, WISCONSIN.

N



SCALE 1"=30'

LEGEND

- - IRON PIPE FOUND
- - IRON ROD FOUND
- - UTILITY PED.
- () - RECORDED AS

I HEREBY CERTIFY THAT I HAVE SURVEYED THE ABOVE DESCRIBED PROPERTY AND THAT THE ABOVE MAP IS A TRUE REPRESENTATION THEREOF AND SHOWS THE SIZE AND LOCATION OF THE PROPERTY, ITS EXTERIOR BOUNDARIES, THE LOCATION OF ALL VISIBLE STRUCTURES AND DIMENSIONS OF ALL PRINCIPAL BUILDINGS THEREON, BOUNDARY FENCES, APPARENT EASEMENTS, ROADWAYS AND VISIBLE ENCROACHMENTS, IF ANY, TO THE BEST OF MY KNOWLEDGE AND BELIEF.

THIS SURVEY IS MADE FOR THE USE OF THE PRESENT OWNERS OF THE PROPERTY, AND ALSO THOSE WHO PURCHASE, MORTGAGE, OR GUARANTEE THE TITLE THERETO WITHIN ONE (1) YEAR FROM DATE HEREON.

David F. Abell

DAVID F. ABELL
WISCONSIN REGISTERED LAND SURVEYOR, S-1596

July 12, 1995

DATE: July 12, 1995 JOB NUMBER - 95110
NOTE: THIS IS NOT A CERTIFIED COPY UNLESS SEALED.

DA-1895-4