
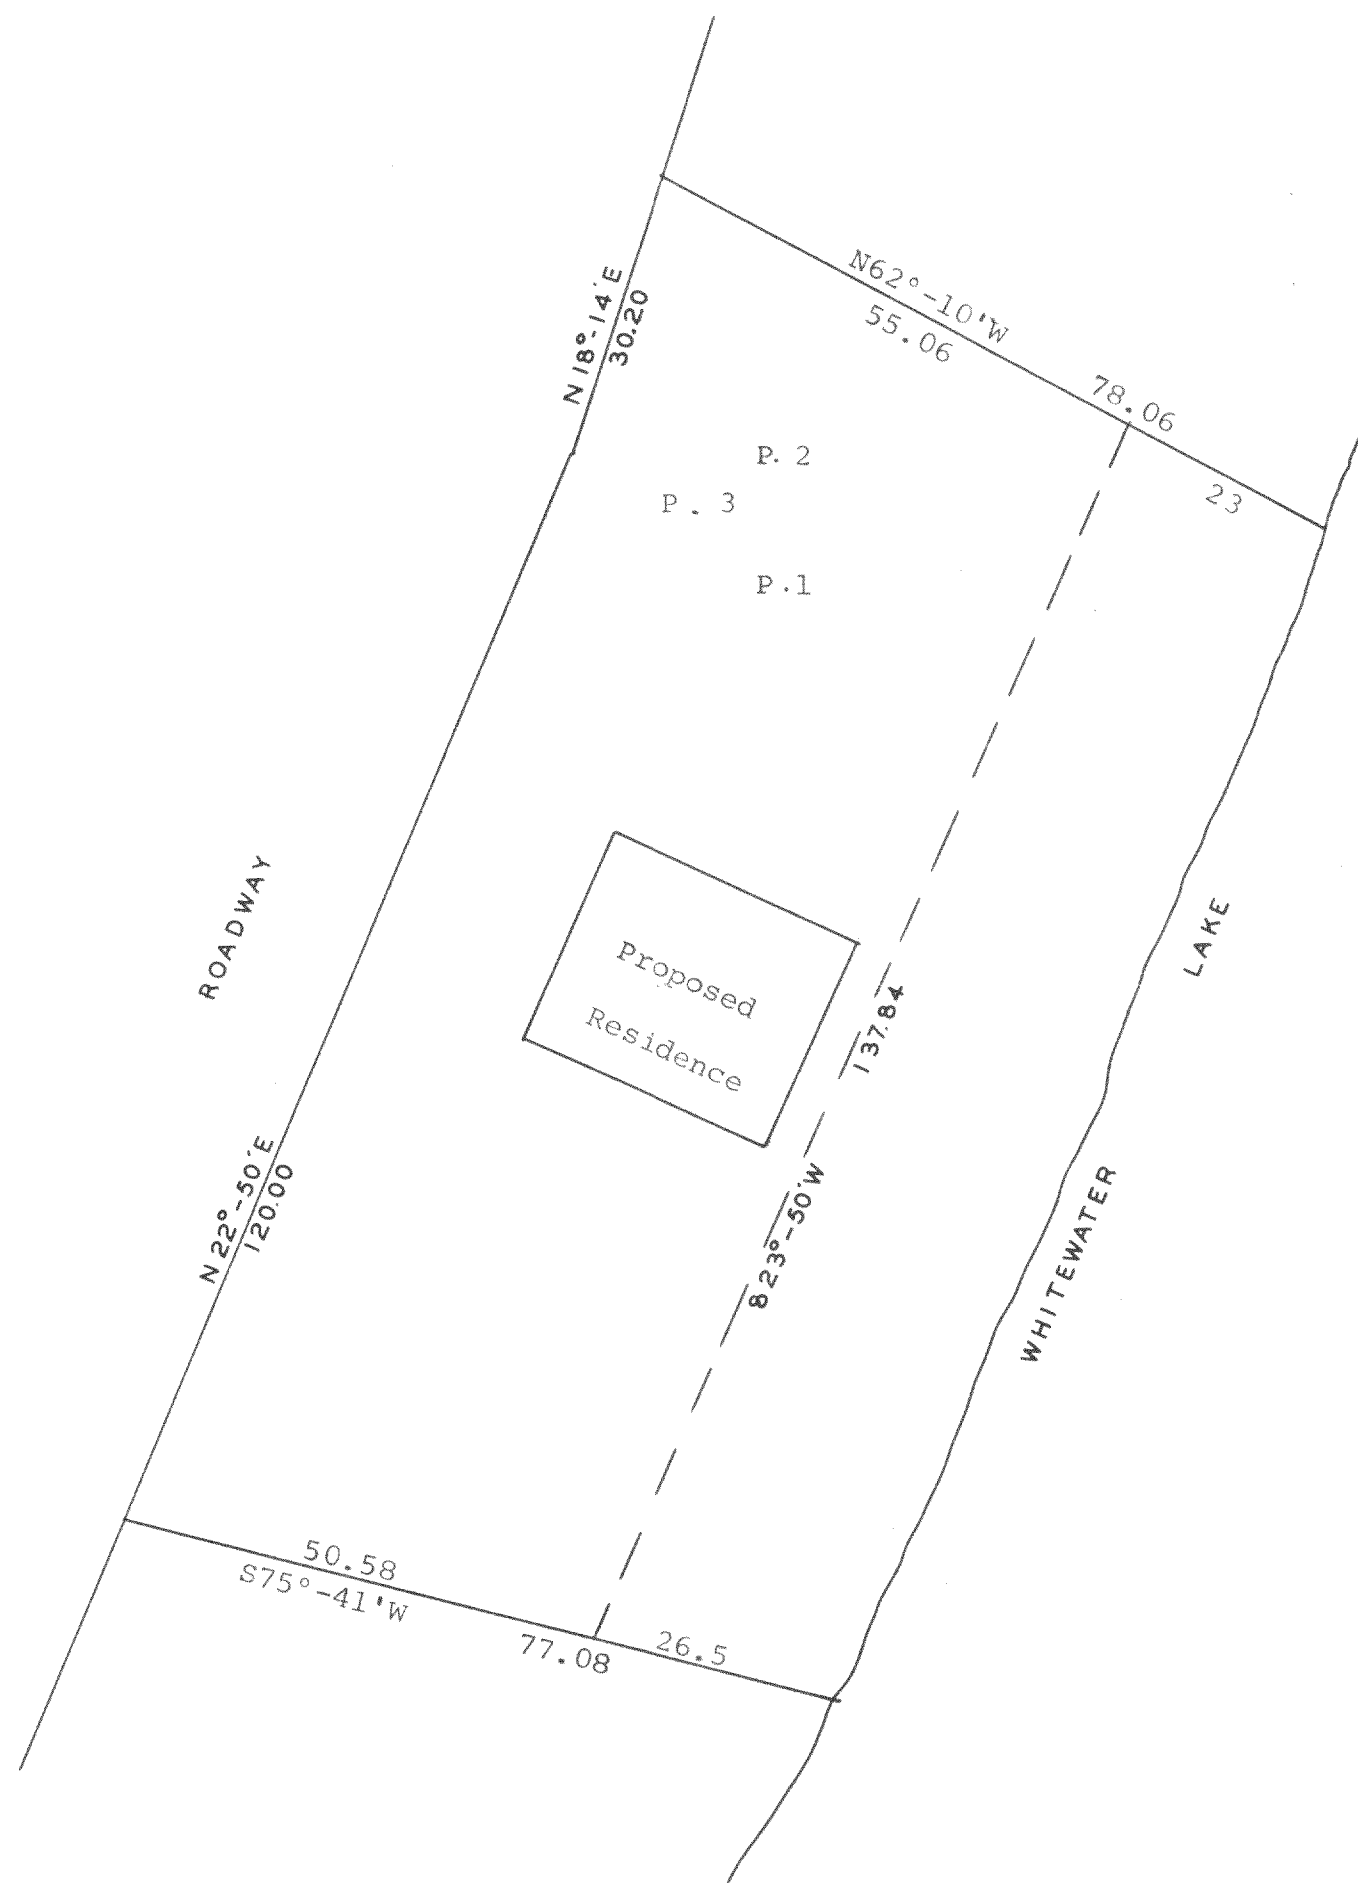


GEORGE T. DUNHAM
SURVEYING & SUBDIVIDING
DELAVER, WISCONSIN

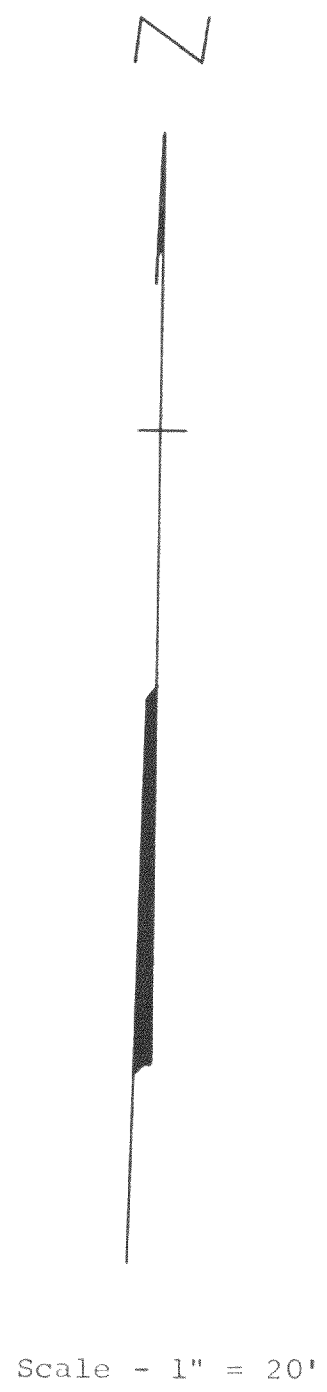

Plat showing the location of the percolation tests taken
on Lot 7, Block 1, Moraine Heights Subdivision, Town
of Whitewater, Walworth County, Wisconsin.
July 21, 1967

George T. Dunham
George T. Dunham, Surveyor

414-7