


Wisconsin Registered Land Surveyor S-1594

Rt. 3, Box 273
Elkhorn, Wisconsin 53121
Phone: (414) 723-4260 (office)
(414) 723 7209 (FAX)

PLAT OF SURVEY

LOTS 1 AND 2 OF BLOCK 4 OF MORaine
PARK SUBDIVISION, LOCATED IN SECTION
34, TOWN 4 NORTH, RANGE 15 EAST,
WALWORTH COUNTY, WISCONSIN.

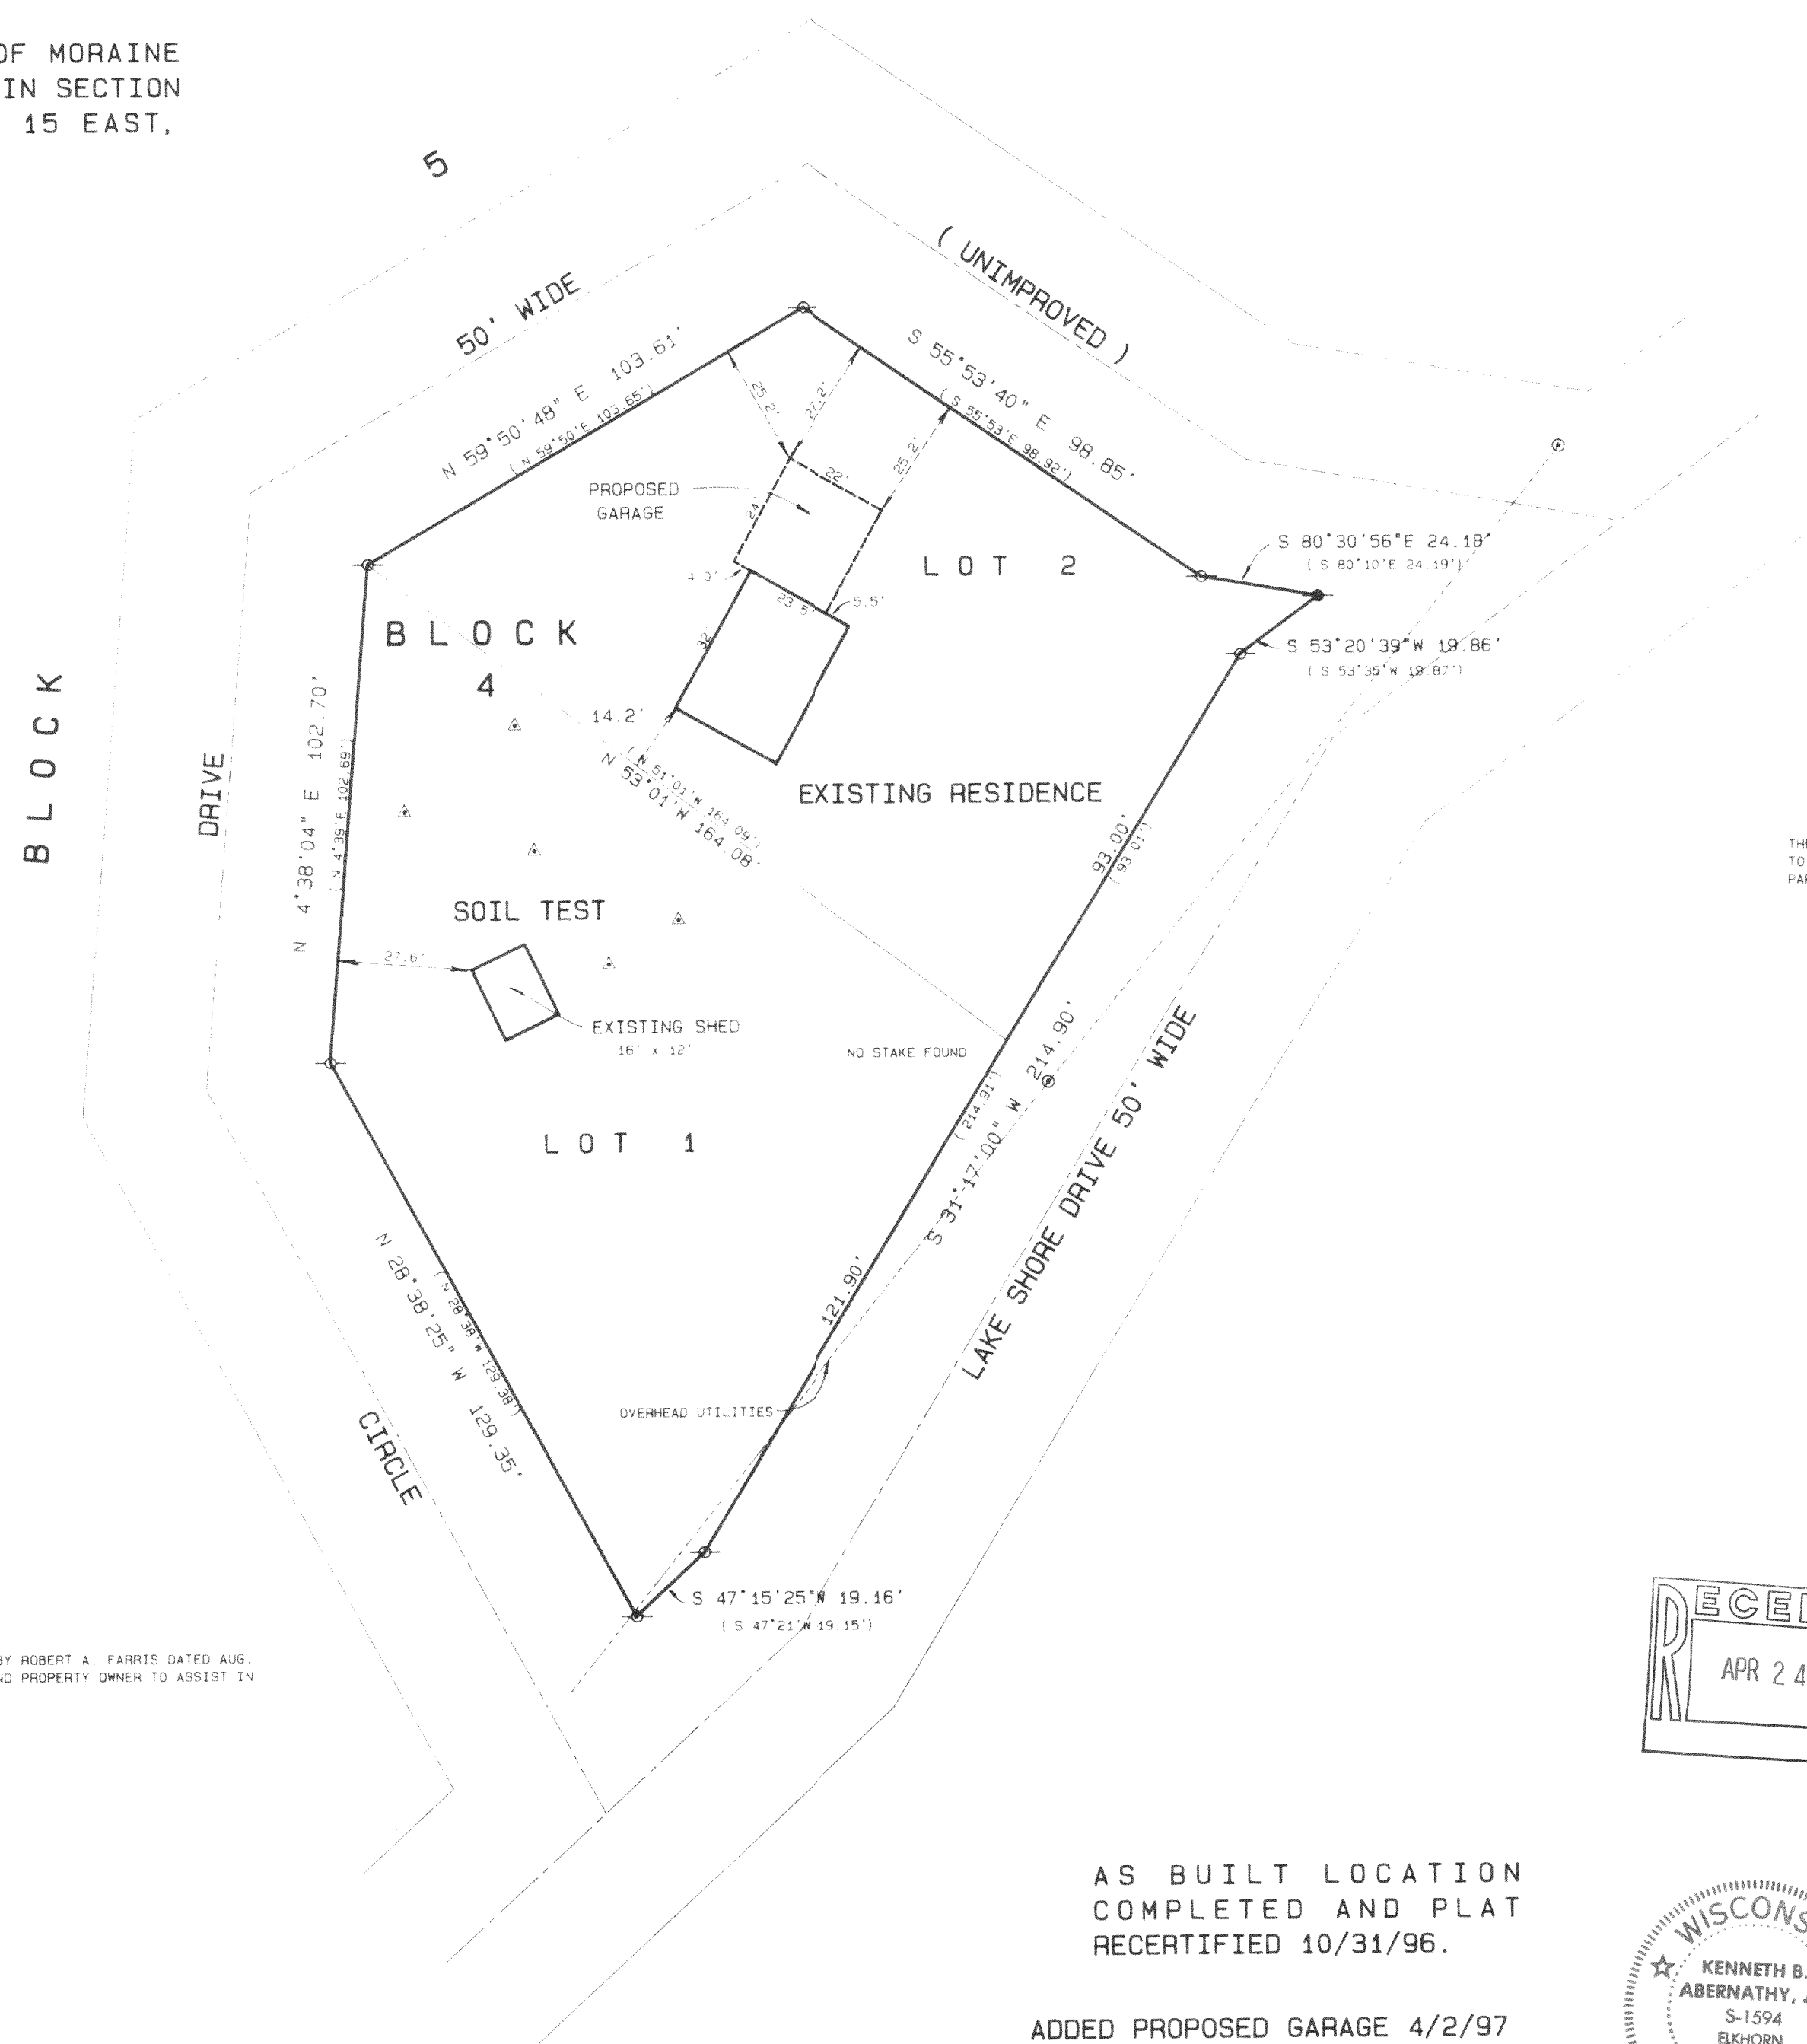

SCALE 1" = 30 FEET

THE NORTHWEST LINE OF LAKE SHORE DRIVE WAS ASSUMED
TO BEAR N 31°17'E AS SHOWN ON THE PLAT OF MORaine
PARK SUBD. AND THE FARRIS PLAT OF SURVEY.

Legend

- + FOUND IRON PIPE
- FOUND IRON ROD
- FOUND BRASS-CAPPED MONUMENT
- x FOUND CONCRETE MONUMENT
- * CHISEL CUT IN CONCRETE
- SET IRON ROD, 24' LONG, WEIGHING
1.5 LBS. LINEAL FT., 3/4 DIA.
- SET IRON ROD, 30' LONG, WEIGHING
4.5 LBS. LINEAL FT., 1 1/8-1 3/8 DIA.
- [xxx] RECORDED AS DIMENSION
- x - x - EXISTING FENCE

TOTAL AREA = 29, 186 S.F.


OWNER: MICHAEL CARPENTER
N 7577 W. LAKE SHORE DRIVE
WHITEWATER, WI. 53190

NOTES:


THIS PLAT RETRACES A PREVIOUS PLAT OF SURVEY PREPARED BY ROBERT A. FARRIS DATED AUG. 30, 1990 A COPY OF WHICH WAS SUPPLIED BY THE BUILDER AND PROPERTY OWNER TO ASSIST IN THE PREPARATION OF THIS PLAT.

AS BUILT LOCATION
COMPLETED AND PLAT
RECERTIFIED 10/31/96.

ADDED PROPOSED GARAGE 4/2/97

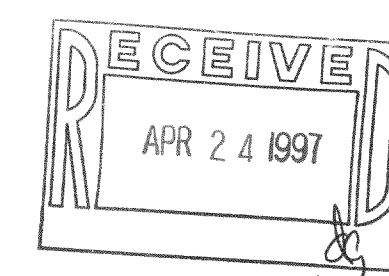

SCALE: 1" = 30 FEET

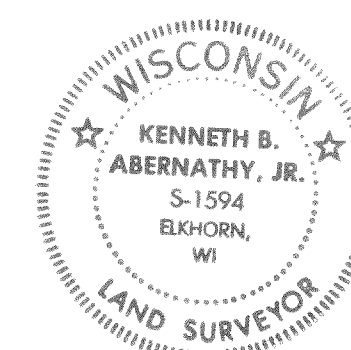

"I hereby certify that the above-described property has been surveyed by me in accordance with the laws of the State of California, that this is a true and correct copy of the original survey map and shows the size and location of the property, its external boundaries, the location of all visible structures and dimensions of all principal buildings thereon, boundary fences, apparent easements, roadways and visible encroachments, if any.

"This survey is made for the purpose of the present owners of the property and also those who purchase the same, to guarantee the title thereto within one year from date hereof."

Kurt B. Anderson

KENNETH B. ABERNATHY, JR.
WISCONSIN REGISTERED LAND SURVEYOR,
S-1594

Date: SEPT. 17, 1996 Job No. 96.905

DESIGN PRODUCTS 1587-0111

DMP-41

415-585