


PLAT OF SURVEY

FOR THE LOCATION OF THE HOUSE ON LOT 2, BLOCK 2, GUTZMER'S SUBDIVISION IN THE NW $\frac{1}{4}$ OF THE SW $\frac{1}{4}$ OF SECTION 25, T 4 N, R 15 E, TOWN OF WHITE-WATER, WALWORTH COUNTY, WISCONSIN.

NOTES: 1) Prepared for Kaashagen & Sons, Inc., Cambridge, WI.
2) Lot area is 9950 sq. feet more or less.

LEGEND

- Existing iron pipe found,
- () Recorded plat data shown in parenthesis.
- () S. Previous survey measurement in parenthesis.

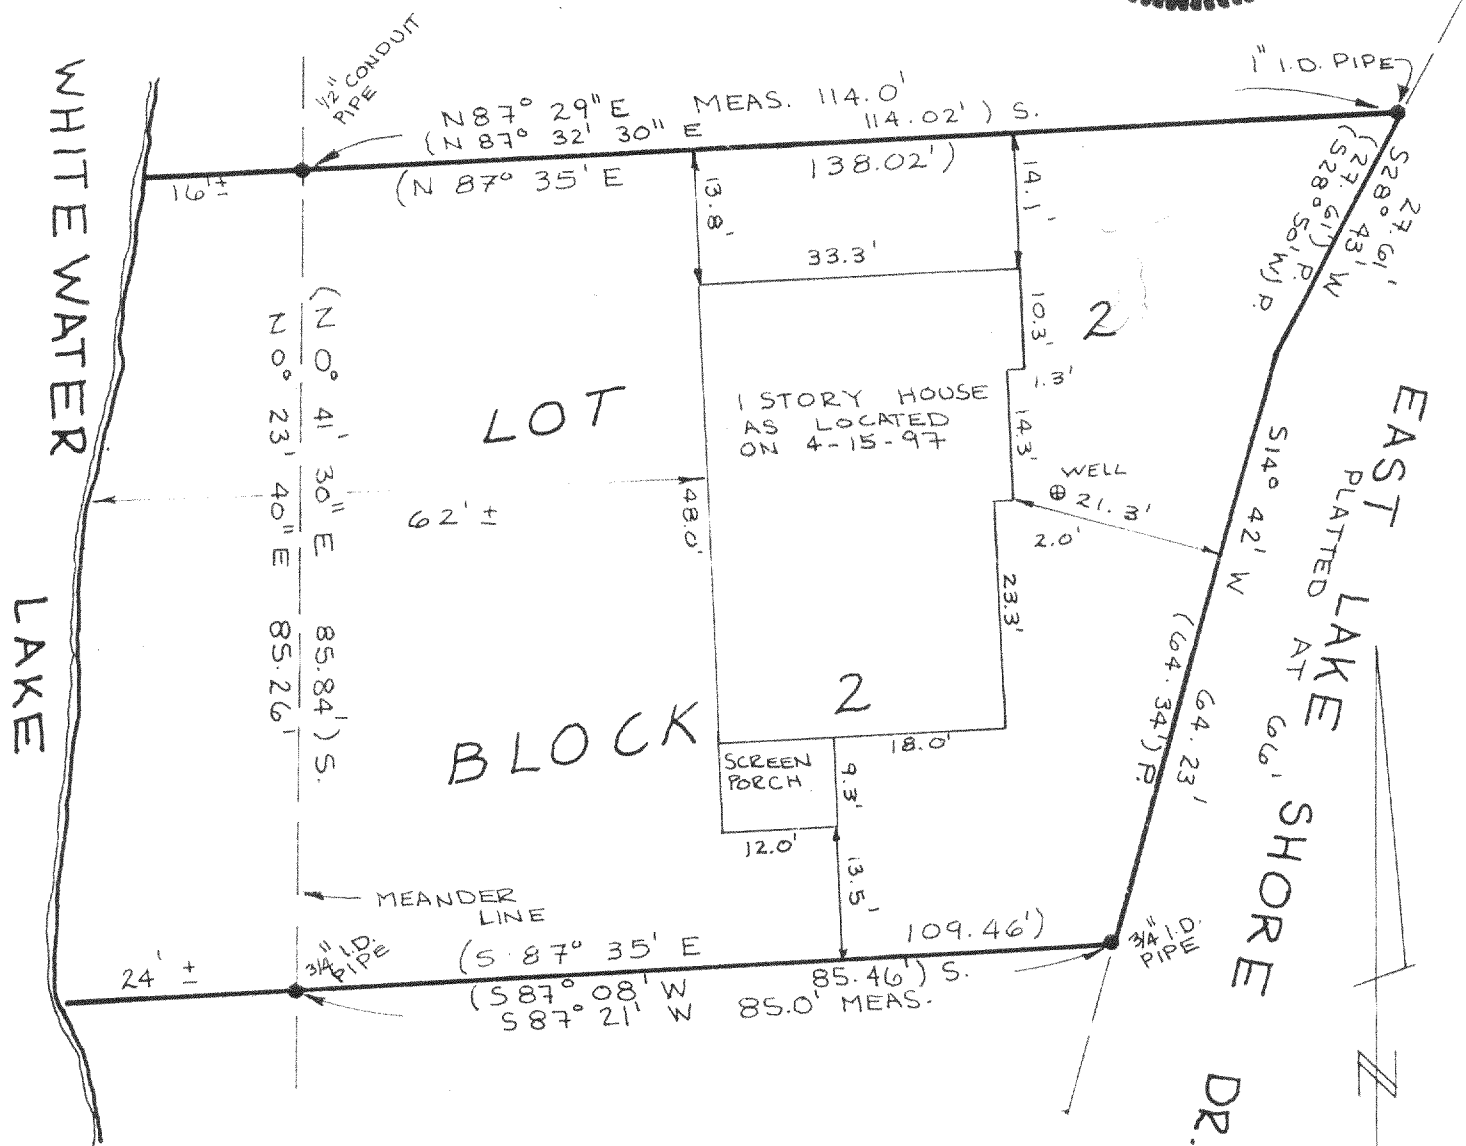

SURVEYOR'S CERTIFICATE


I hereby certify that I have prepared this map from a field survey conducted under my direction and control and that this map is a true representation of said field survey and shows the size and location of the property, the exterior boundary, the location and dimensions of all visible structures thereon, fences, apparent easements, roadways and visible encroachments, if any, and that this map and survey are correct to the best of my knowledge and belief,

SCALE: 1"=20'

Dated: Apr. 16, 1997

Glen L. Northrop S-982

ORDER NO. AB 2233-90
Drafted at ABEX Survey Company
101 E. Main St., P.O. Box 369
Cambridge, WI 53523
TEL: 608-423-3331

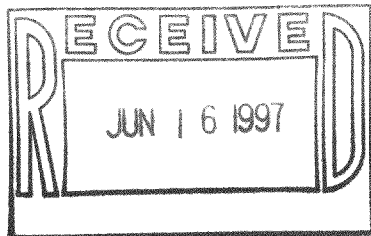

DRG. NO. 2233.1

SHEET 1 OF 1

DGS-11

45-589