


PLAT OF SURVEY

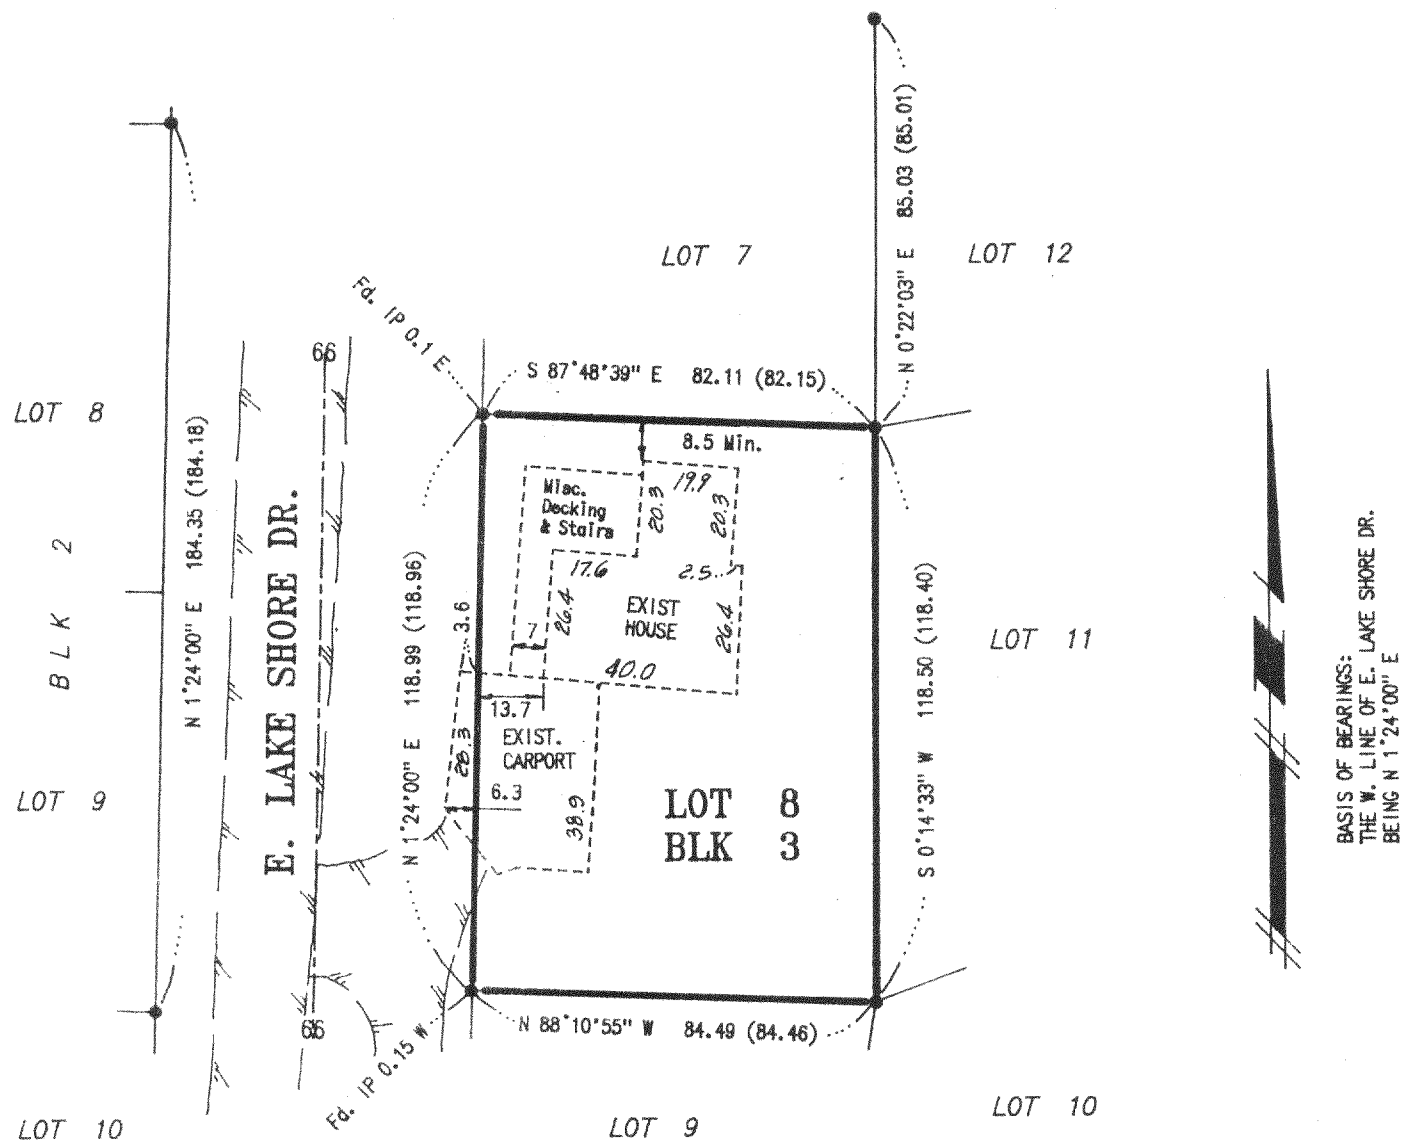

NOTES:


- () -- Indicates Record Distance
- -- Indicates Fd. 1" Iron Pipe

SURVEYOR'S CERTIFICATE

I, JAMES K. LANGONE, REGISTERED LAND SURVEYOR, CERTIFY THAT I HAVE SURVEYED THE PROPERTY DESCRIBED BELOW AND THAT THE PLAT SHOWN HEREON IS A CORRECT REPRESENTATION OF THE BOUNDARIES THEREOF.

DATE: 10/29/97


JAMES K. LANGONE
REGISTERED LAND SURVEYOR, S-1347

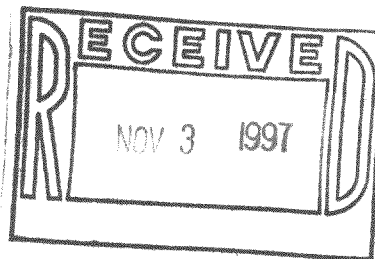

LEGAL DESCRIPTION:

IN THE SW 1/4, SEC. 25, T4N, R15E, IN THE TOWN OF WHITEWATER, WALWORTH COUNTY, WISCONSIN.

LOT 8, BLOCK 3, GUTZMER'S SUBDIVISION

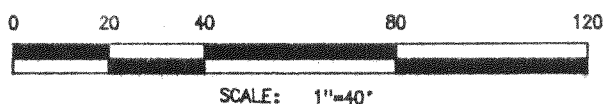

JAMES K. LANGONE
LAND SURVEYS & CIVIL ENGINEERING

N339 Co. Rd. "N" (Upper)

Whitewater, WI. 53190-2842

(414) 473-4119

10/20/97
JN: 97-146

DGD-26

415-610