


PLAT OF SURVEY

LEGAL DESCRIPTION

Lot 10 of Block 2 of Minnieska Subdivision, Located in the Northeast 1/4 of Section 35, Town 4 North, Range 15 East, Town of Whitewater, County of Walworth, State of Wisconsin.

Owner: Micheal Chance
578 Woodland Ave.
Northfield, Illinois 60093

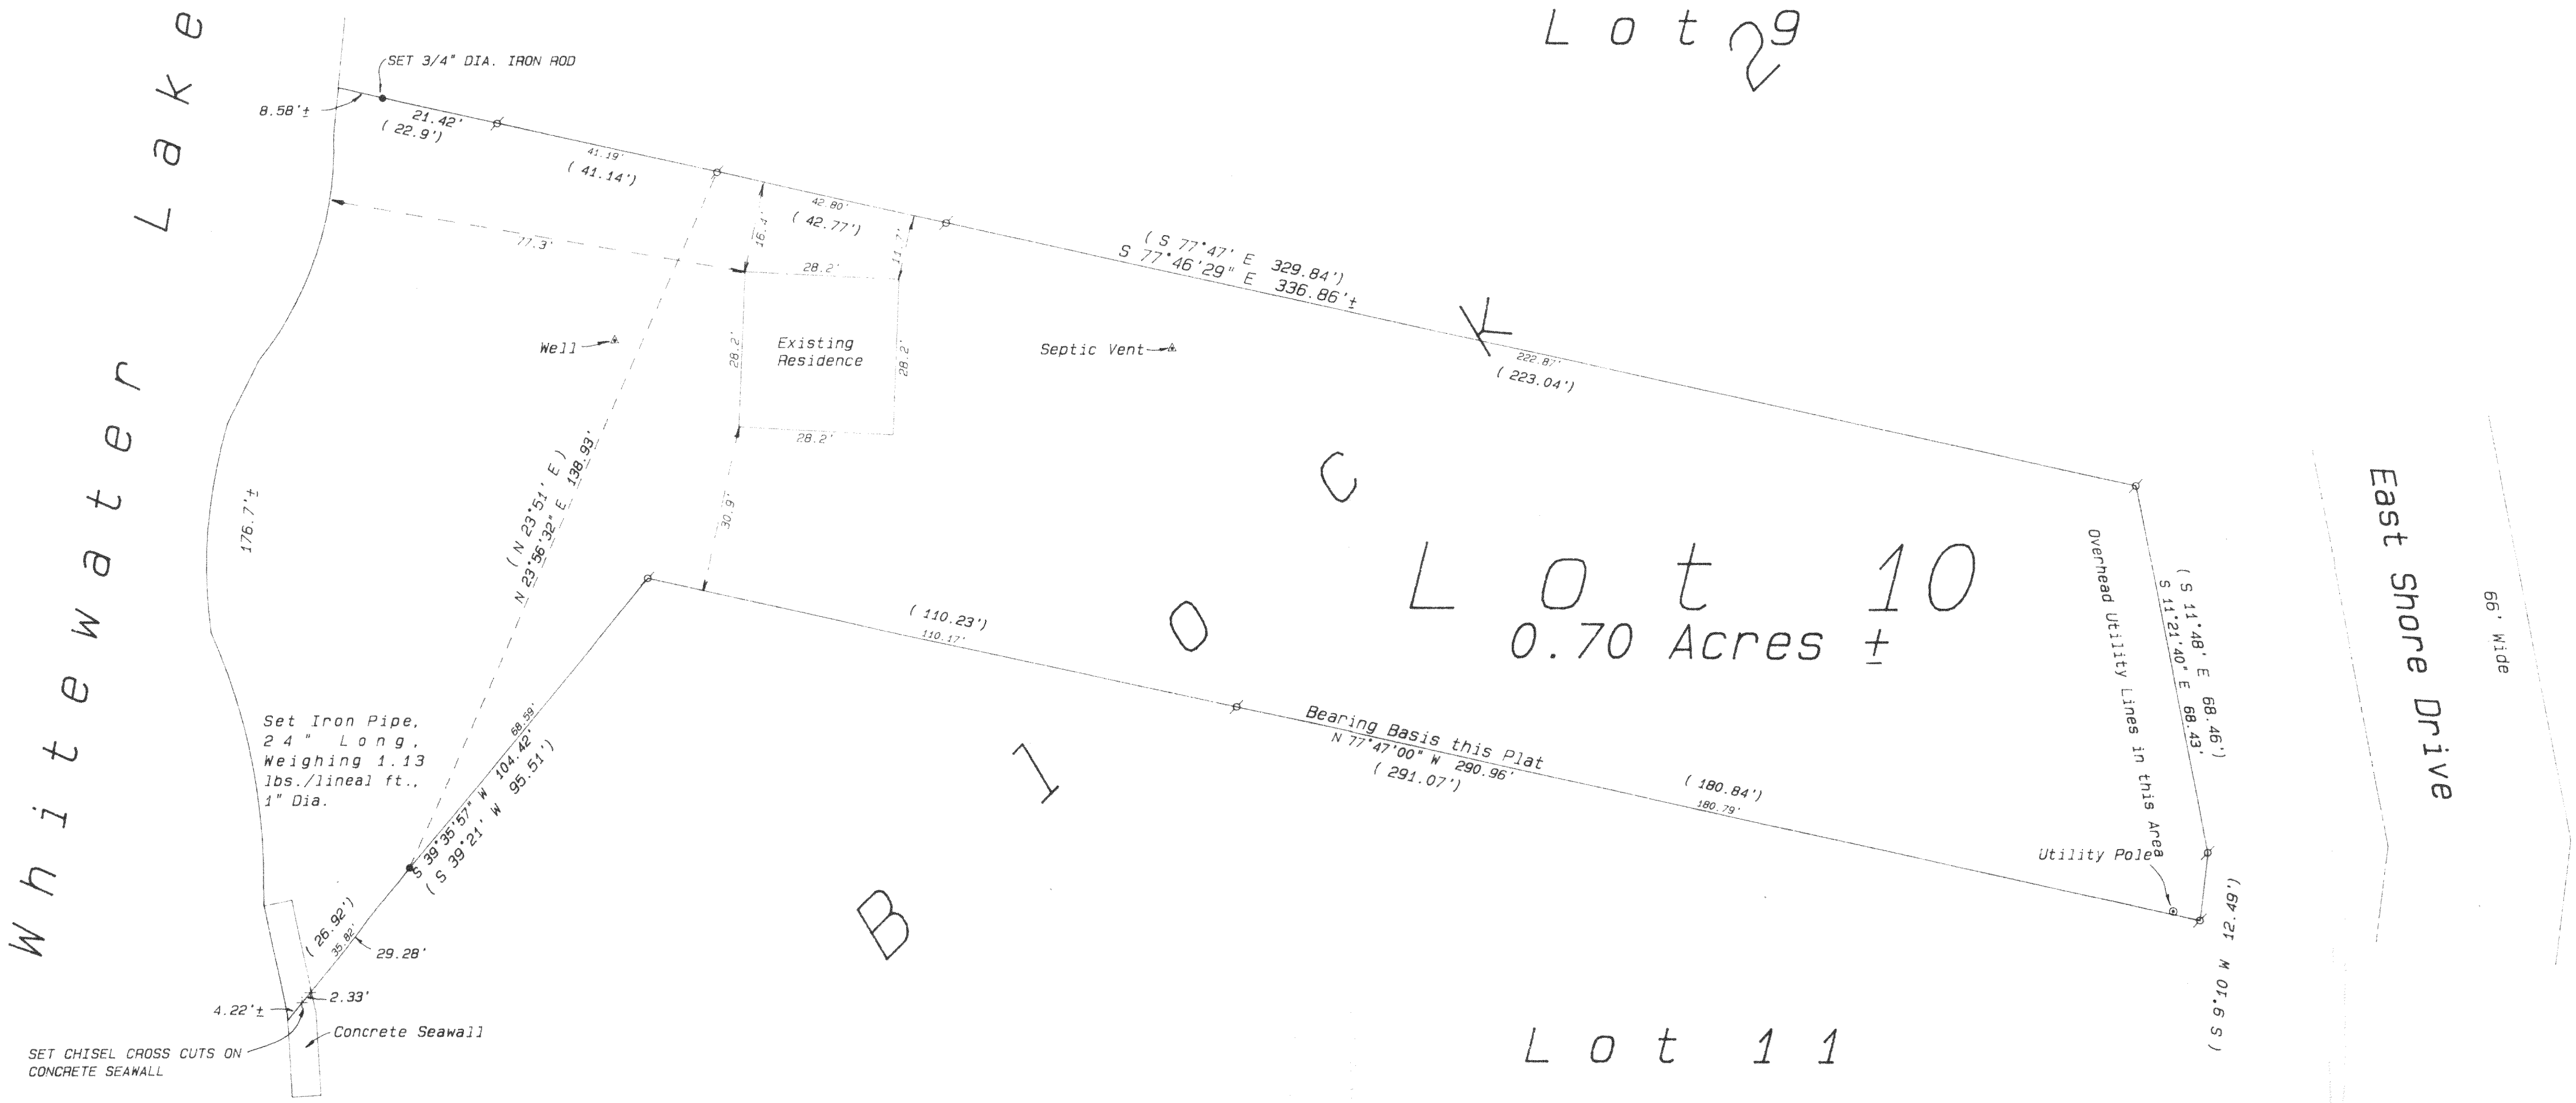


- Legend
- FOUND IRON PIPE
 - FOUND IRON ROD
 - FOUND BRASS CAPPED MONUMENT
 - FOUND CONCRETE MONUMENT
 - CHISEL CUT IN CONCRETE
 - SET IRON ROD, 24" LONG, WEIGHING 1.5 LBS LINEAL FT., 3/4" DIA.
 - SET IRON ROD, 36" LONG, WEIGHING 4.5 LBS LINEAL FT., 1 1/8" DIA.
 - RECORDED AS DIMENSION
 - EXISTING FENCE



SCALE: 1"= 20 FEET

PLAT WAS REVISED ON SEPTEMBER 30, 1997 TO SHOW ADDITIONAL MONUMENTATION NEAR THE SHORELINE AND TO RELOCATE AND MARK EXTERIOR CORNERS.

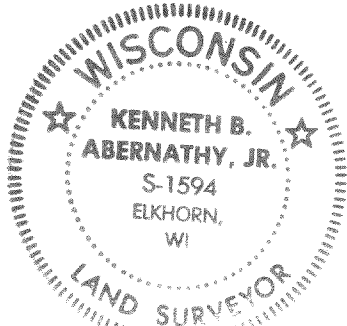

I hereby certify that the above described property has been surveyed by me or under my direction and that the above map is a true representation thereof and shows the size and location of the property, its exterior boundaries, the location of all visible structures and dimensions of all principal buildings thereon, boundary fences, apparent easements, roadways and visible encroachments, if any. This survey is made for the use of the present owners of the property and also those who purchase, mortgage, or guarantee the title thereto within one year from date hereof.

Kenneth B. Abernathy, Jr.
KENNETH B. ABERNATHY, JR.
WISCONSIN REGISTERED LAND SURVEYOR,
S-1594
Date: April 21, 1992 Job No. 415-622 DM-33