

ABERNATHY and ASSOCIATES

Kenneth B. Abernathy Jr.

Wisconsin Registered Land Surveyor S-1594

W4056 Bray Road
Elkhorn, Wisconsin 53121
Phone: (414) 723-4260 (office)
(414) 723-7209 (fax)

PLAT OF SURVEY

LOT 23, BLOCK 2, MORaine HEIGHTS
SUBDIVISION, LOCATED IN THE NW
1/4 OF SECTION 35, TOWN 4 NORTH,
RANGE 15 EAST, TOWN OF
WHITEWATER, WALWORTH COUNTY,
WISCONSIN.

OWNERS: JOHN AND SUSAN ZARUBA
614 N. KENILWORTH AVE.
OAK PARK, ILL. 60302




Legend

- FOUND IRON PIPE
- FOUND IRON ROD
- FOUND BRASS CAPPED MONUMENT
- FOUND CONCRETE MONUMENT
- CHISEL CUT IN CONCRETE
- SET IRON ROD, 24" LONG, WEIGHING 1.5 LBS., LINEAL FT., 3/4" DIA.
- SET IRON ROD, 30" LONG, WEIGHING 4.5 LBS., LINEAL FT., 1-1/16" DIA.
- RECORDED AS DIMENSION
- EXISTING FENCE

SCALE 1" = 10 FEET

BEARINGS ARE REFERENCED TO THE
RECORDED SUBDIVISION PLAT

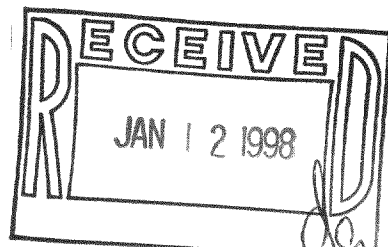

SCALE: 1" = 10 FEET

I hereby certify that the above described property has been surveyed
by me or under my direction and that the above map is a true
representation thereof and shows the size and location of the property,
its exterior boundaries, the location of all visible structures and
dimensions of all principal buildings thereon, boundary fences, apparent
easements, roadways and visible encroachments, if any.
This survey is made for the use of the present owners of the property,
and also those who purchase, mortgage, or guarantee the title thereto
within one year from date hereof.


Kenneth B. Abernathy, Jr.

KENNETH B. ABERNATHY, JR.

S-1594

WISCONSIN REGISTERED LAND SURVEYOR

Date: 12-3-97 Job No. 97.1106

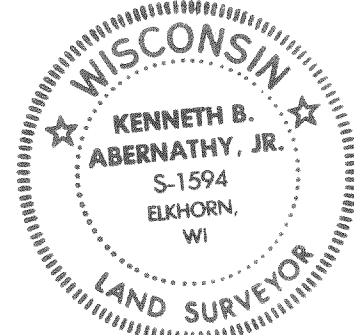

DMH-SL
HIS-635