


# PLAT OF SURVEY

LOT 9, THORNE HEIGHTS, LOCATED IN THE SOUTHEAST 1/4 AND IN THE SOUTHWEST 1/4 OF SECTION 35, TOWN 4 NORTH, RANGE 15 EAST, OF THE 4TH P.M., WALWORTH COUNTY, WISCONSIN.


SURVEYED FOR: CHARLES BARR

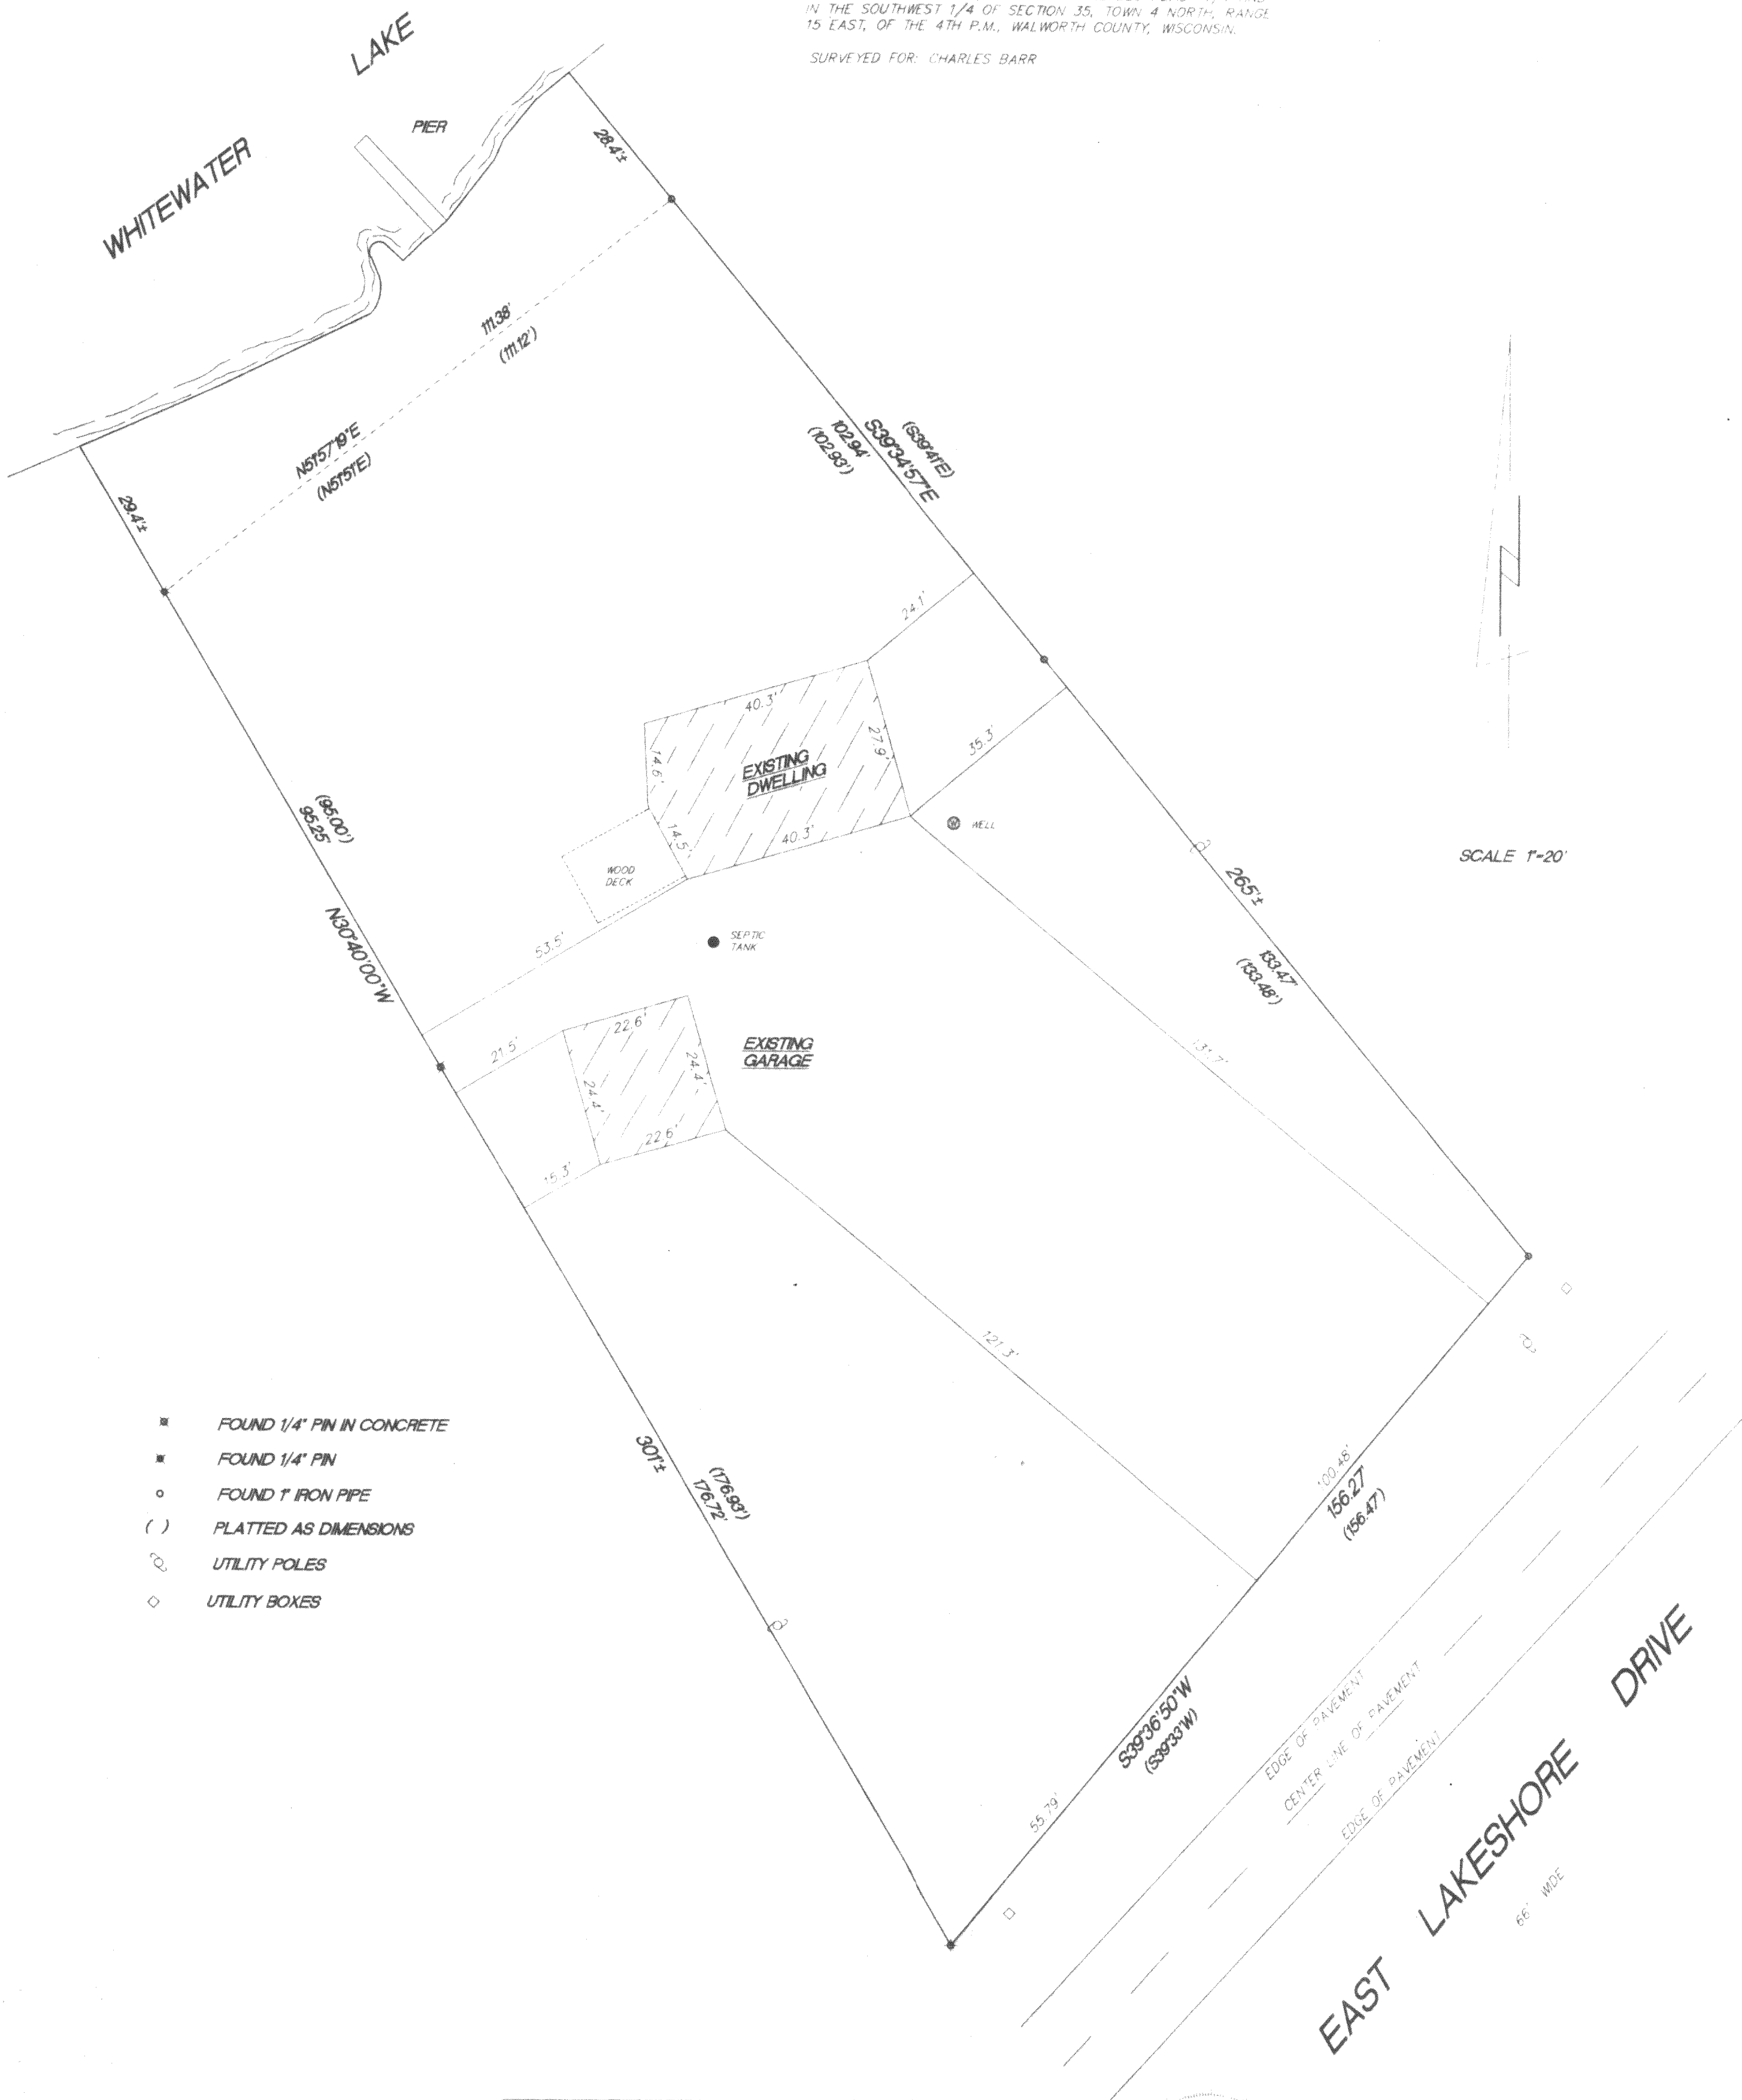

Kettle Moraine Surveying  
W358 99050 Godfrey Lane  
P.O. Box 357  
Eagle WI. 53119  
594-3484

7/20/99 DATE  
TEP/DW FIELD WORK BY  
TEP DRAWN BY  
99187 JOB NUMBER

THIS IS NOT AN ORIGINAL SURVEY UNLESS THE SEAL IS RED.

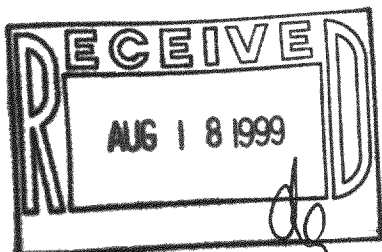

DTH-9  
415-703