


COPY PART
OF TAX LISTOR'S
MAP


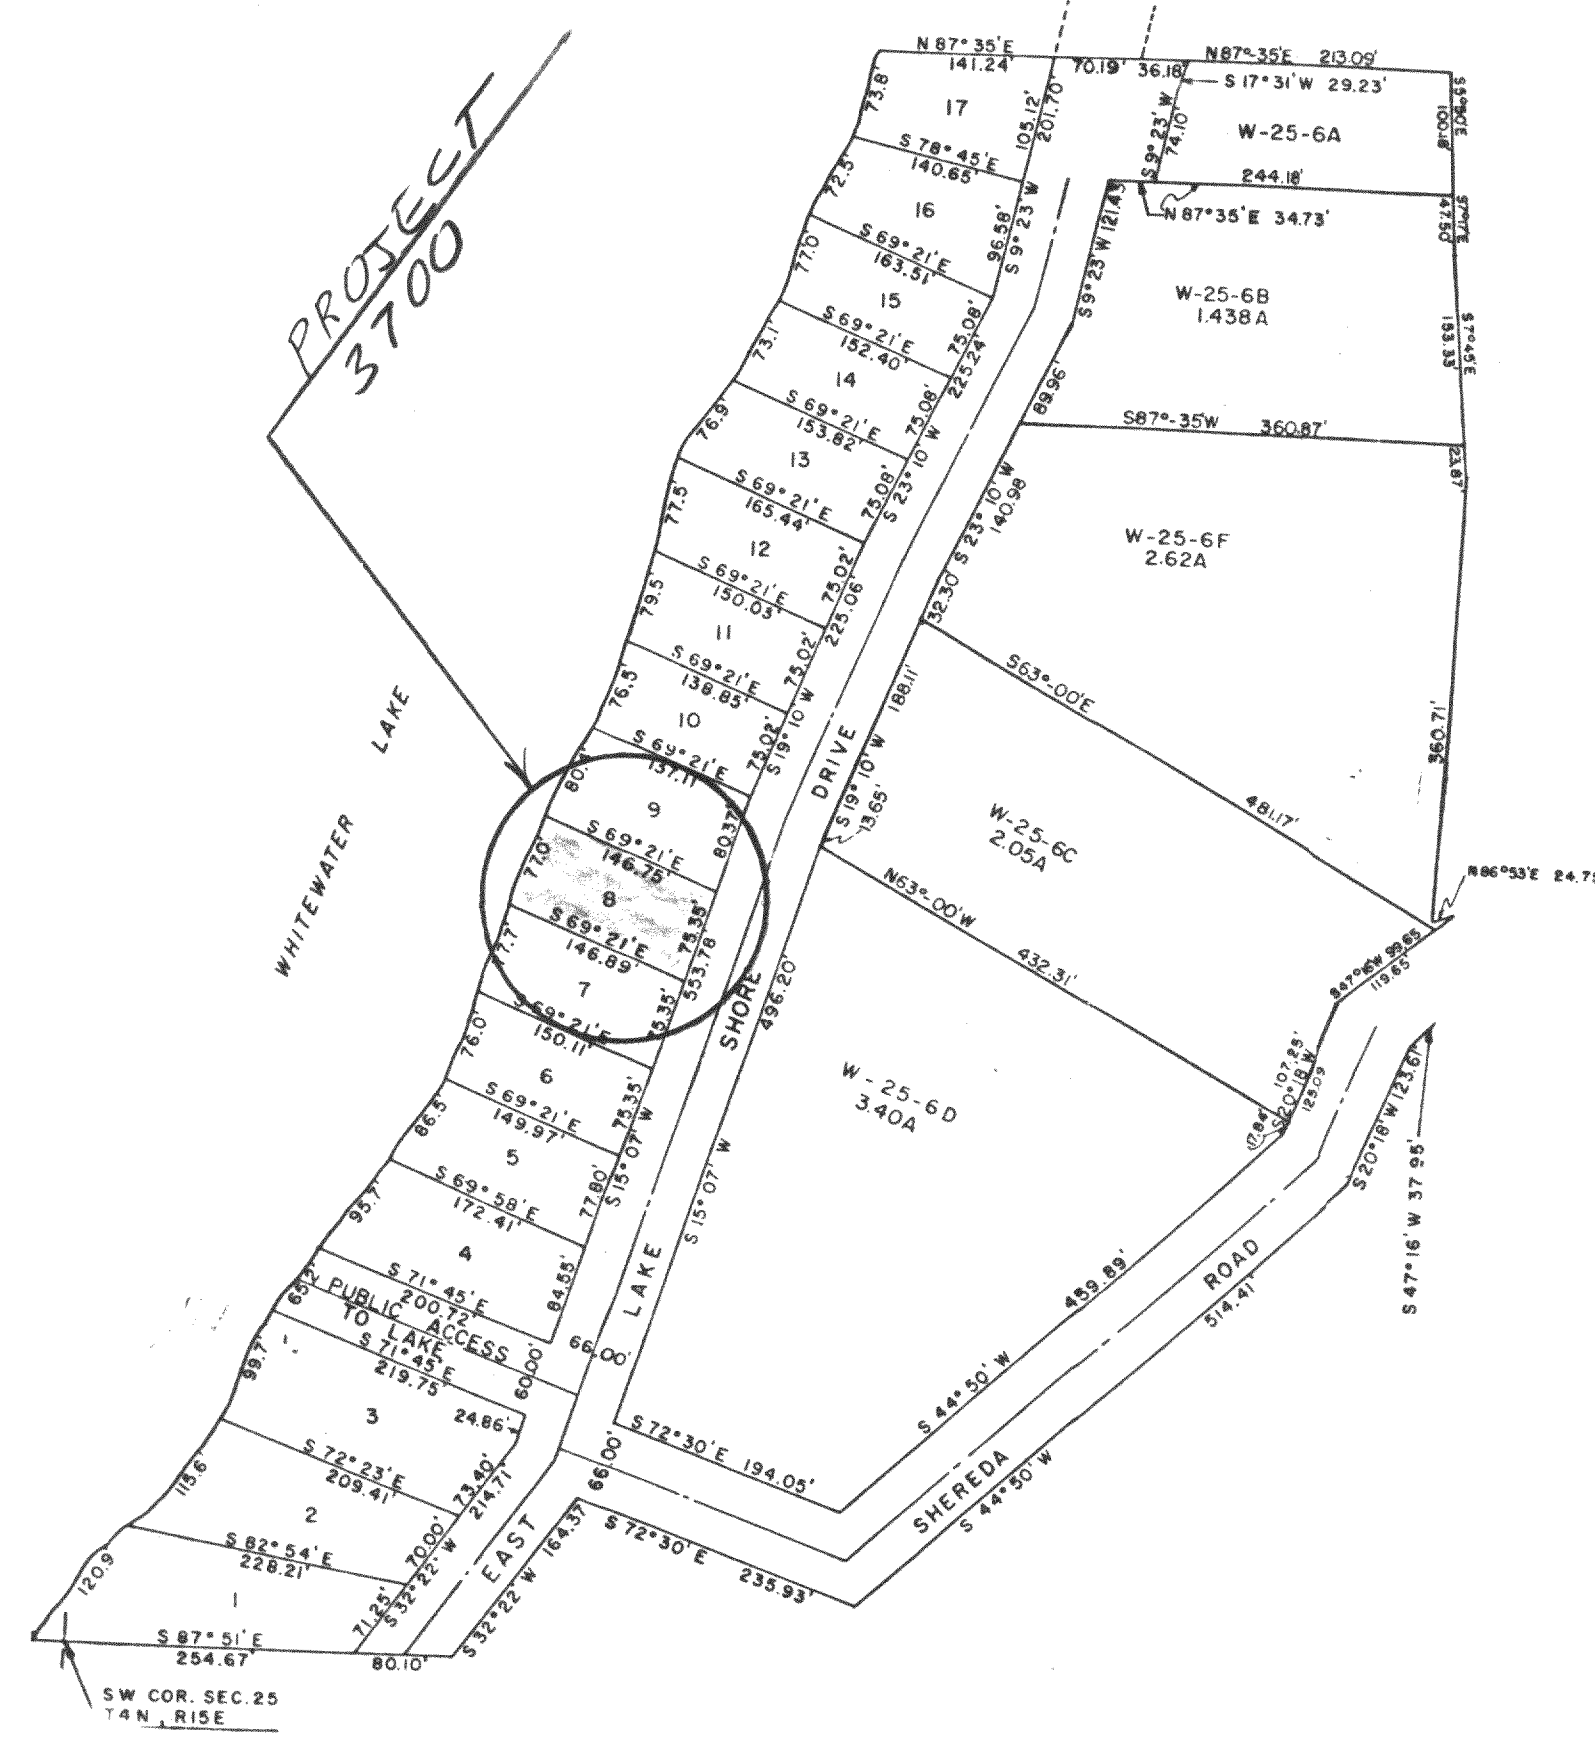


I HEREBY CERTIFY THIS PLAT TO BE A
TRUE AND ACCURATE REPRESENTATION OF THE
BOUNDARY LINES AND BUILDING LOCATIONS
TO THE BEST OF MY PROFESSIONAL KNOWLEDGE
AND BELIEF.


DATED

9/3/99

Peter S. Gordon
PETER S. GORDON

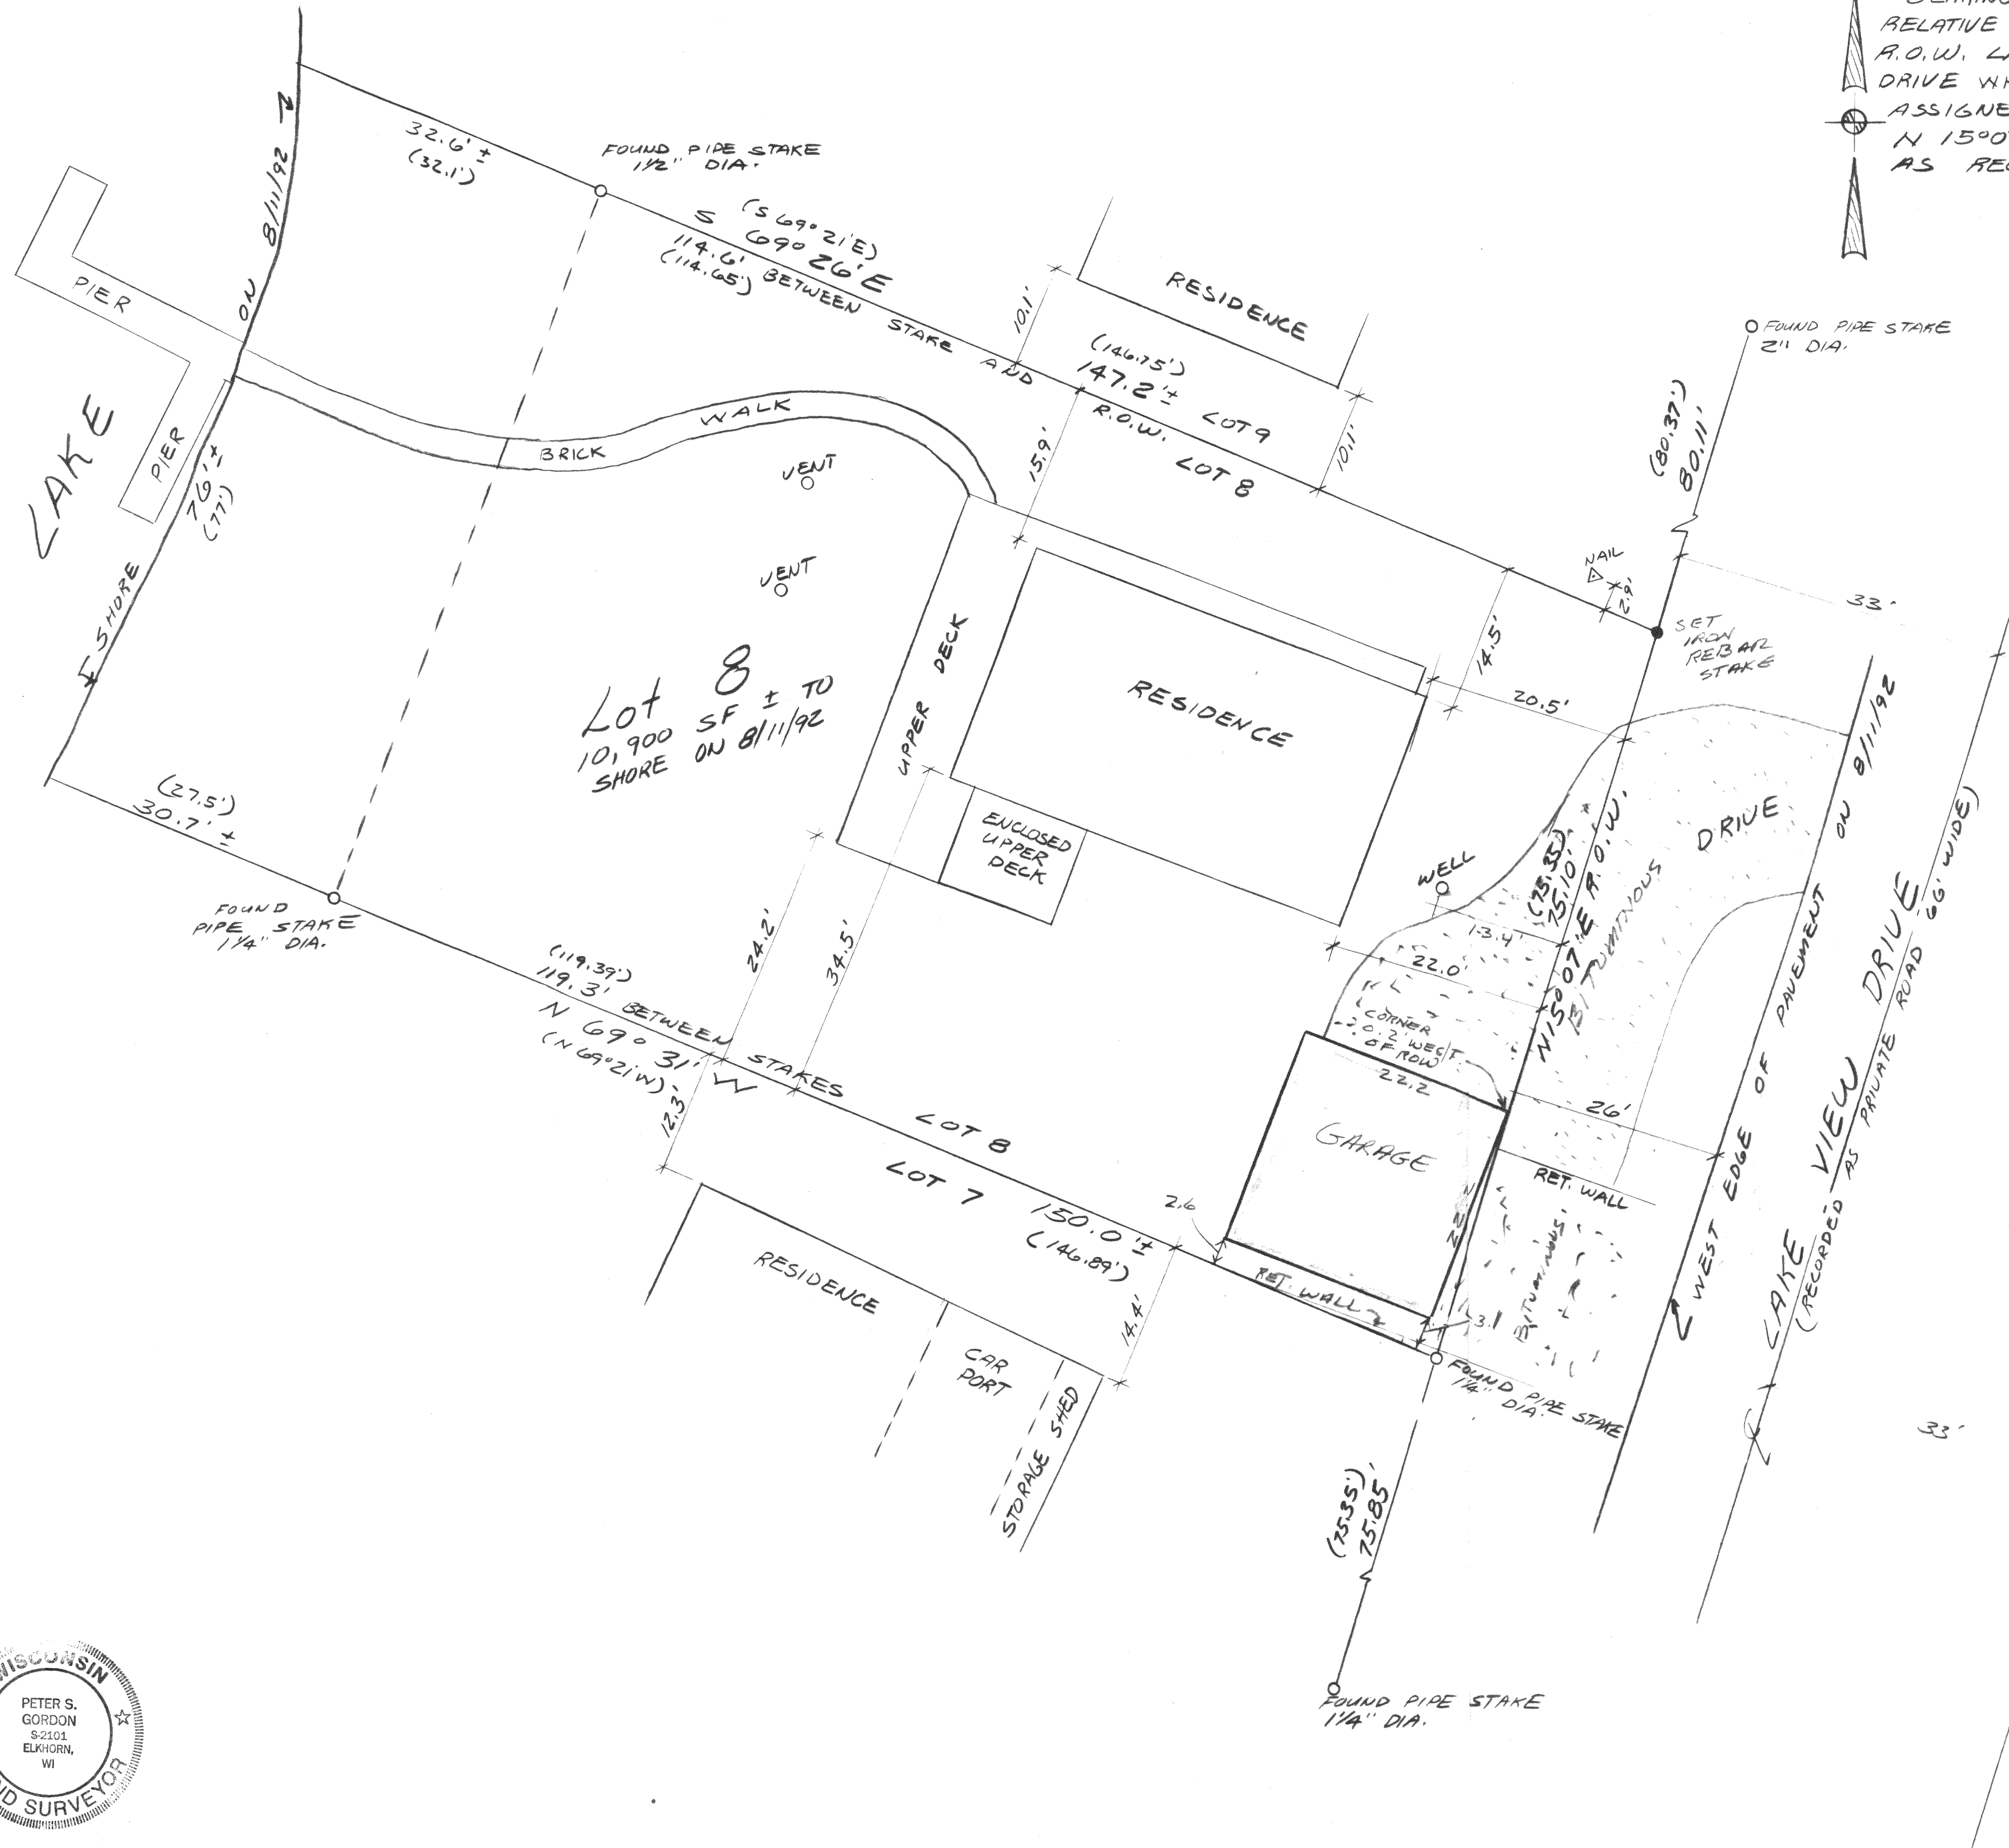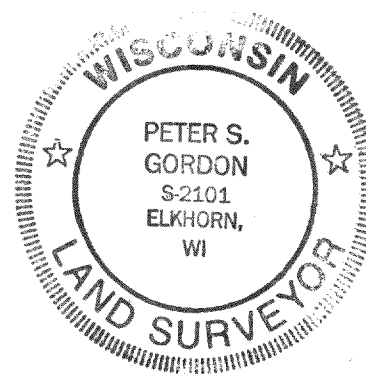

BEARINGS MEAS.
RELATIVE TO WEST
R.O.W. LAKE VIEW
DRIVE WHICH WAS
ASSIGNED
N 15°07'E
AS RECORDED

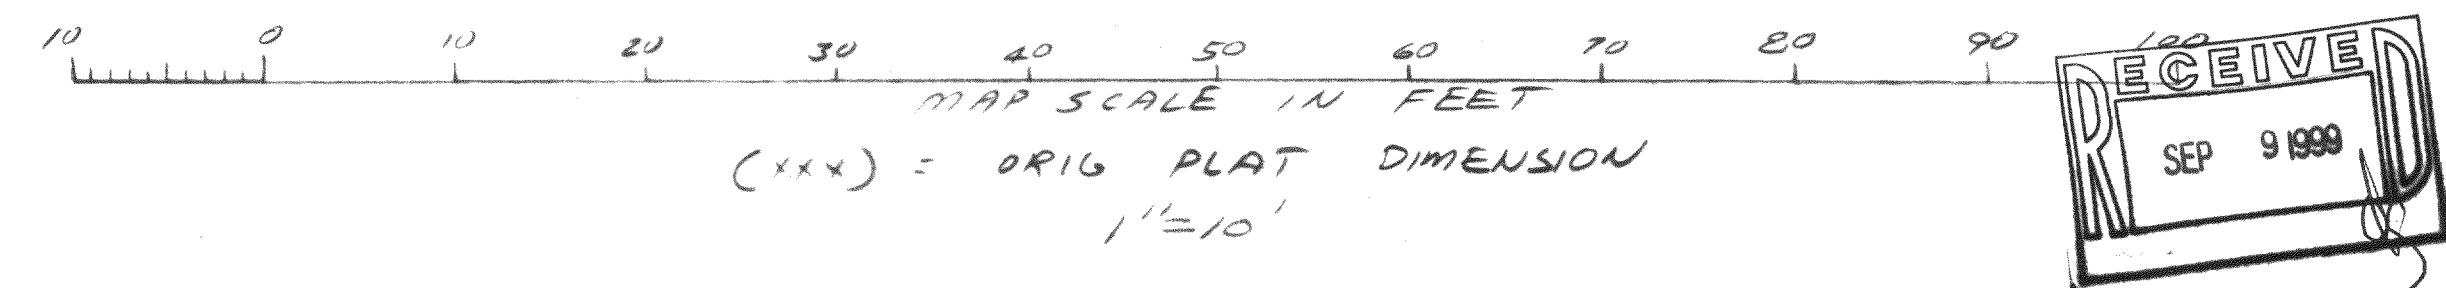

PLAT OF SURVEY
LOT 8 SHEREDA WOODS
IN SW 1/4 25-4-15
WALNORTH CO., WI.

WORK ORDERED BY
WILLIAM SPATES
N 7745 E LAKE SHORE DRIVE
WHITEWATER, WI.
53190

FARRIS, HANSEN & ASSOCIATES, INC.
Engineering, Architecture, Surveying
7 Ridgway Court P.O. Box 437
ELKHORN, WISCONSIN 53121
Office: (414) 723-2098
Fax: (414) 723-5886

REVISIONS
ORIG 8/12/92

PROJECT NO
3700
DATE
8/12/92
SHEET NO
1 of 1