
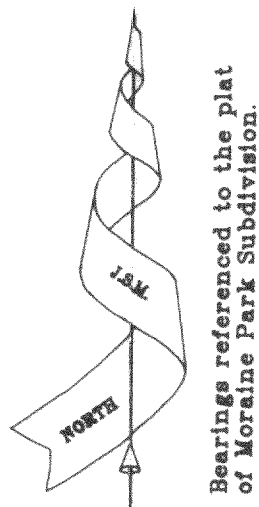




Plat of Survey

of
Lot 30 of Block 1 of Moraine Park Subdivision,
located in the Northwest 1/4 of Section 35, Town 4 North, Range 15
East, Town of Whitewater, Walworth County, Wisconsin.

Surveyed for: **James Pearson**
715 Windsor Road
Sugar Grove, Illinois. 60554

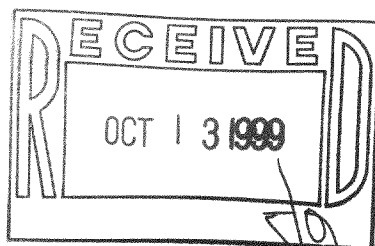

Bearings referenced to the plat
of Moraine Park Subdivision.

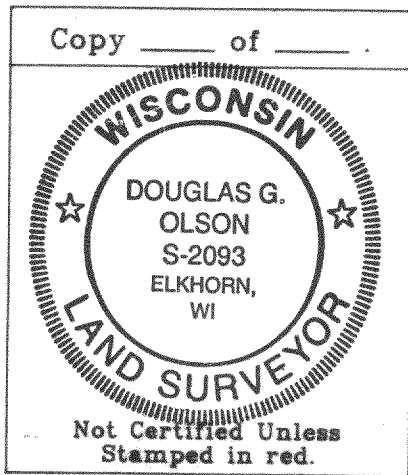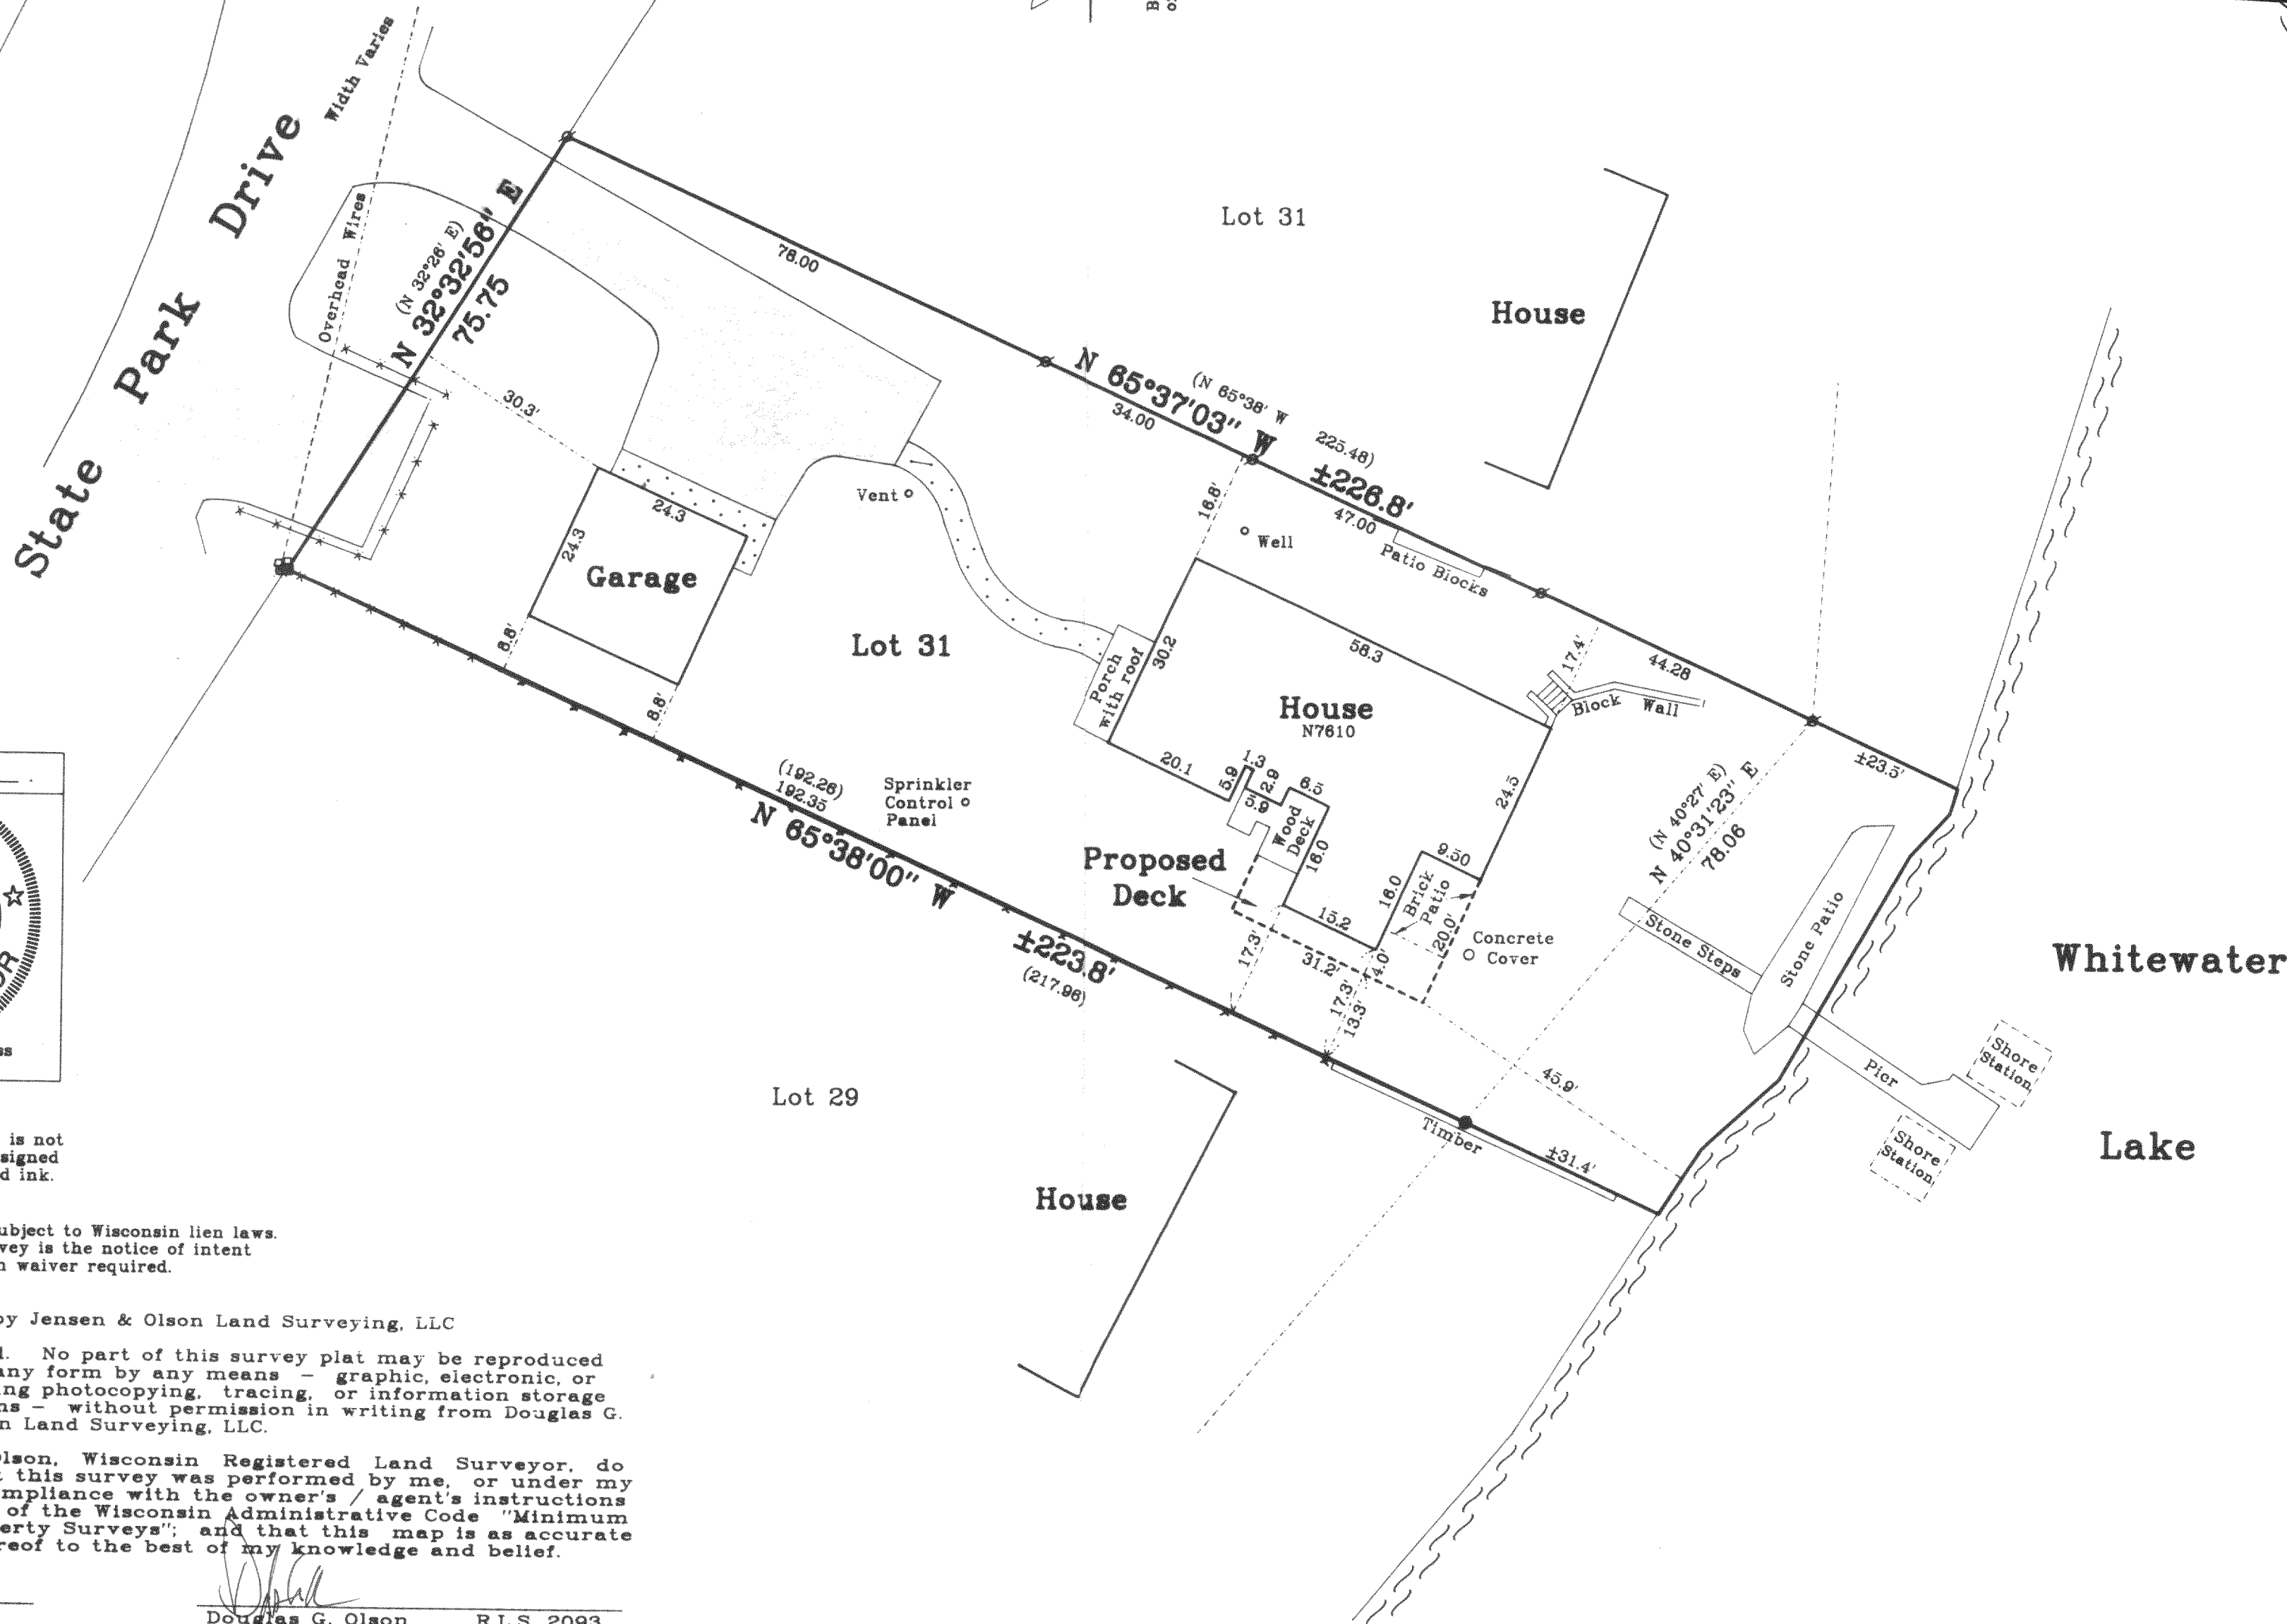

Note: This survey plat is not
certified unless signed
and sealed in red ink.

Note: This survey is subject to Wisconsin lien laws.
This Plat of Survey is the notice of intent
to file lien. Lien waiver required.

Copyright © 1999 by Jensen & Olson Land Surveying, LLC

All rights reserved. No part of this survey plat may be reproduced
or transmitted in any form by any means - graphic, electronic, or
mechanical, including photocopying, tracing, or information storage
and retrieval systems - without permission in writing from Douglas G.
Olson, Jensen & Olson Land Surveying, LLC.

I, Douglas G. Olson, Wisconsin Registered Land Surveyor, do
hereby certify that this survey was performed by me, or under my
direction in full compliance with the owner's / agent's instructions
and Chapter A-E 7 of the Wisconsin Administrative Code "Minimum
Standards for Property Surveys"; and that this map is as accurate
representation thereof to the best of my knowledge and belief.

Date: 9-16-99

Douglas G. Olson R.L.S. 2093

Mapping date: Sept. 16, 1999.

Revisions:

Scale in Feet
1" = 20'



Jensen & Olson Land Surveying, LLC

45 South Wisconsin Street P.O. Box 322
Elkhorn, Wisconsin. 53121
Telephone: (414) 723-3434
Facsimile: (414) 723-8044

Legend

- Found Concrete Monument
- Found Iron Pipe
- Found Iron Rod
- Recorded Information
- Utility Pole
- Concrete Pedestal
- Wood Fence

Sheet 1 of 1 Sheets.

Job Reference Number

1999.100

1999.100

DMP-28
415-719