

PLAT OF SURVEY

ORDERED BY: ED McCULLEY
SKANDIA REALTY, INC.
822 E. GENEVA
DELAVER, WI. 53115

OWNERS: JAMES & DOLORES MULRY
W7692 SHAGBARK ROAD
WHITEWATER, WI. 53190

CENTERLINE INGRESS & EGRESS EASEMENT
VOL. 170, PAGE 369 OF RECORDS, DOC # 9459

20' WIDE

POND

GARAGE

WELL

SEPTIC

WOOD DECK

RESIDENCE

BLACKTOP DRIVE


LOT 13
63,804 SQ. FT. ±
1.47 ACRES ±

LOT 12


LOT 14

SHAGBARK ROAD
66' WIDE

BURROAK ROAD
66' WIDE

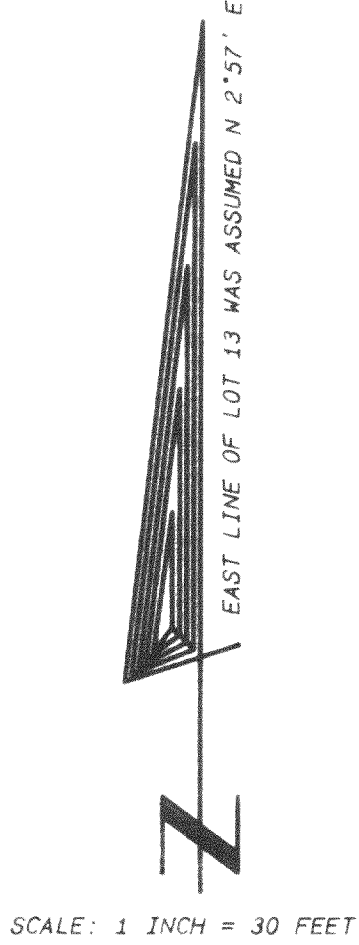

- Legend
- FOUND IRON PIPE
 - FOUND IRON ROD
 - FOUND BRASS CAPPED MONUMENT
 - FOUND CONCRETE MONUMENT
 - CHISEL CUT IN CONCRETE
 - SET IRON ROD, 24" LONG, WEIGHING 1.5 LBS. LINEAL FT. 3/4" DIA.
 - SET IRON ROD, 18" LONG, WEIGHING 4.5 LBS. LINEAL FT. 1 1/16" DIA.
 - RECORDED AS DIMENSION
 - EXISTING FENCE

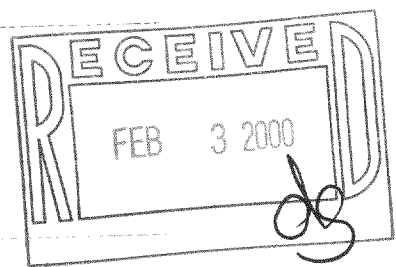

SCALE: 1" = 30 FEET



I hereby certify that the above described property has been surveyed by me or under my direction and that the above map is a true representation thereof and shows the site and location of the property, its exterior boundaries, the location of all visible structures and dimensions of all principal buildings, thereon, boundary fences, apparent easements, roadways and visible encroachments, if any.

This survey is made for the use of the present owners of the property, and also those who purchase, mortgage, or otherwise acquire the title thereto within one year from date hereof.

Kenneth B. Abernathy, Jr.
KENNETH B. ABERNATHY, JR.
WISCONSIN REGISTERED LAND SURVEYOR,
S-1594

Date: 10/11/99 Job No. 99.1001

415-736

DSO-13