


# PLAT OF TOPOGRAPHY

## OF

LOT 2 IN BLOCK 2 IN MORaine HEIGHTS  
TOWNSHIP 4 NORTH, RANGE 15,  
WALWORTH COUNTY, WISCONSIN

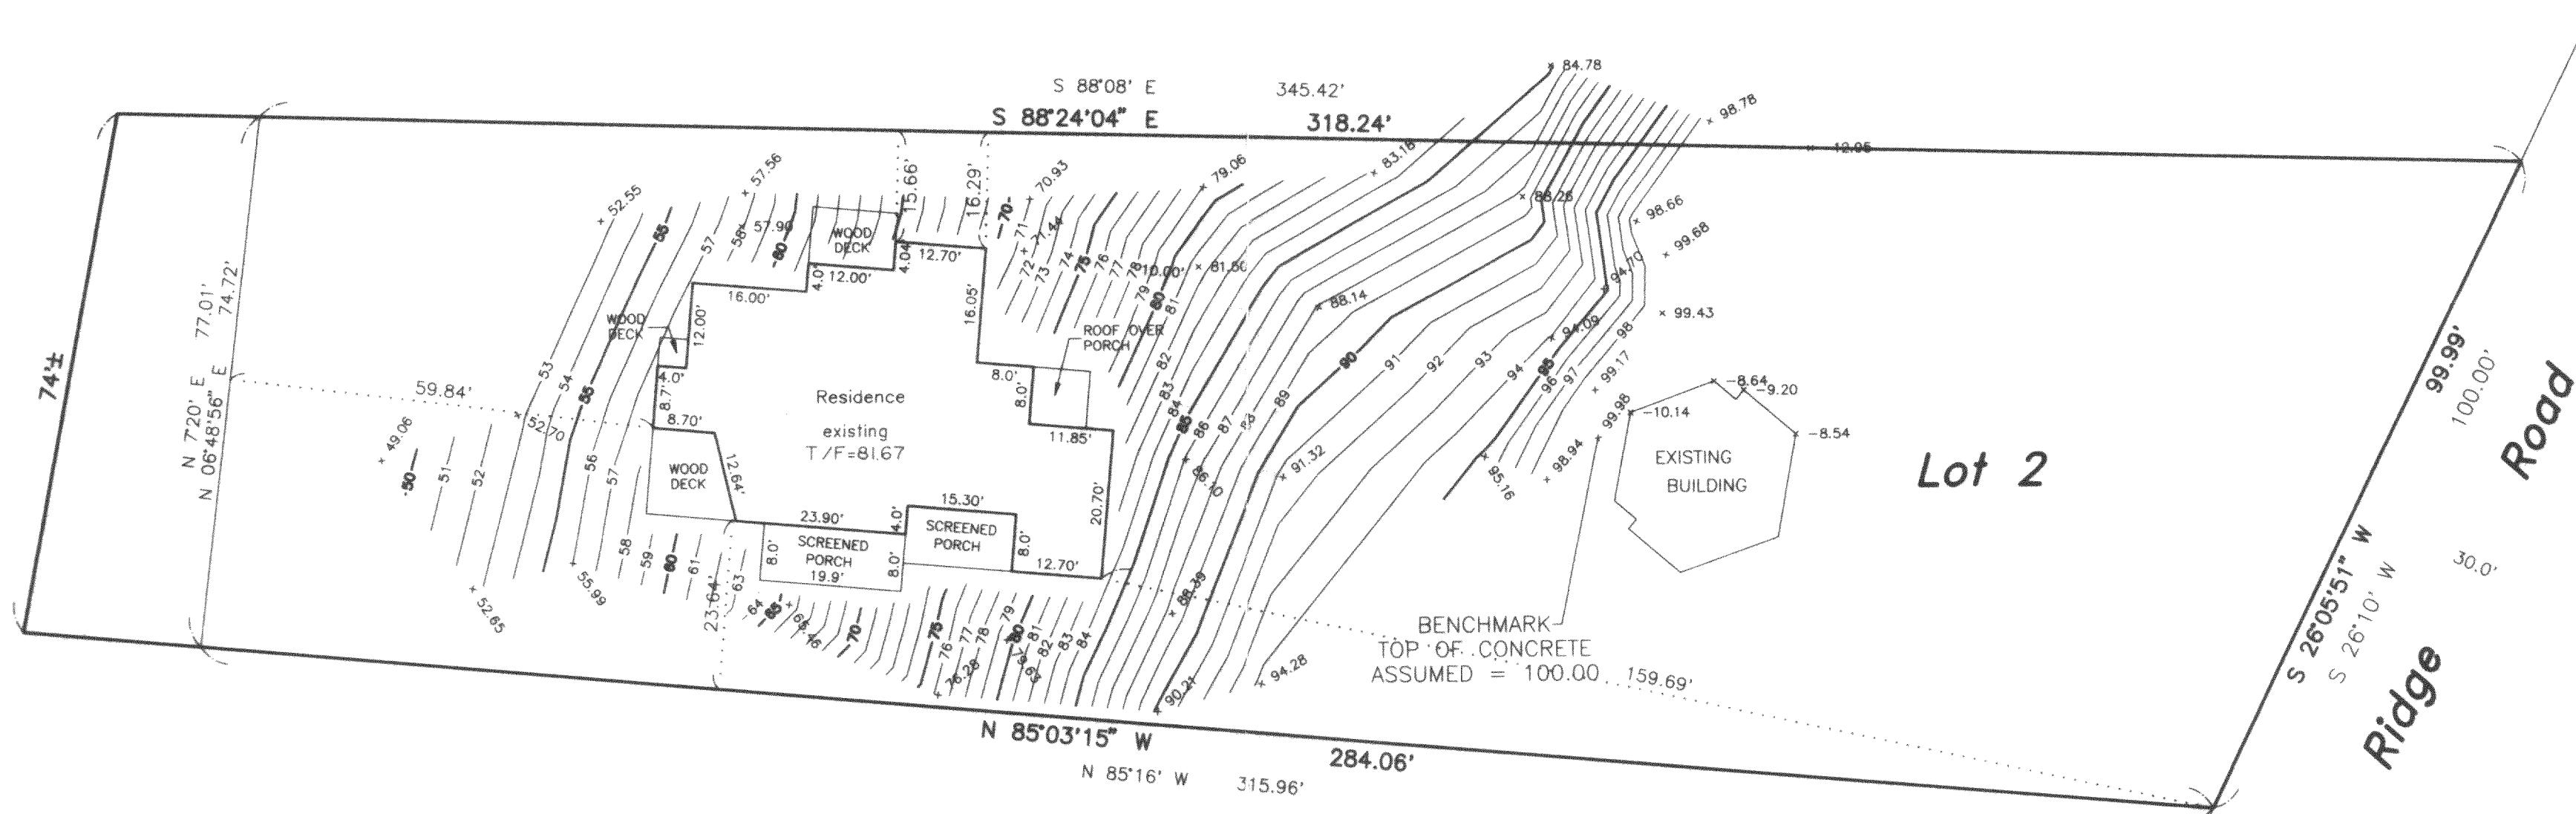

NOTES:  
PLAT IS VOID if the impressed Surveyors Seal does not appear.  
Only those Building Lines or Easements shown on a Recorded Subdivision  
Plat or from a Recorded Document are shown hereon; check local  
ordinances before building.

Compare your description and site markings with this plat and  
**AT ONCE** report any discrepancies which you may find.

STATE OF ILLINOIS  
COUNTY OF LAKE

68

PREPARED BY:

*Neil F. Lee*  
REGISTERED WISCONSIN LAND SURVEYOR  
DATED: SEPTEMBER 24, 1998

REGISTERED WISCONSIN LAND SURVEYOR  
DATED: SEPTEMBER 24, 1998

RESIDENCE LOCATED 09-15-99 N.J.

Scale: 1" = 20'

FILE NO. 181-98

**R.E. ALLEN AND ASSOCIATES, LTD.**  
PROFESSIONAL LAND SURVEYORS  
GRAYSLAKE 847-223-0914 ILLINOIS

# PLAT OF TOPOGRAPHY OF

LOT 2 IN BLOCK 2 IN MORaine HEIGHTS  
TOWNSHIP 4 NORTH, RANGE 15,  
WALWORTH COUNTY, WISCONSIN

