


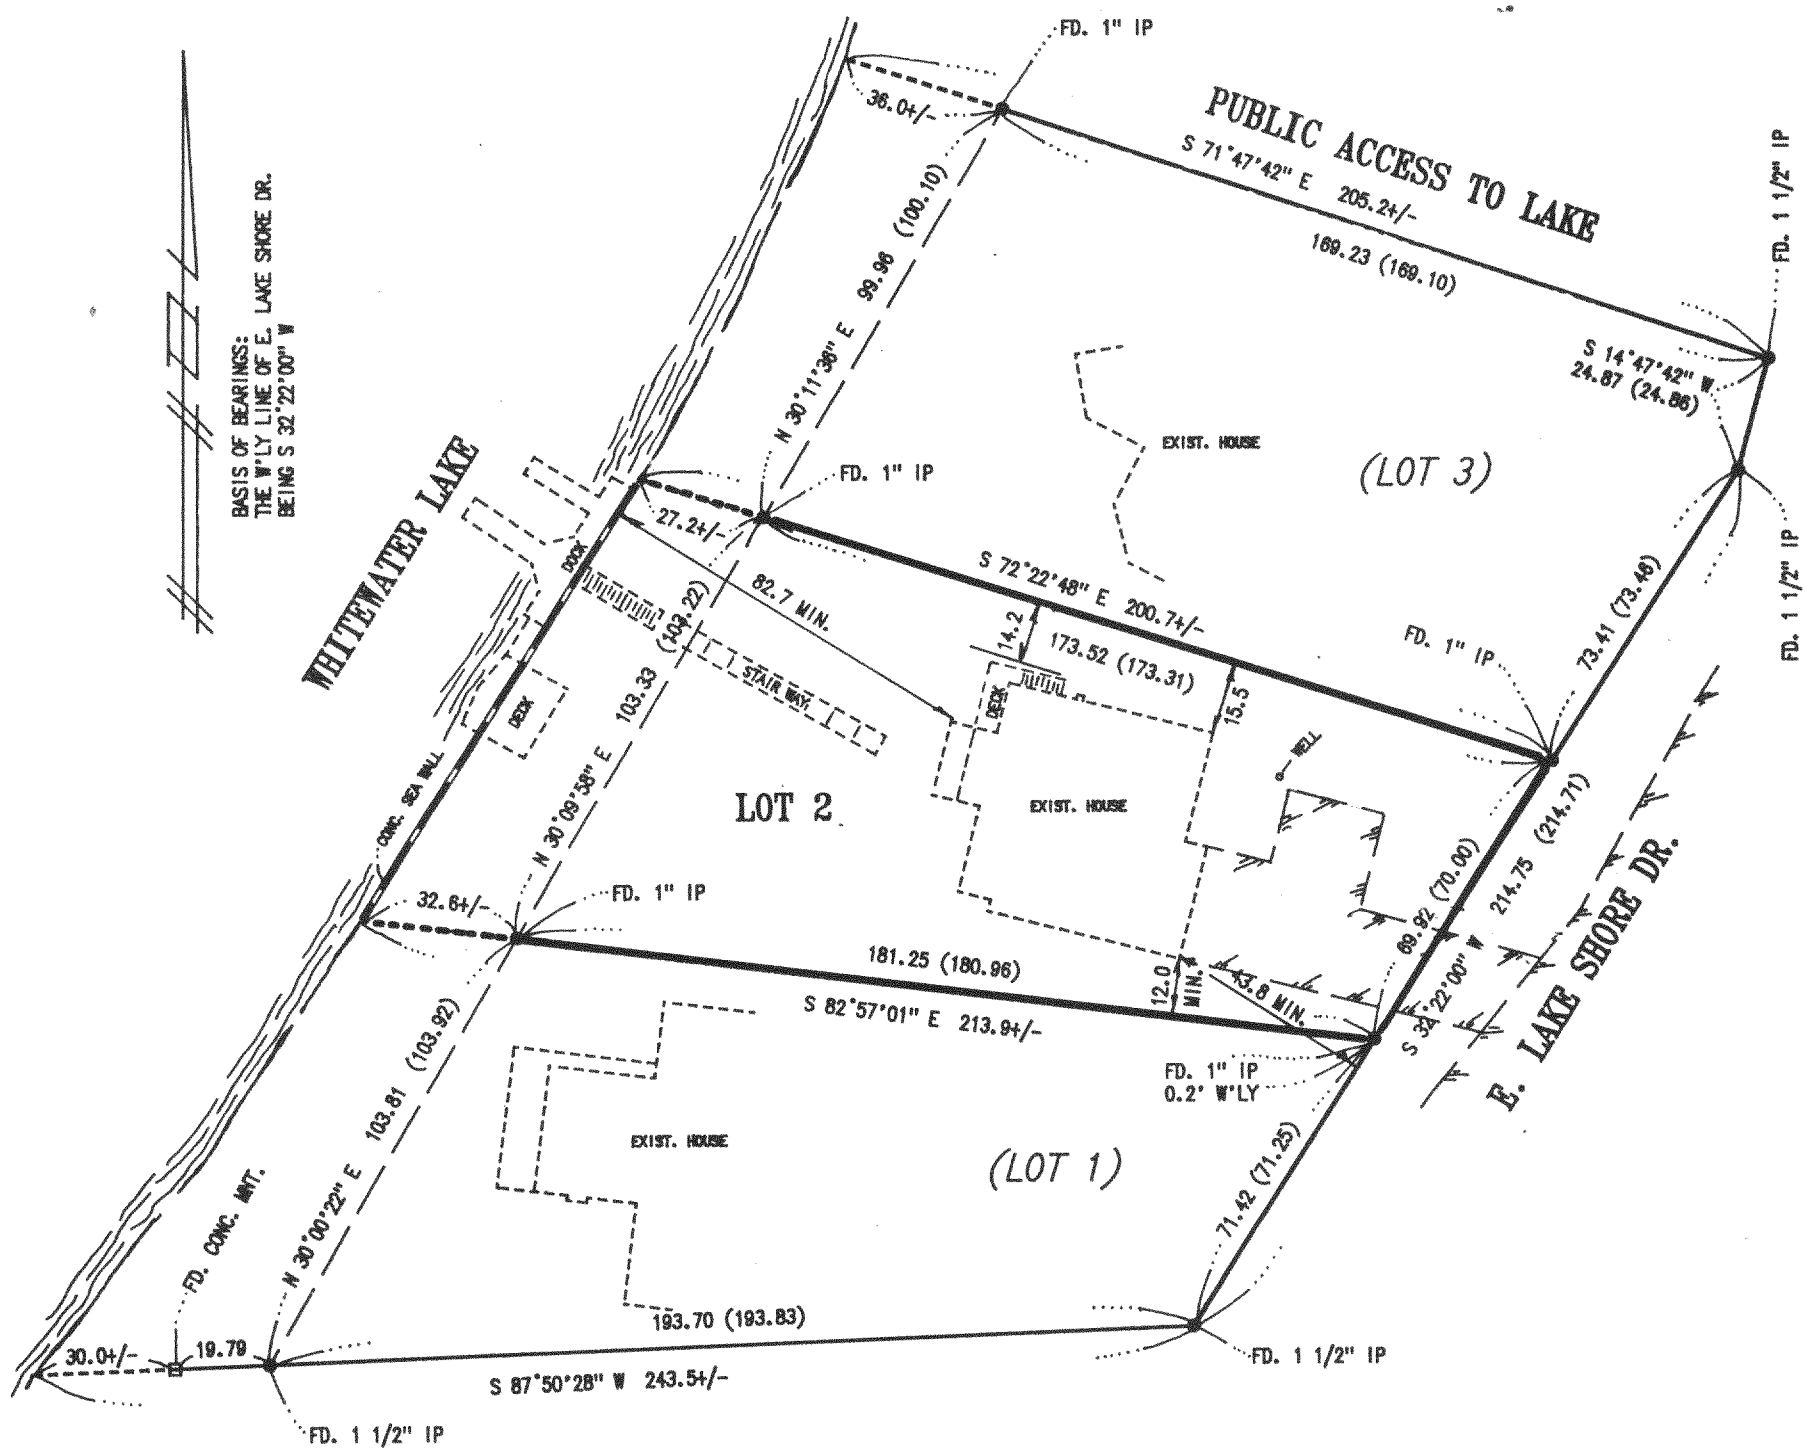

# SURVEYOR'S CERTIFICATE

I, JAMES K. LANGONE, REGISTERED LAND SURVEYOR, CERTIFY THAT I HAVE SURVEYED THE PROPERTY DESCRIBED HEREON AND THAT THIS PLAT IS A TRUE AND CORRECT REPRESENTATION OF THE BOUNDARIES THEREOF.

DATE: 3/7/00

JAMES K. LANGONE  
REGISTERED LAND SURVEYOR, S-1347





## LEGAL DESCRIPTION:

IN THE SW 1/4, SEC. 25, T4N, R15E, IN THE TOWN OF WHITewater, WALWORTH CO., WI.

LOT 2, SHEREDA WOODS

## NOTES:

- ( ) -- Indicates Record Data
- -- Indicates Mnt. FD. as Noted

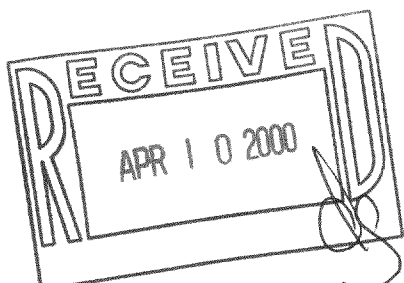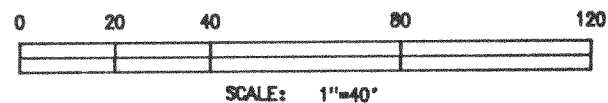

|                                                                                                                                              |                          |                 |
|----------------------------------------------------------------------------------------------------------------------------------------------|--------------------------|-----------------|
| <b>JAMES K. LANGONE</b><br><b>LAND SURVEYS &amp; CIVIL ENGINEERING</b><br>N339 Co. Rd. "N" (Upper) Whitewater, WI. 53190-2842 (262) 473-4119 |                          |                 |
| SCALE<br>1" = 40'                                                                                                                            | APPROVED BY<br><br>      | DRAWN BY<br>JKL |
| DATE<br>3/07/00                                                                                                                              | REVISED<br><br>          |                 |
| <b>PLAT OF SURVEY</b><br>LOT 2, SHEREDA WOODS                                                                                                |                          |                 |
| CLIENT<br>STRAND                                                                                                                             | DRAWING NUMBER<br>00-101 |                 |

JSW-2

415-745