

ABELL  
SURVEYING & MAPPING

1140 SEQUOIA STREET • DELAVAN, WISCONSIN 53115  
262-728-6737

NOTE: BEARINGS ARE REFERENCED TO THE  
RECORDED SUBDIVISION PLAT.


LOT 20

ORDERED BY: RE/MAX - HEARTLAND REALTY  
239 E. MILWAUKEE STREET  
WHITEWATER, WI 53190

SURVEYED BY WALWORTH COUNTY  
SURVEYING & MAPPING  
8/25/92

(N 89°46' W 104.81')

LOT 21  
AREA 0.22 ACRES ±

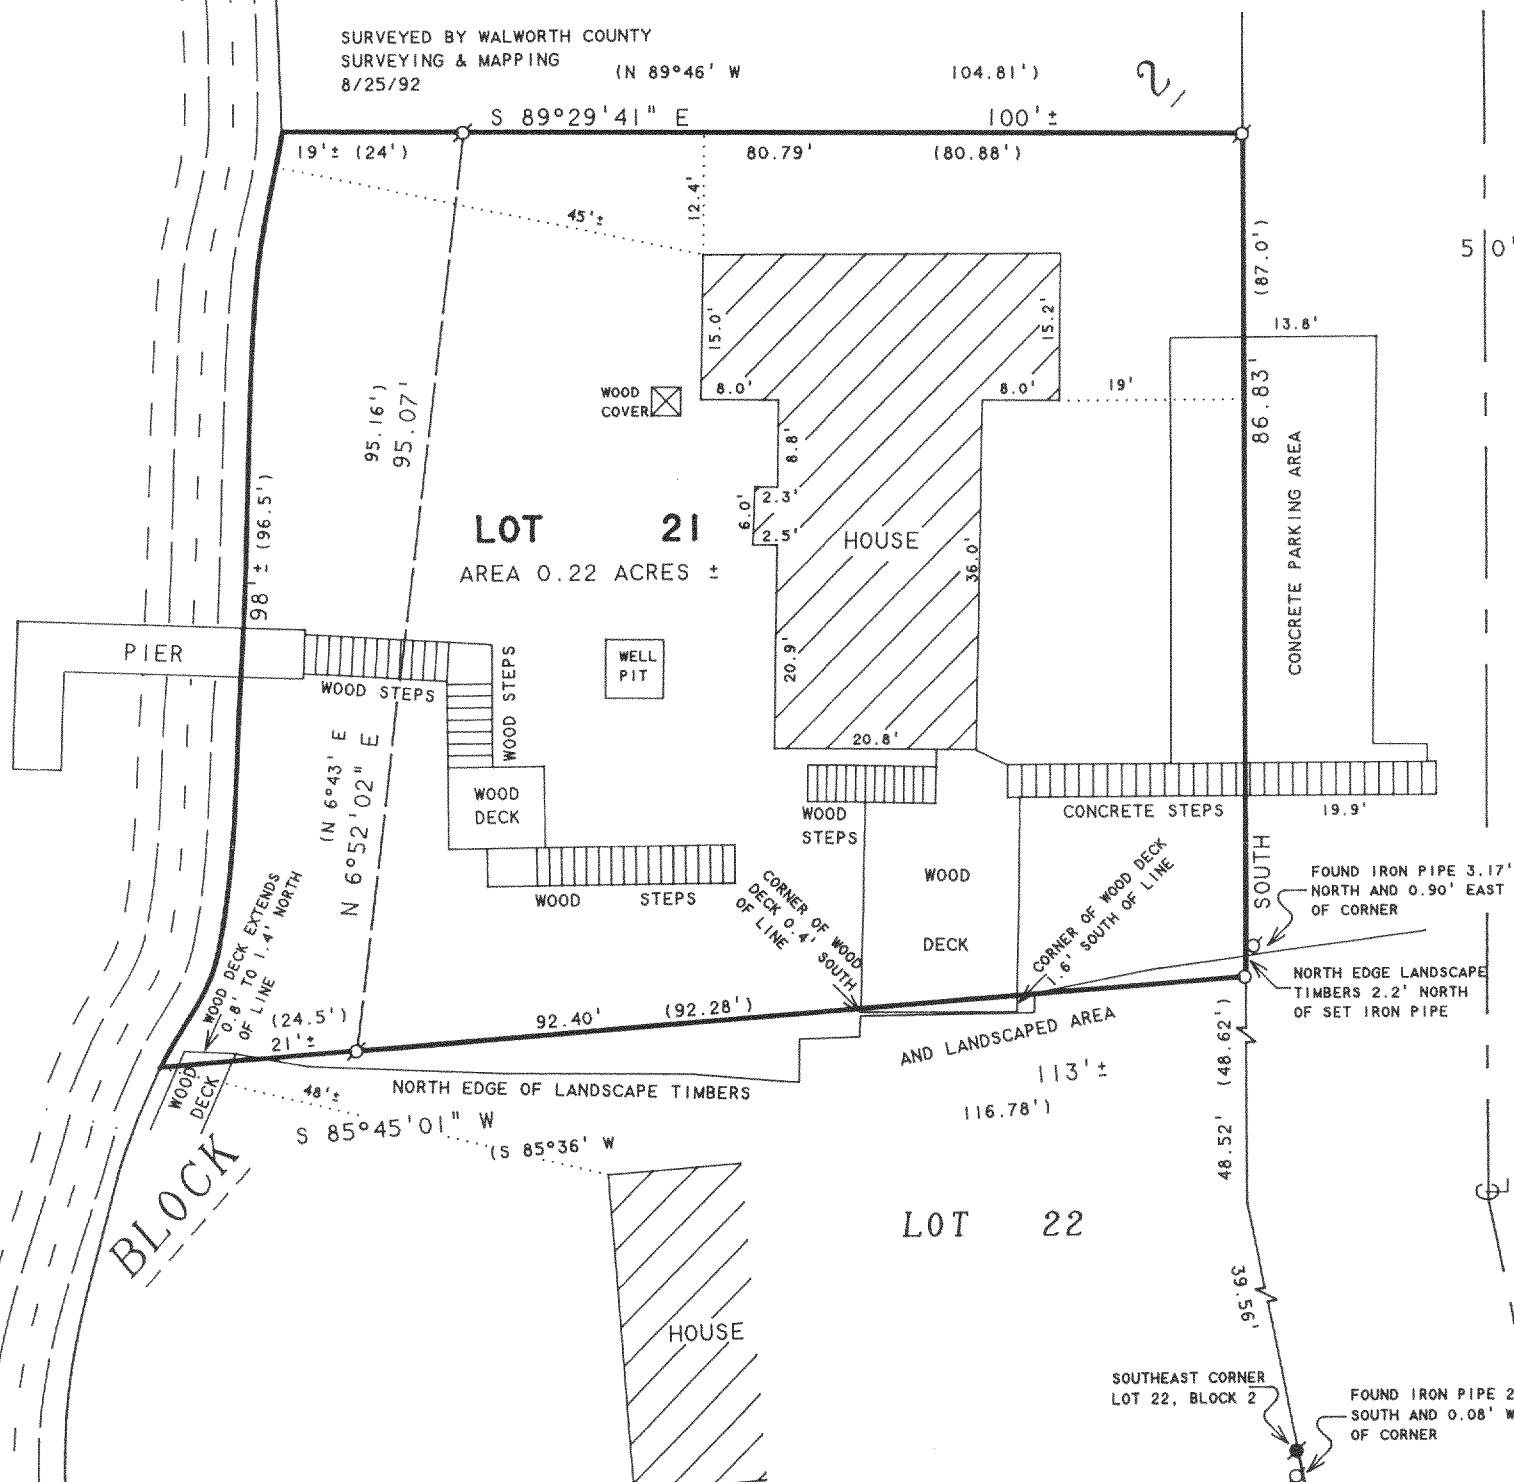

LOT 22

PLAT OF SURVEY OF

LOT 21, BLOCK 2, MORaine HEIGHTS,  
LOCATED ON T4N, R15E, WALWORTH  
COUNTY, WISCONSIN.

REVISED: DECEMBER 30, 1999 TO SHOW DISTANCES  
FROM HOUSES ON LOTS 20 AND 22 TO THE SHORE OF  
WHITEWATER LAKE.

ORDERED BY: JOSHUA ZAVELOVICH  
6521 N. CRAWFORD ST.  
LINCOLNWOOD, IL 60712

I HEREBY CERTIFY THAT I HAVE SURVEYED THE ABOVE DESCRIBED PROPERTY AND THAT THE  
ABOVE MAP IS A TRUE REPRESENTATION THEREOF AND SHOWS THE SIZE AND LOCATION OF  
THE PROPERTY, ITS EXTERIOR BOUNDARIES, THE LOCATION OF ALL VISIBLE STRUCTURES  
AND DIMENSIONS OF ALL PRINCIPAL BUILDINGS THEREON, BOUNDARY FENCES, APPARENT  
EASEMENTS, ROADWAYS AND VISIBLE ENCROACHMENTS, IF ANY, TO THE BEST OF MY  
KNOWLEDGE AND BELIEF.

THIS SURVEY IS MADE FOR THE USE OF THE PRESENT OWNERS OF THE PROPERTY, AND ALSO  
THOSE WHO PURCHASE, MORTGAGE, OR GUARANTEE THE TITLE THERETO WITHIN ONE (1) YEAR  
FROM DATE HEREON.

*David F. Abell*

DAVID F. ABELL  
WISCONSIN REGISTERED LAND SURVEYOR, S-1596

SCALE 1" = 20'

LEGEND

- - IRON PIPE FOUND
- - IRON ROD FOUND
- - IRON PIPE SET
- 1 - RECORDED AS

415-747

DMH-55

September 16, 1999  
DATE: JOB NUMBER - 99155A  
NOTE: THIS IS NOT A CERTIFIED COPY UNLESS SEALED.

