



REGISTERED PROFESSIONAL LAND SURVEYOR
LAKE GENEVA, WISCONSIN

East line of
Section 35-4-15

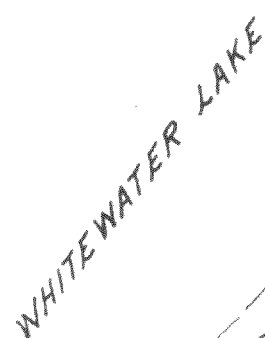

SCALE: 1" = 50'
LEGEND

- Ø - IRON PIPE FOUND
- - IRON PIPE PLACED
- - CONCRETE MONUMENT
- x - Cross in Concrete
- () - Platted Distance

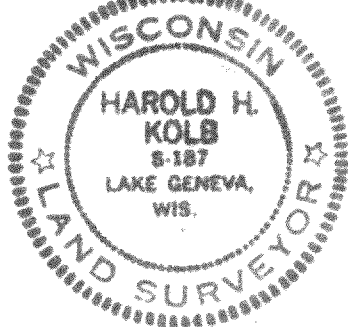

PLAT OF SURVEY OF

Lot 23, Minnieska Subdivision, located in
Section 35, T 4 N, R 15 E, Walworth County,
Wisconsin.

I, HAROLD H. KOLB, DO HEREBY CERTIFY THAT I HAVE SURVEYED THE PROPERTY HEREON DESCRIBED ACCORDING TO THE OFFICIAL RECORDS, AND THAT THE PLAT HEREON IS A CORRECT REPRESENTATION OF THE LOT LINES.

Harold G. Kohn

HAROLD H. KOLB
WISCONSIN REGISTERED LAND SURVEYOR, S-187
DATE June 2, 1970

DM-23

4/15-~~18~~ 75


HAROLD H. KOLB

REGISTERED PROFESSIONAL LAND SURVEYOR
LAKE GENEVA, WISCONSIN

Concrete sea-wall
encroaches 7.1'

WHITEWATER LAKE

East line of
Section 35-4-15

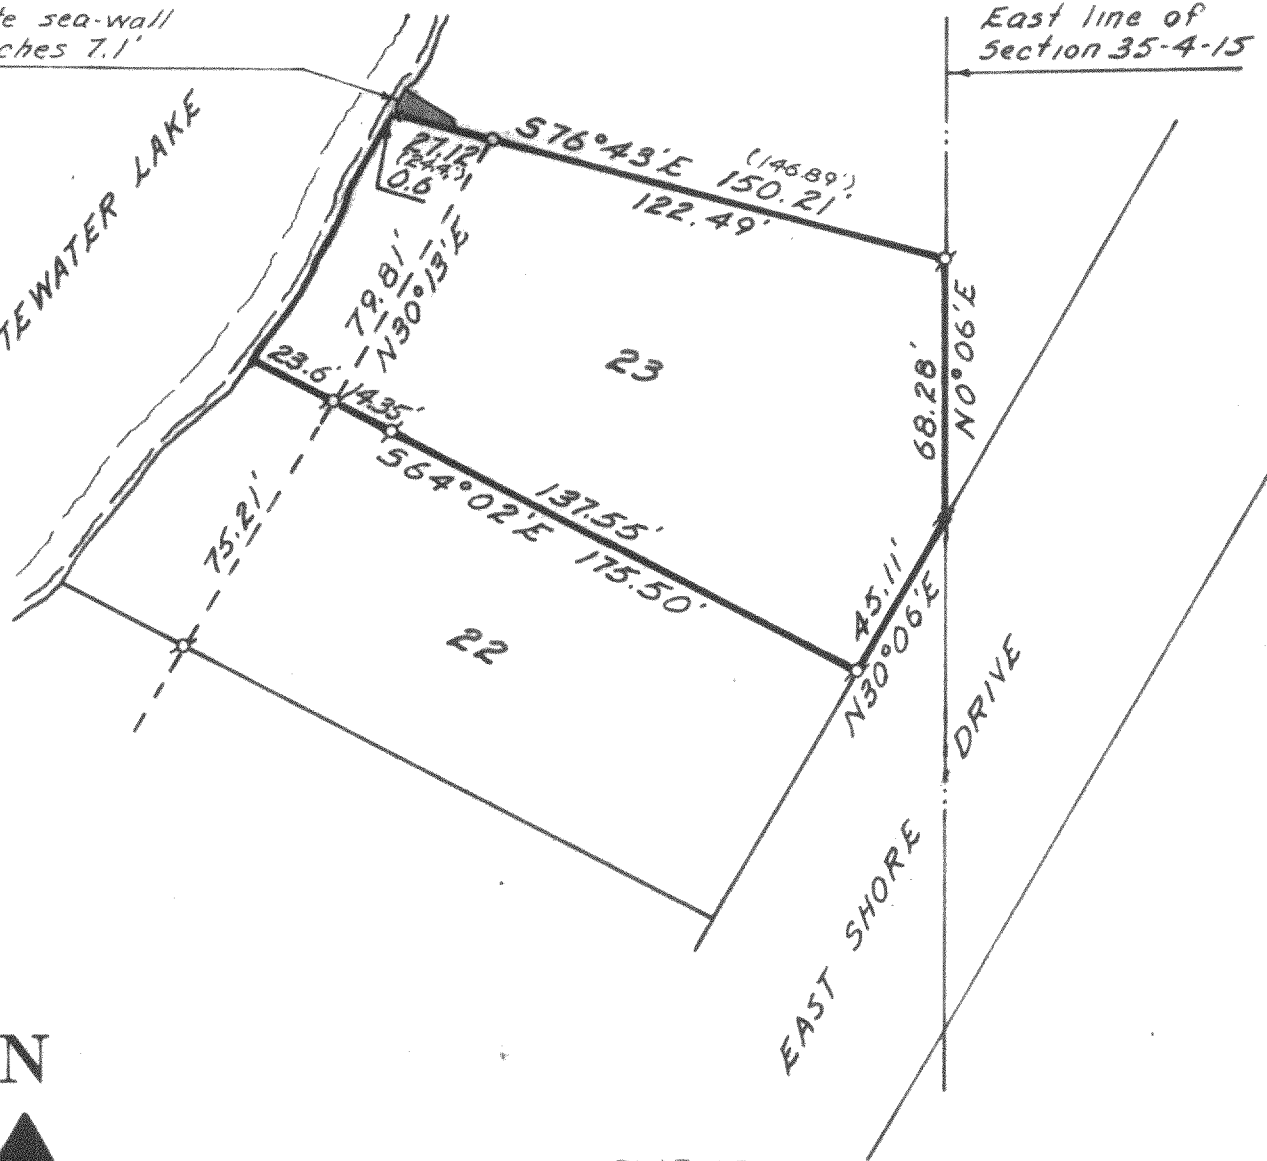


N



SCALE: 1" = 50'
LEGEND

- Ø - IRON PIPE FOUND
- - IRON PIPE PLACED
- - CONCRETE MONUMENT
- x - Cross in Concrete
- () - Platted Distance

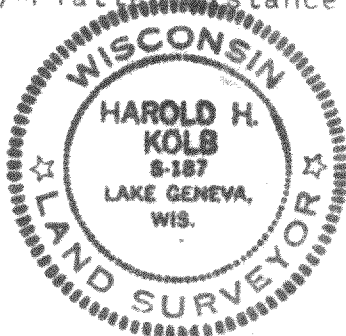

PLAT OF SURVEY OF

Lot 23, Minnieska Subdivision, located in
Section 35, T 4 N, R 15 E, Walworth County,
Wisconsin.

I, HAROLD H. KOLB, DO HEREBY CERTIFY THAT I HAVE
SURVEYED THE PROPERTY HEREON DESCRIBED ACCORDING
TO THE OFFICIAL RECORDS, AND THAT THE PLAT HEREON
IS A CORRECT REPRESENTATION OF THE LOT LINES.

Harold H. Kolb

HAROLD H. KOLB
WISCONSIN REGISTERED LAND SURVEYOR, S-187
DATE June 2, 1970