


PLAT OF SURVEY

LOT 16, BLOCK 1 MORaine HEIGHTS, a Subdivision in the Southwest 1/4 of the Southeast 1/4 of Section 26 and the Southeast 1/4 of the Southwest 1/4 of Section 26, and the Northwest 1/4 of Section 35, and the Northeast 1/4 of Section 35, and the Southwest 1/4 of Section 35, Town 4 North, Range 15 East, Walworth County Wisconsin.

Surveyed for: Ron Sanfillippo

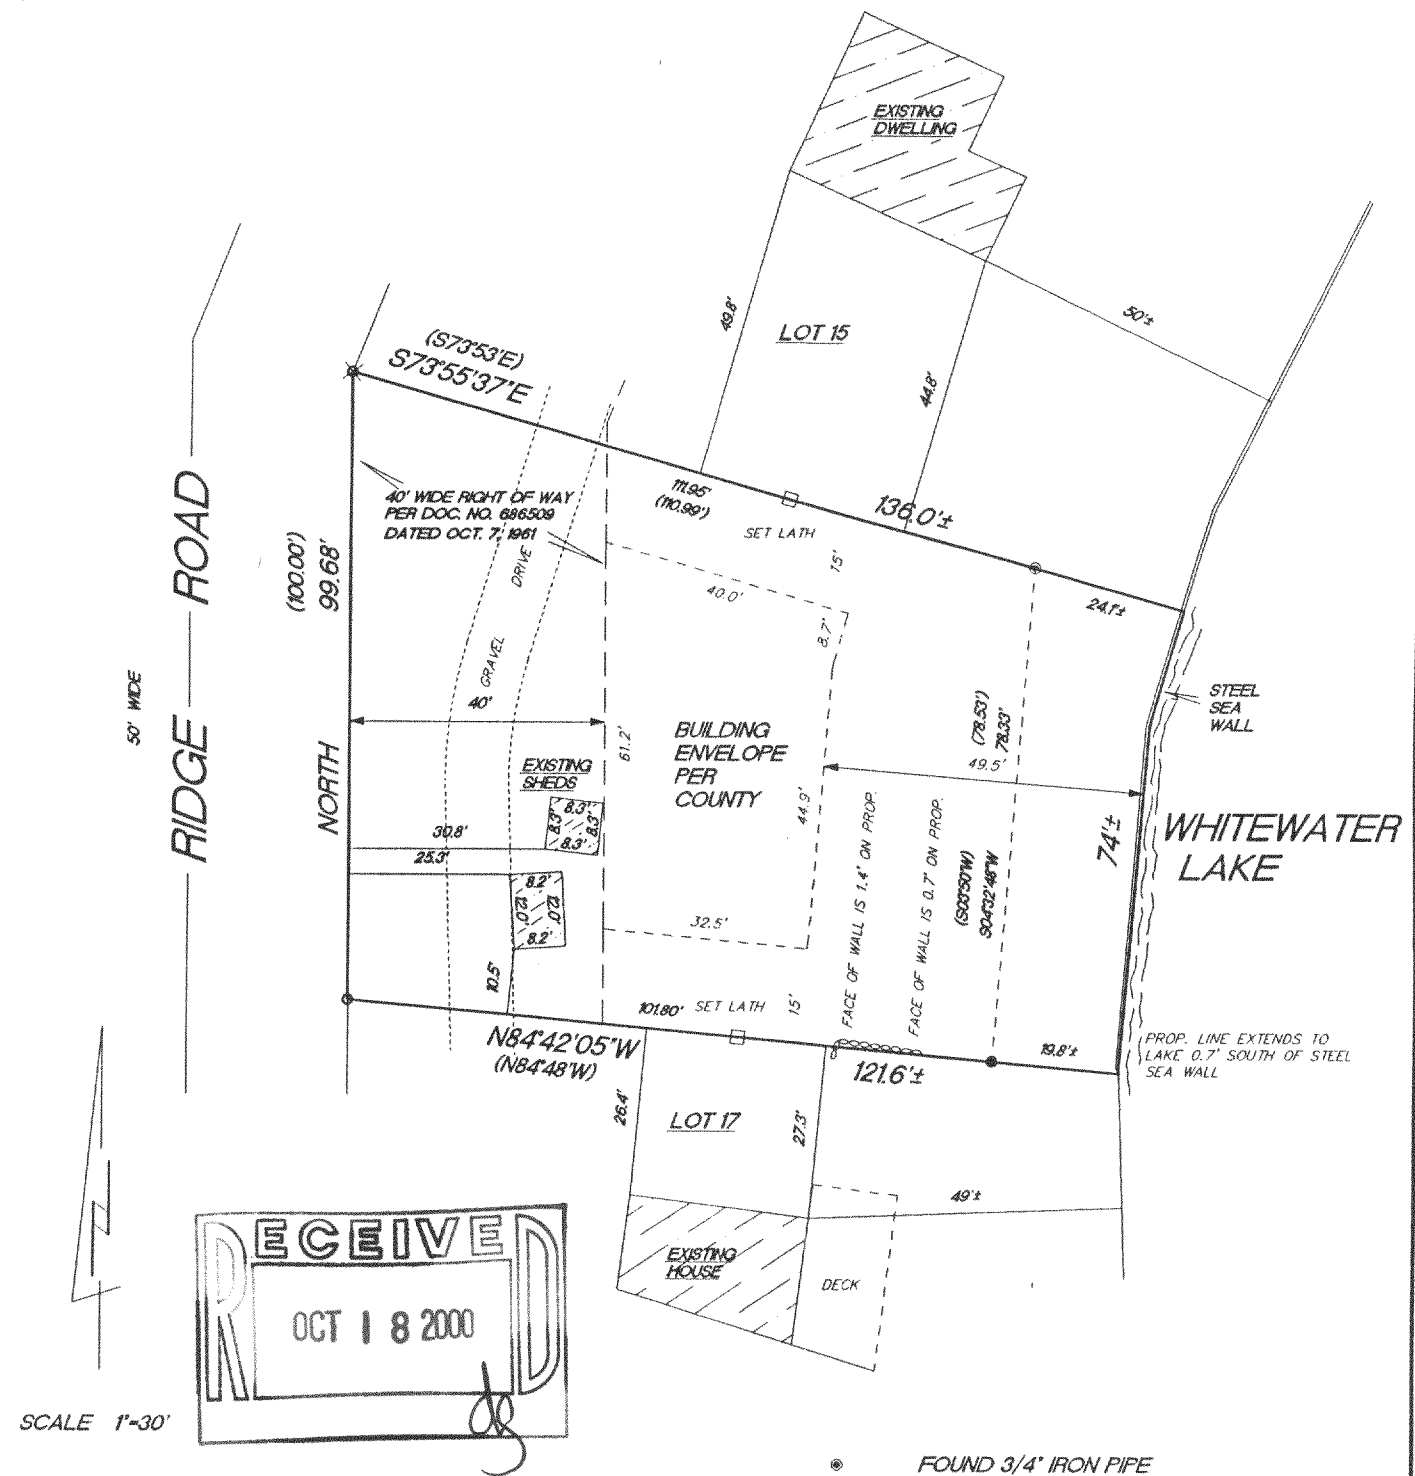

NOTE: MINIMUM BUILDING SETBACKS
PER THE COUNTY FOR THIS LOT
ARE:
25' FRONT (USED 40' DUE TO EXISTING R/W)
15' SIDE
49.5' LAKE (AVERAGE BETWEEN ADJOINING LOTS)

- FOUND 3/4" IRON PIPE
- FOUND 1" IRON PIPE
- ⊗ FOUND 2" IRON PIPE
- SET 1" IRON PIPE
- () RECORDED AS DIMENSIONS

"I hereby certify that I have surveyed the above described property and that the above map is a true representation thereof and shows the size and location of the property, its exterior boundaries, the location of all visible structures and dimension of all principal buildings thereon, boundary fences, apparent easements, roadways and encroachments if any."

"This survey is made for the use of the present owners of the property, and also those who purchase, mortgage or guarantee the title thereto within one year from date hereof."

KETTLE MORaine SURVEYING
W356 S9050 Godfrey Lane
Eagle Wisconsin 53119
P.O. Box 357
(262) 594-3484
Terrance E. Pisarek R.L.S.

THIS IS NOT AN ORIGINAL SURVEY UNLESS THE SEAL IS RED.

9/26/00	TEP/DW	TEP	00262
DATE	FIELD WORK BY	DRAWN BY	JOB NUMBER

DMH-16 415-775