


ABELL  
SURVEYING & MAPPING

1140 SEQUOIA STREET • DELAVAN, WISCONSIN 53115  
262-728-6737

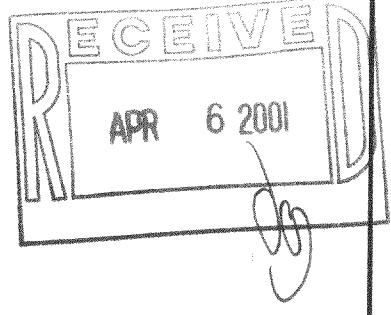

N  
↑


SCALE 1"=30'

LEGEND

- - IRON PIPE FOUND
- \* - WOOD FENCE
- XX - CHAINLINK FENCE
- ▲ - LAMP POST
- ( ) - RECORDED AS

PLAT OF SURVEY OF

LOT 9, BLOCK 4, GRAND VIEW SUBDIVISION,  
LOCATED IN T4N, R15E, WALWORTH COUNTY,  
WISCONSIN.

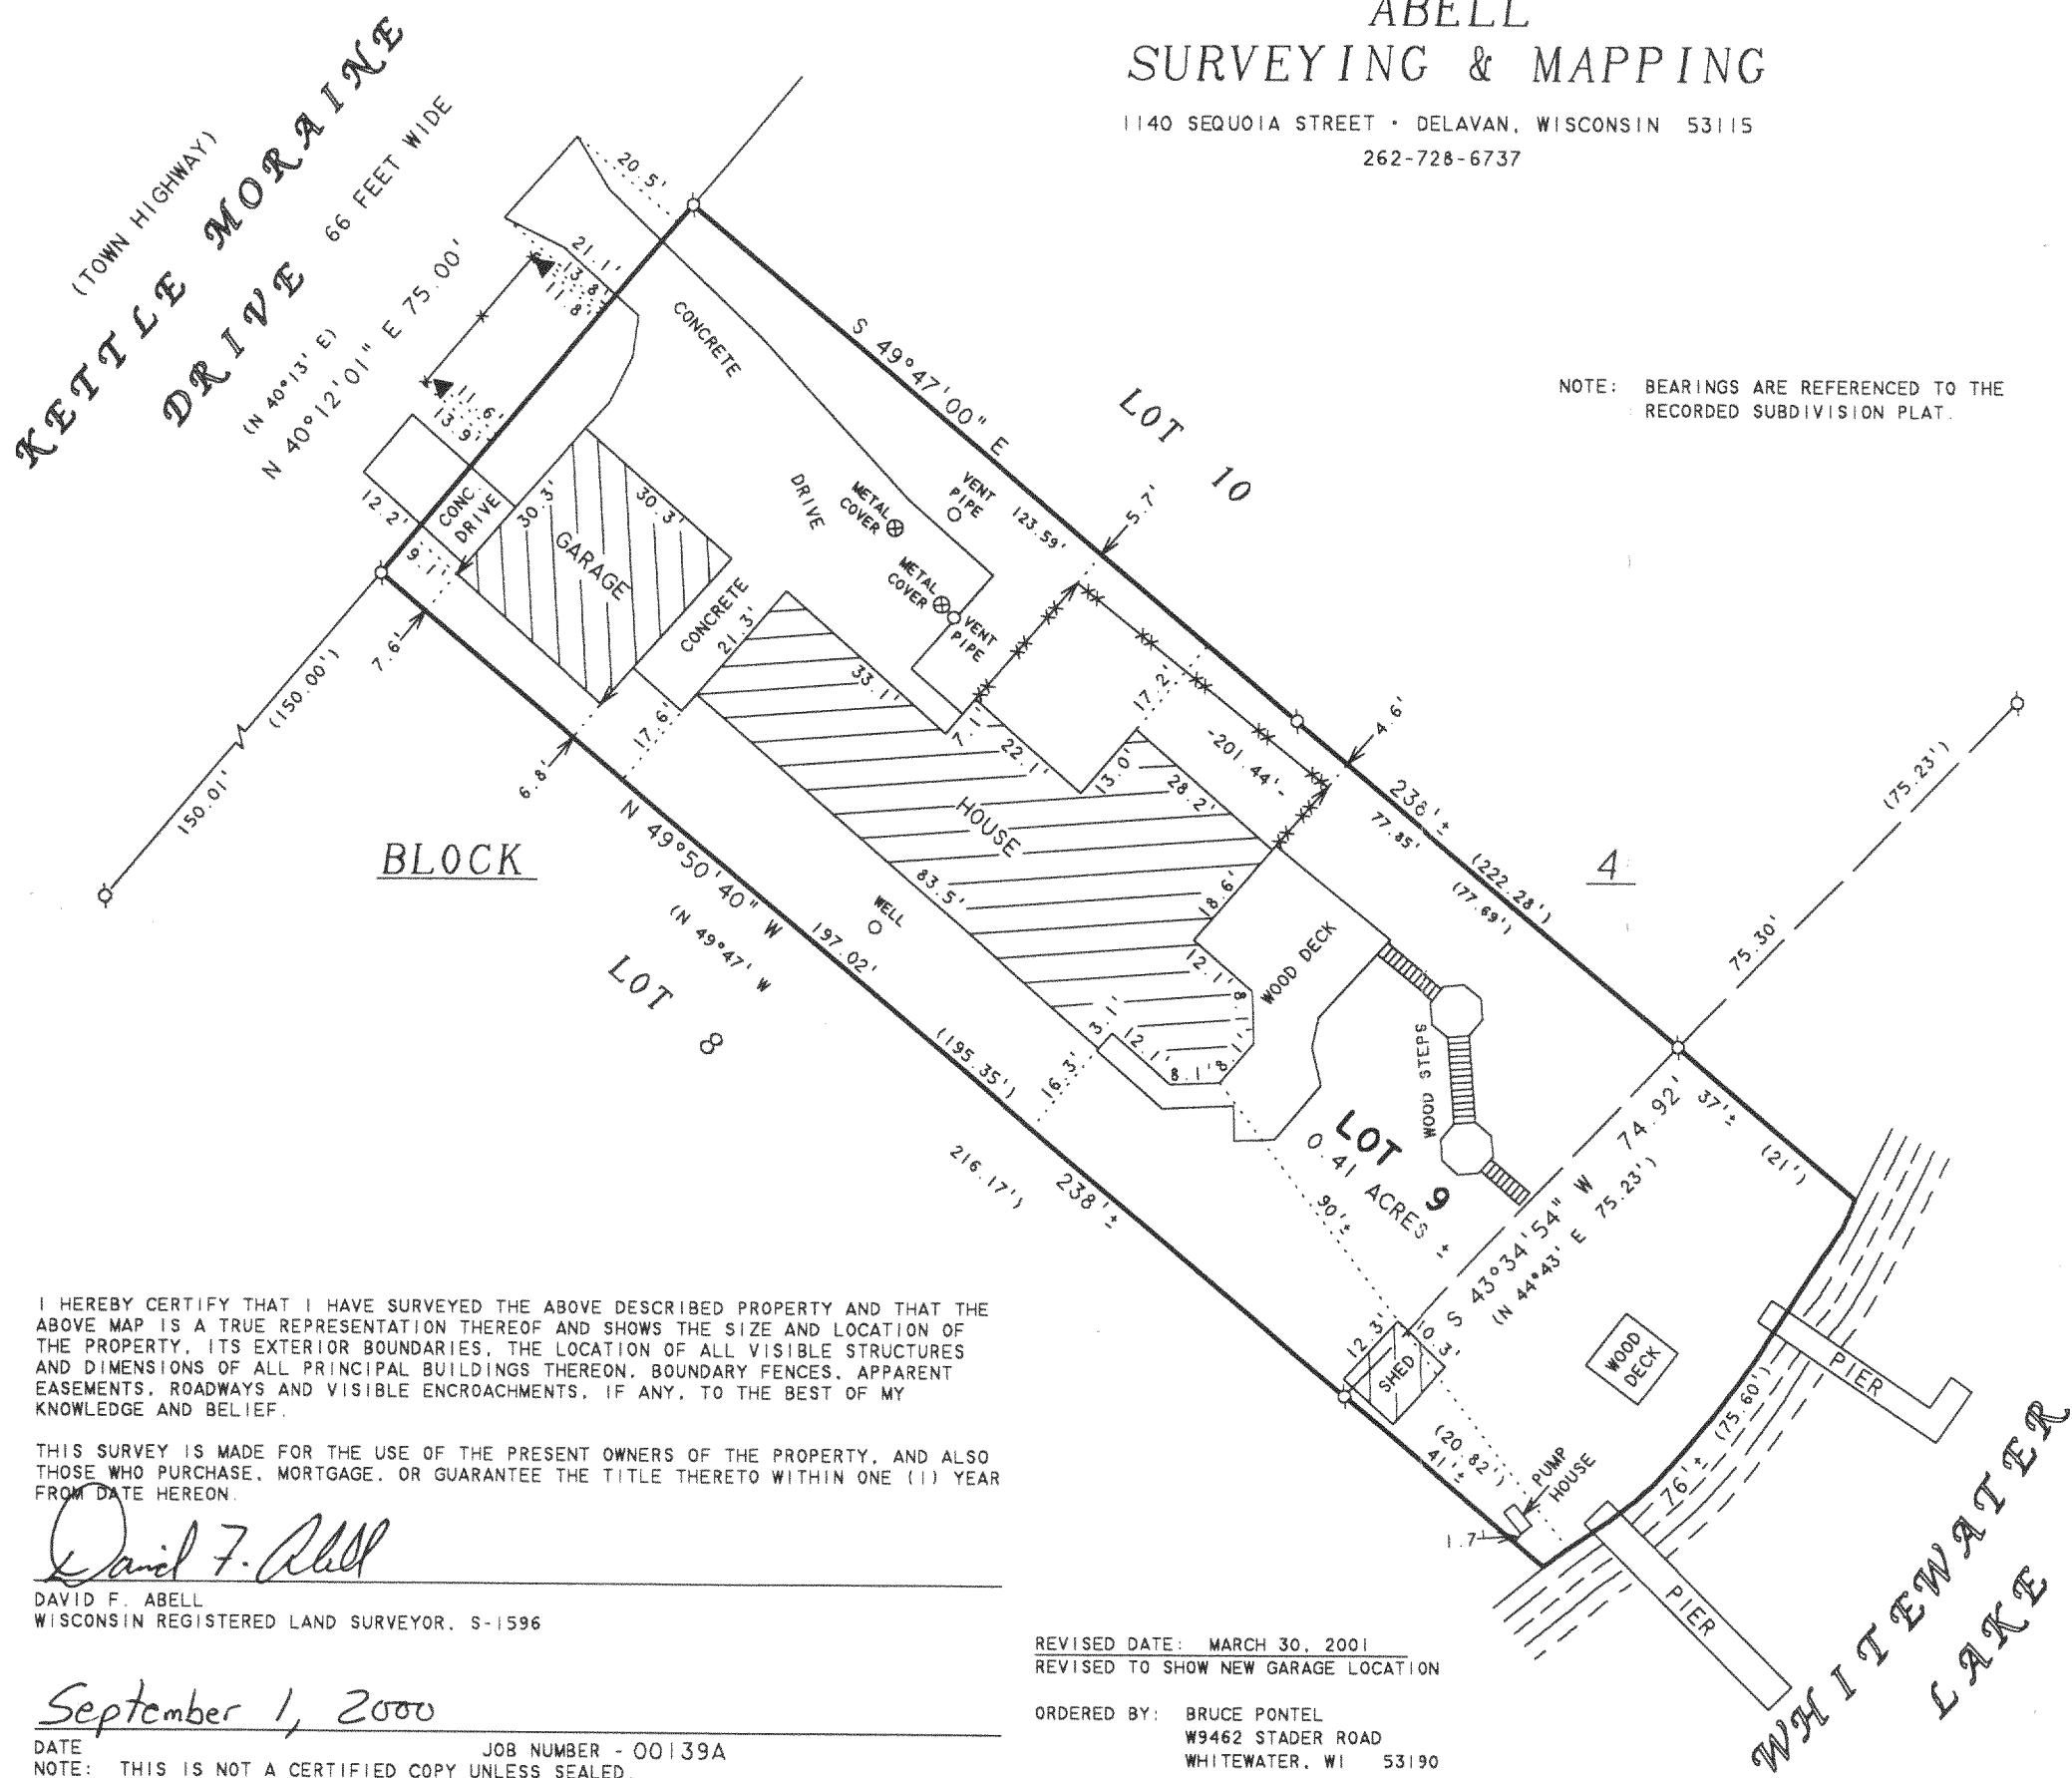

DGD-57

415-796