


ABELL
SURVEYING & MAPPING

1140 SEQUOIA STREET • DELAVAN, WISCONSIN 53115
262-728-6737




N

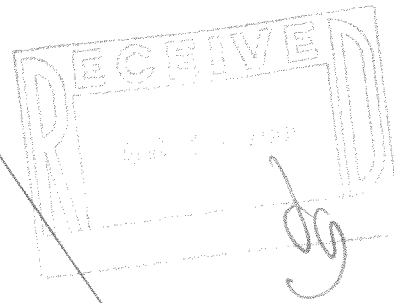

SCALE 1"=50'

LEGEND

● - 3/4" DIA. IRON ROD FOUND
X - WIRE FENCE

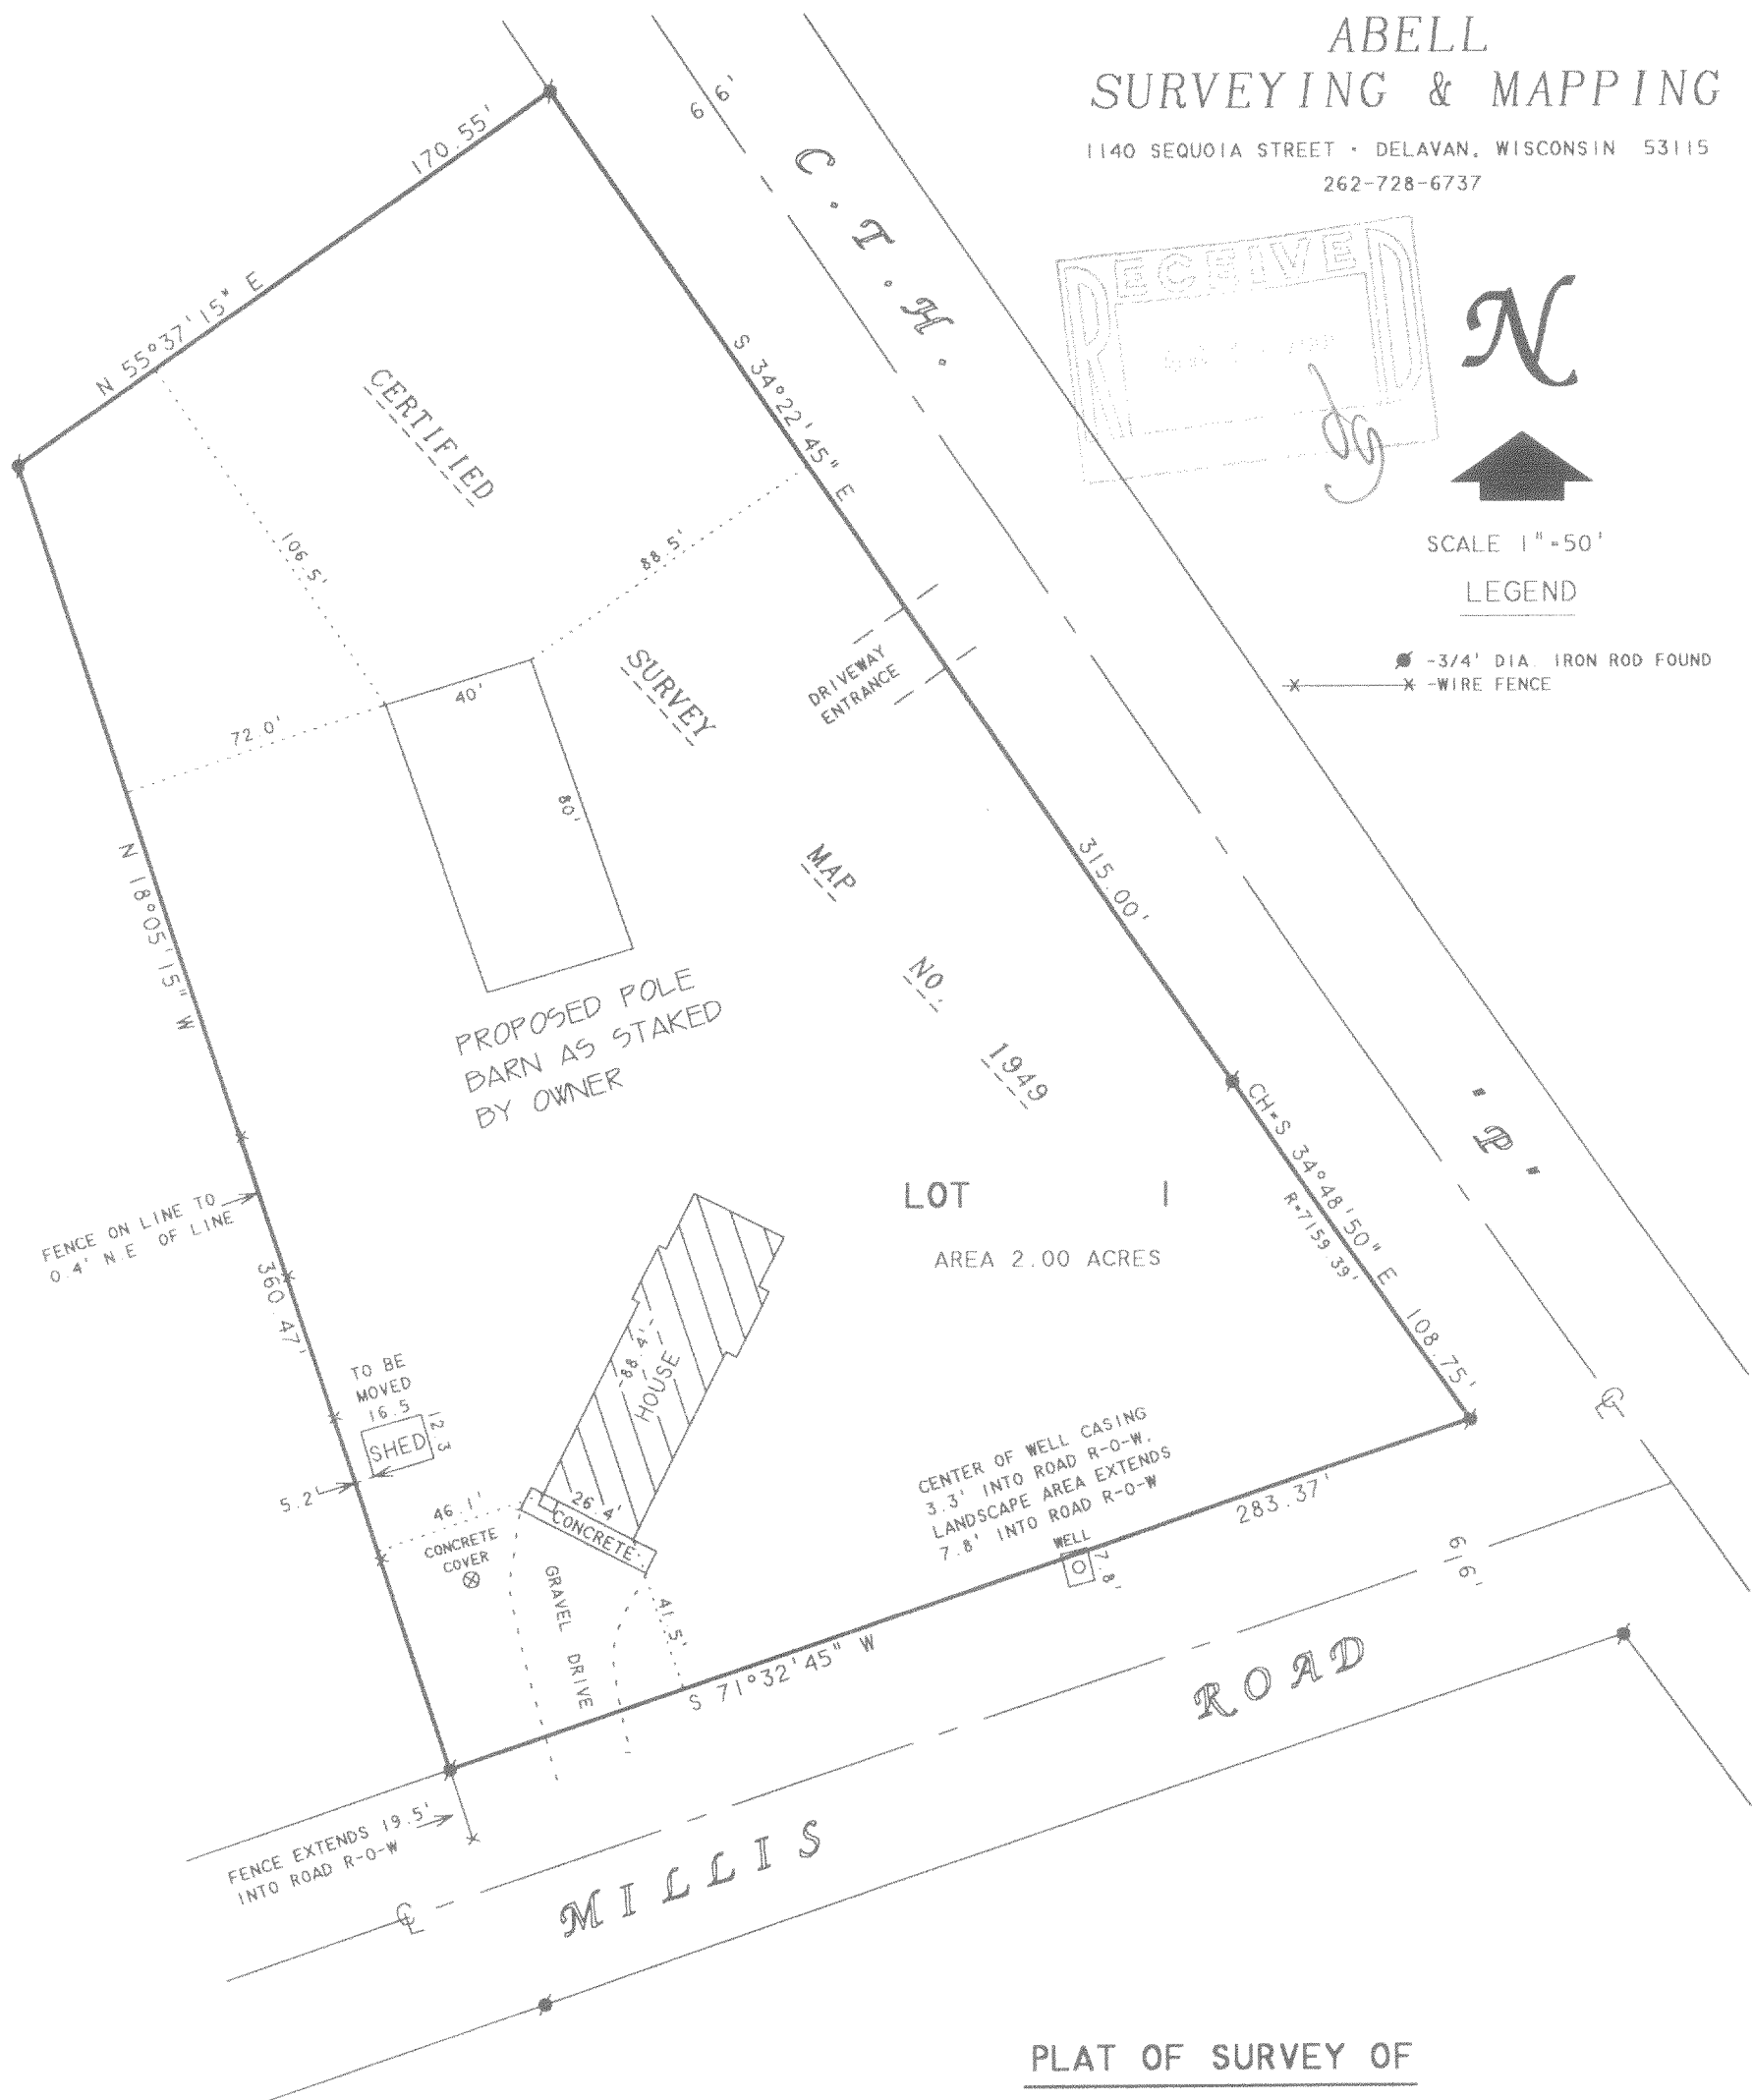

PLAT OF SURVEY OF

LOT 1, CERTIFIED SURVEY MAP NO. 1949, LOCATED IN THE
SE 1/4 OF THE NW 1/4, THE SW 1/4 OF THE NW 1/4, THE
NW 1/4 OF THE SW 1/4 AND THE NE 1/4 OF THE SW 1/4 OF
SECTION 14, T4N, R15E, WALWORTH COUNTY, WISCONSIN.

NOTE: BEARINGS ARE REFERENCED TO
CERTIFIED SURVEY MAP NO. 1949.

ORDERED BY: BRADLEY GALLAGHER
W7996 MILLIS ROAD
WHITEWATER, WI 53190

I, DAVID F. ABELL, DO HEREBY CERTIFY THAT I HAVE SURVEYED THE PROPERTY HEREON
DESCRIBED ACCORDING TO THE OFFICIAL RECORDS AND THAT THE PLAT HEREON IS A
CORRECT REPRESENTATION OF THE PROPERTY LINES TO THE BEST OF MY KNOWLEDGE AND
BELIEF.

David F. Abell

DAVID F. ABELL
WISCONSIN REGISTERED LAND SURVEYOR, S-1596

June 12, 2001

DATE: June 12, 2001 JOB NUMBER - 90051A
NOTE: THIS IS NOT A CERTIFIED COPY UNLESS SEALED.

DA-1949-1
415-811